EXCAVATION AND REMOVAL OF EXISTING CEMENT CONCRETE PAVEMENT
701+97 - 710+00 ℄ ✓

CONSTRUCT DRIVES
702+30 Lt 12'x4'
702+30 Rt 30'x12'
703+50 Lt ✓
705+30 Lt 12'x4'
707+35 Lt ✓

NOTE: Boundary Markers - The design shown on this sheet supercedes the one shown on "Construction Details" Sheet.

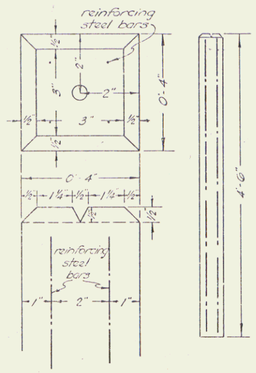

BOUNDARY MARKER
ITEM 567

To be constructed of concrete class 'B' mod. Item 401:B

4 reinforcing steel bars are 5/8" deformed bars 4'-4" long.

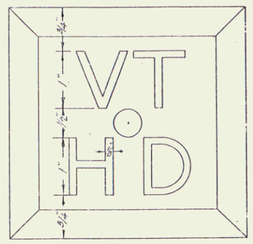

Full size detail of letters
Letters to be V-sunk 1/8"

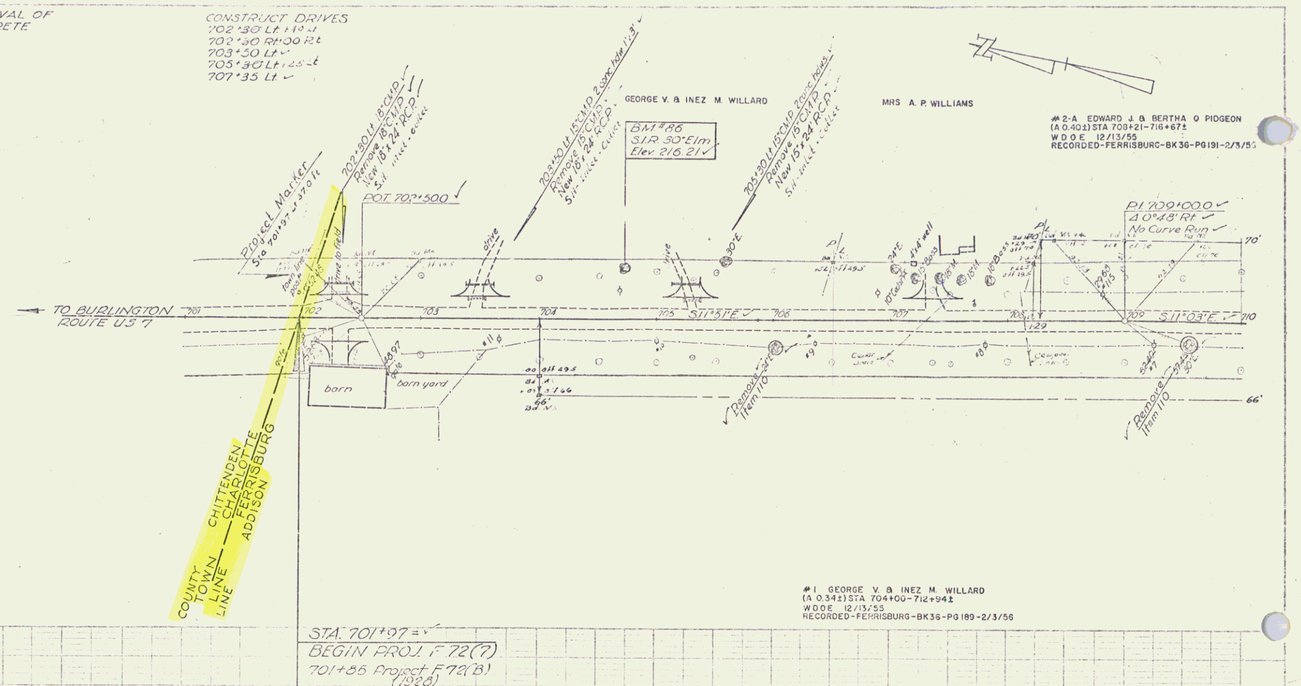

FERRISBURG
Proj F No. 72(7)
Sheet 9 of 81

2