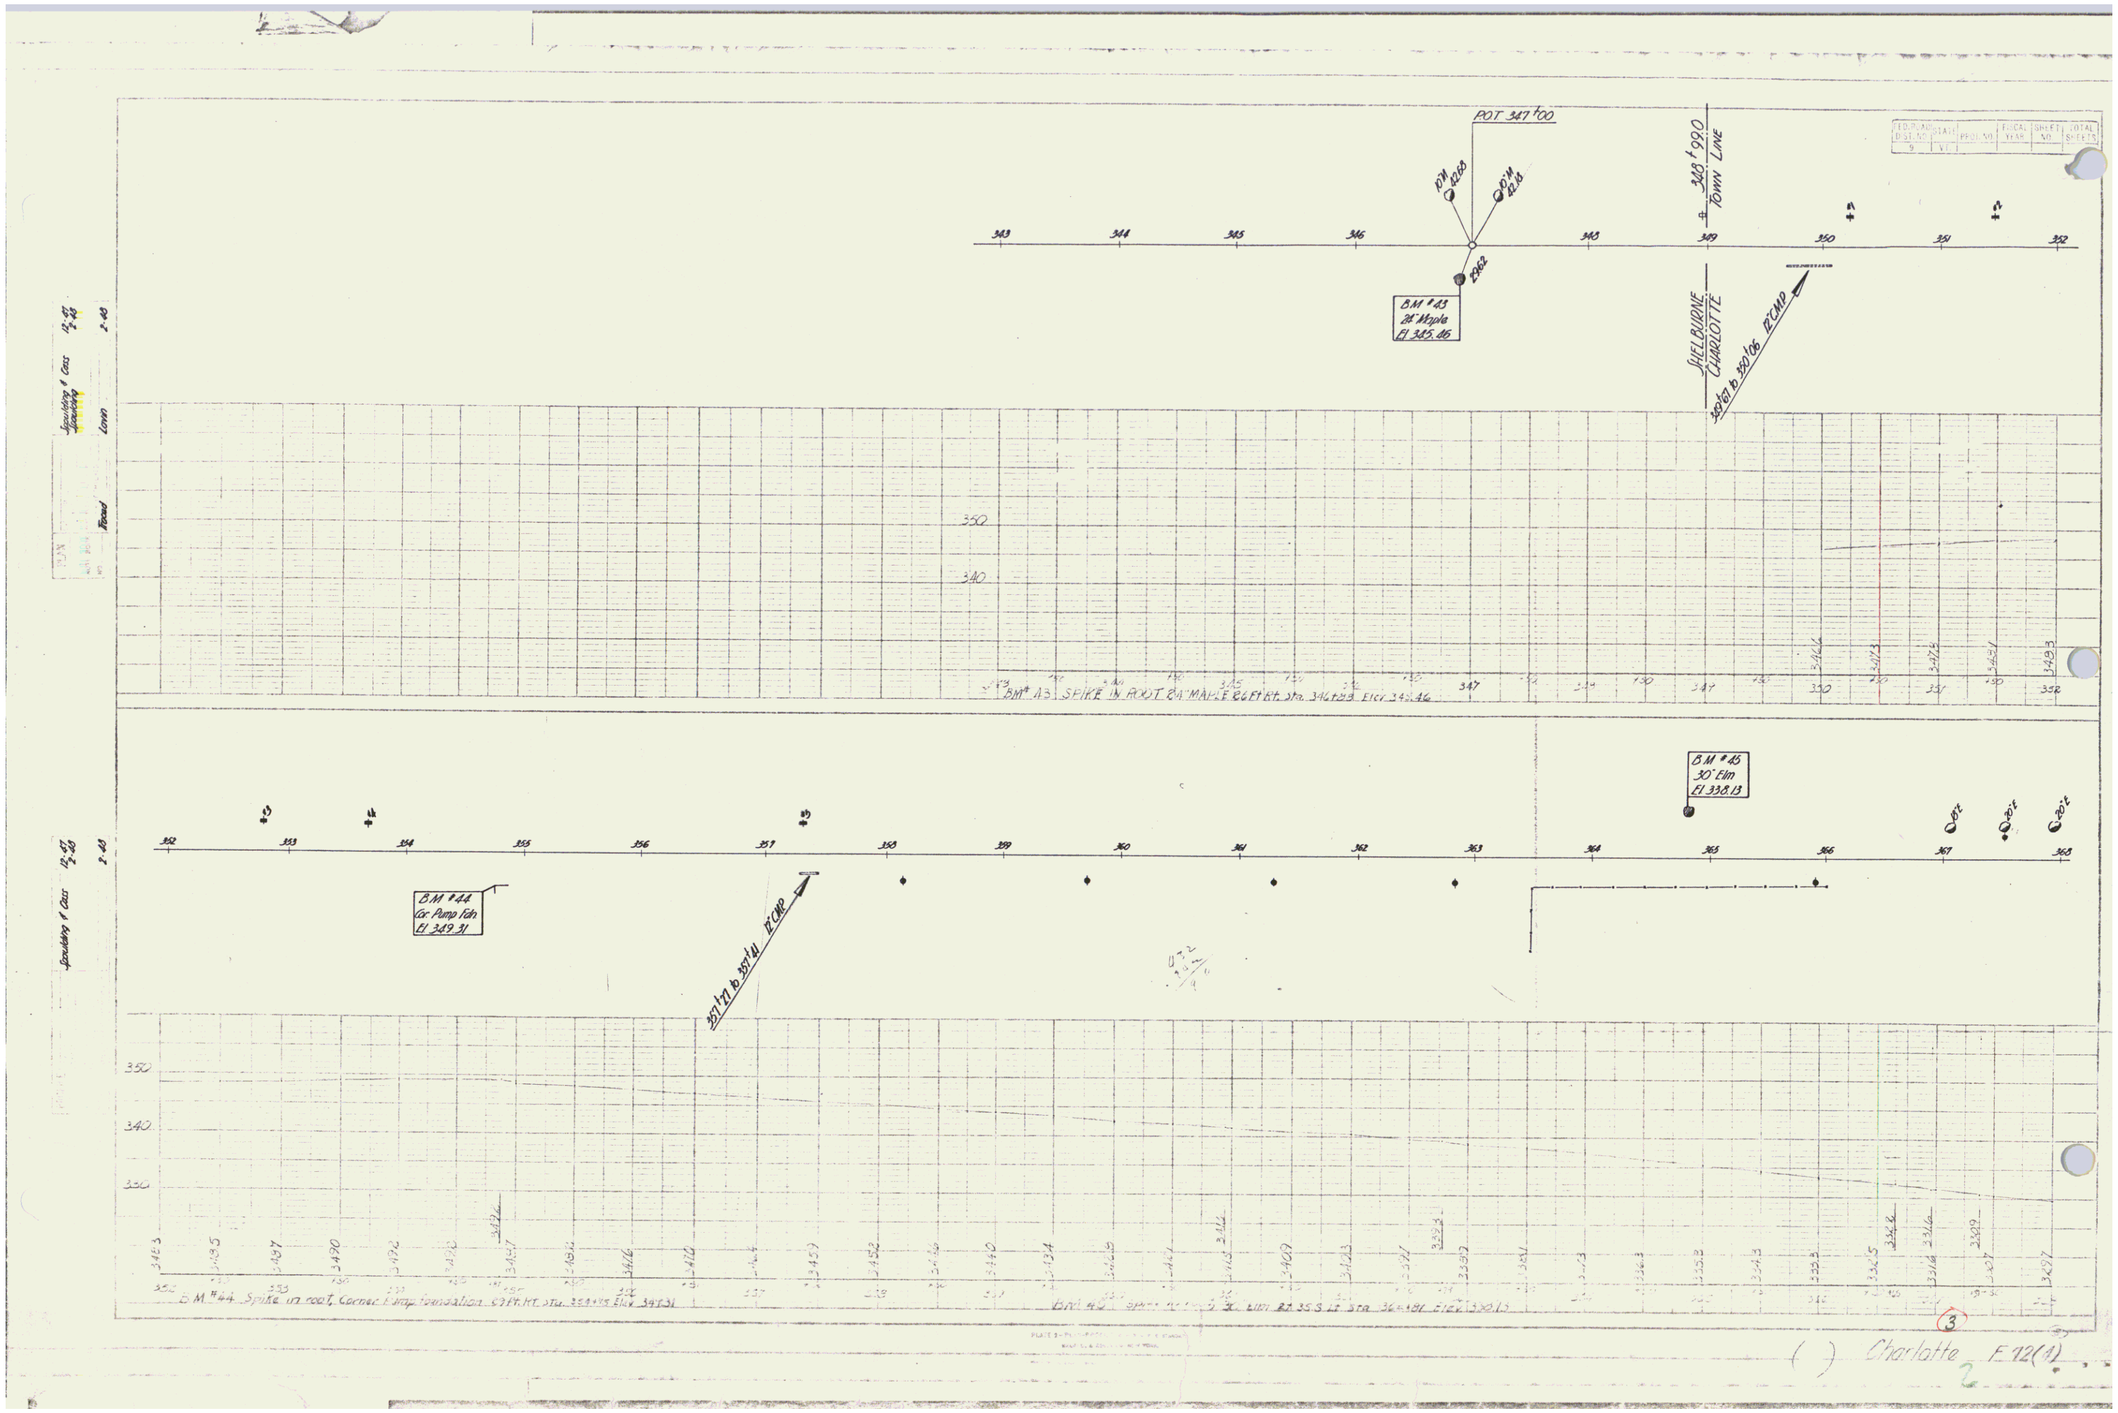

( ) Charlotte E 12(1)

3

2