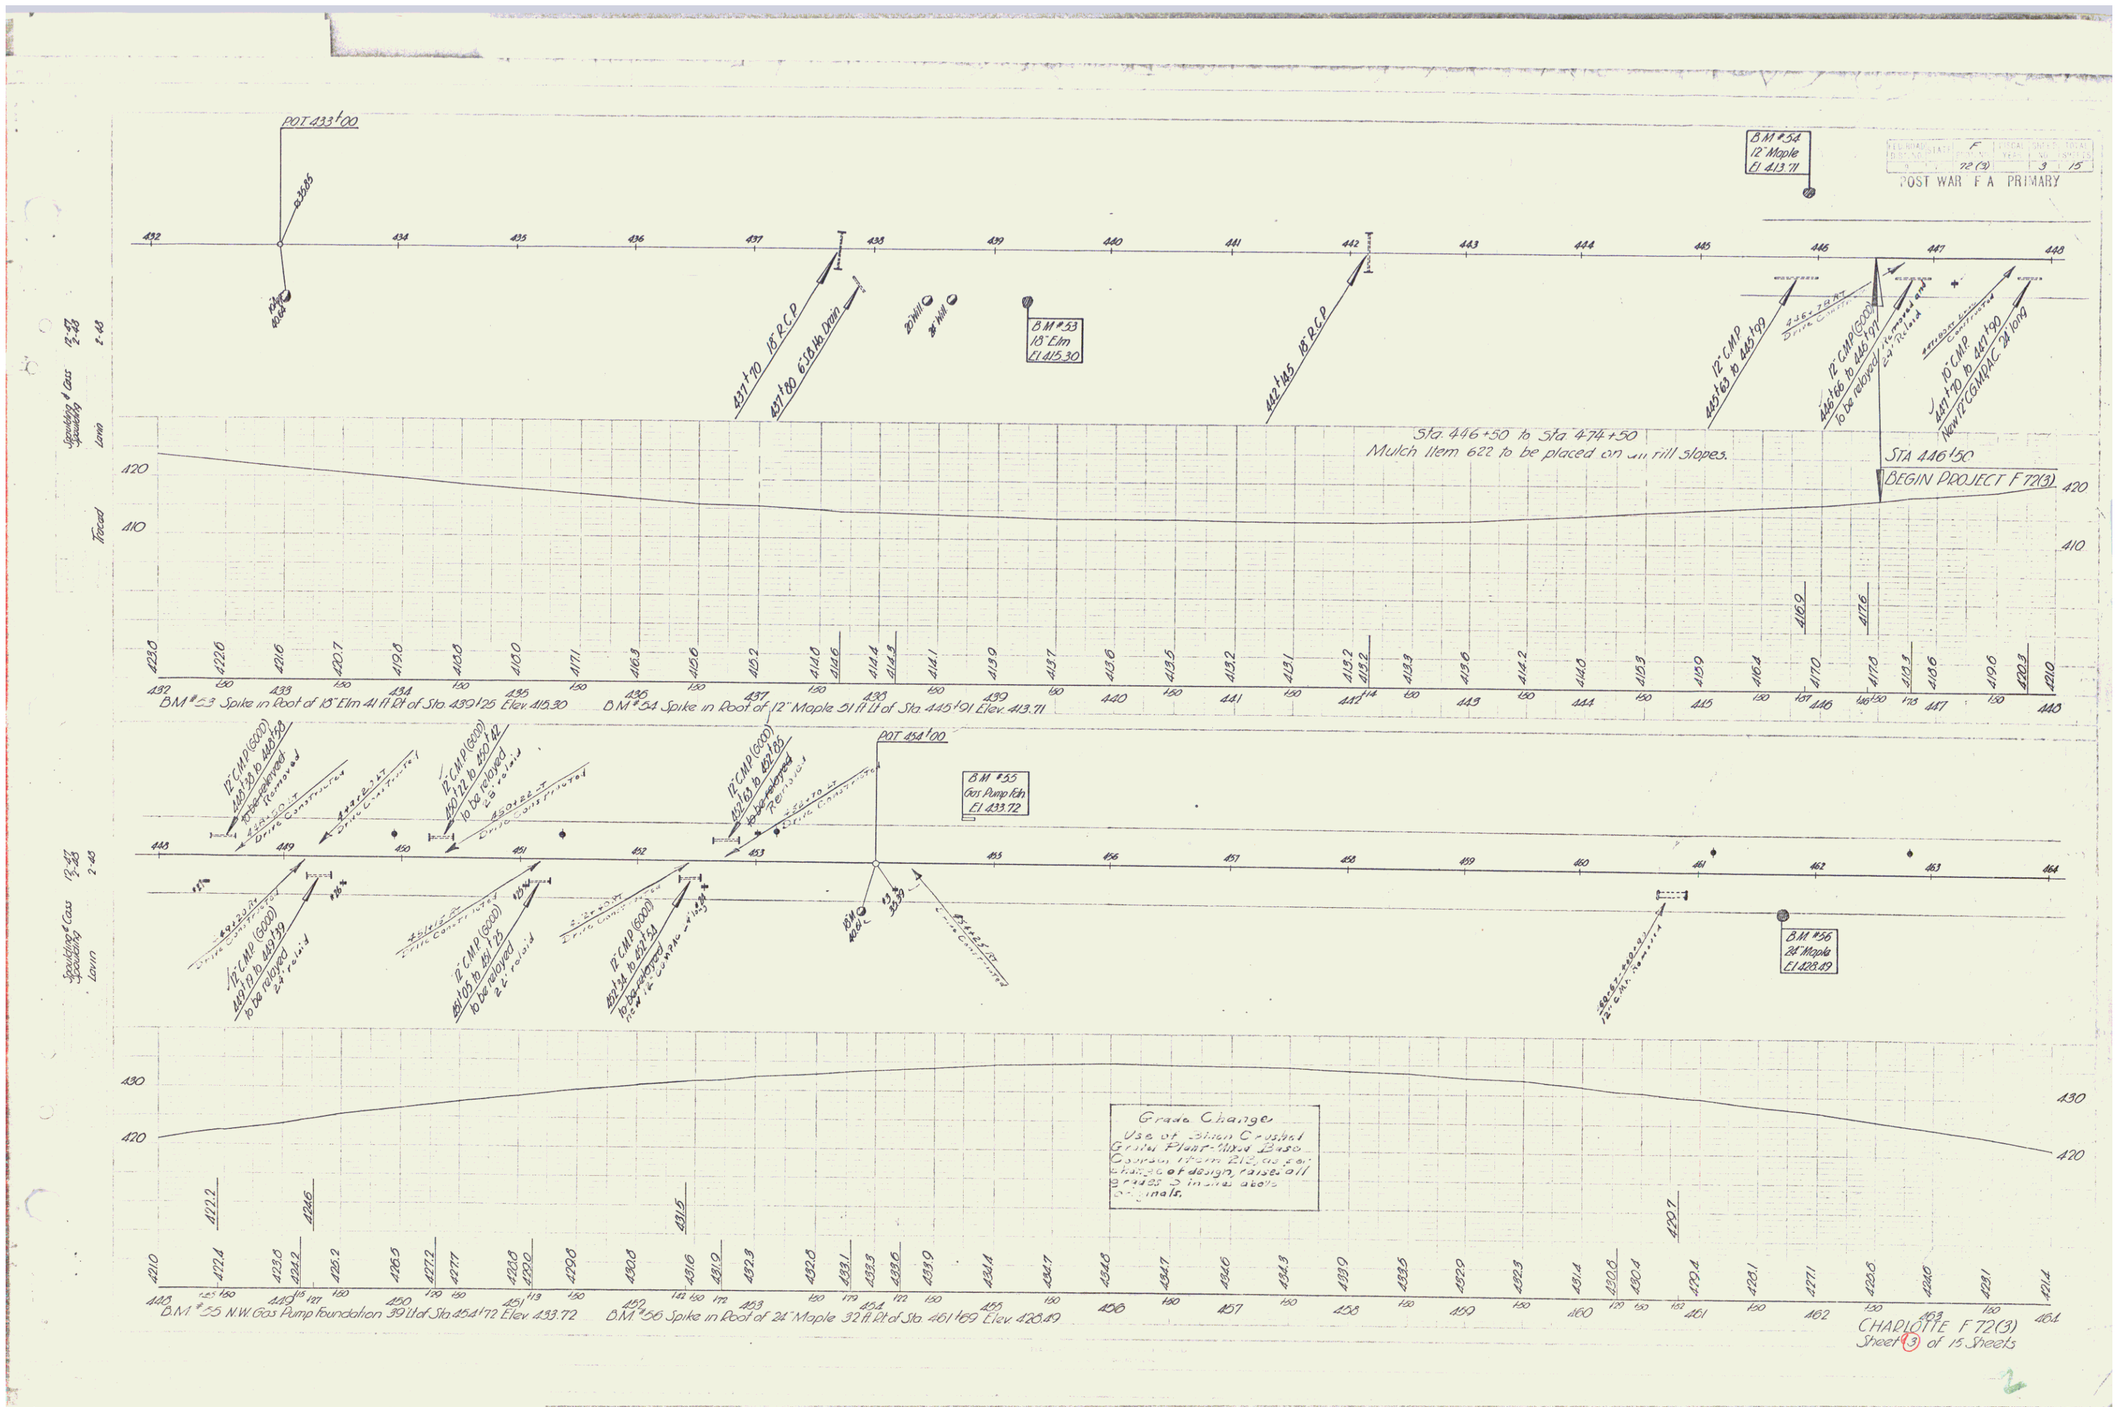
POST WAR F A PRIMARY
F
72 (3)
3
15'
POT 433+00
BM #54
12" Maple
El 413.71
437+10 18" R.C.P.
437+80 6'x8'x6' Drain
BM #53
18" Elm
El 415.30
442+45 18" R.C.P.
12" CMP
445+63 to 446+09
12" CMP (600)
446+68 to 446+91
to be removed
24" Paved
10" CMP
447+90 to 447+90
New 12" CGMPAC 24' long
Sta. 446+50 to Sta. 474+50
Mulch Item 622 to be placed on all fill slopes.
STA 446+50
BEGIN PROJECT F 72(3)
BM #53 Spike in Root of 18" Elm 41 ft Rt of Sta 439+25 Elev. 415.30
BM #54 Spike in Root of 12" Maple 51 ft Lt of Sta 445+91 Elev. 413.71
12" CMP (600)
449+58 to 449+99
to be removed
24" Paved
12" CMP (600)
450+72 to 450+42
to be removed
24" Paved
12" CMP (600)
452+63 to 452+30
to be removed
24" Paved
POT 454+00
BM #55
Gas Pump Fdn
El 433.72
12" CMP
449+79 to 449+39
to be removed
24" Paved
12" CMP (600)
451+63 to 451+78
to be removed
24" Paved
12" CMP
453+34 to 453+54
to be removed
24" Paved
BM #56
24" Maple
El 428.49
Grade Change
Use of Shell Crushed
Granite Plant-Mixed Base
Course from 215 to 6.0 in.
Change of design raises all
grades 5 inches above
original.
BM #55 N.W. Gas Pump Foundation 39 Lt of Sta 454+72 Elev. 433.72
BM #56 Spike in Root of 24" Maple 32 ft Rt of Sta 461+69 Elev. 428.49
CHARLOTTE F 72(3)
Sheet 3 of 15 Sheets