NRM
620 1933 5 36

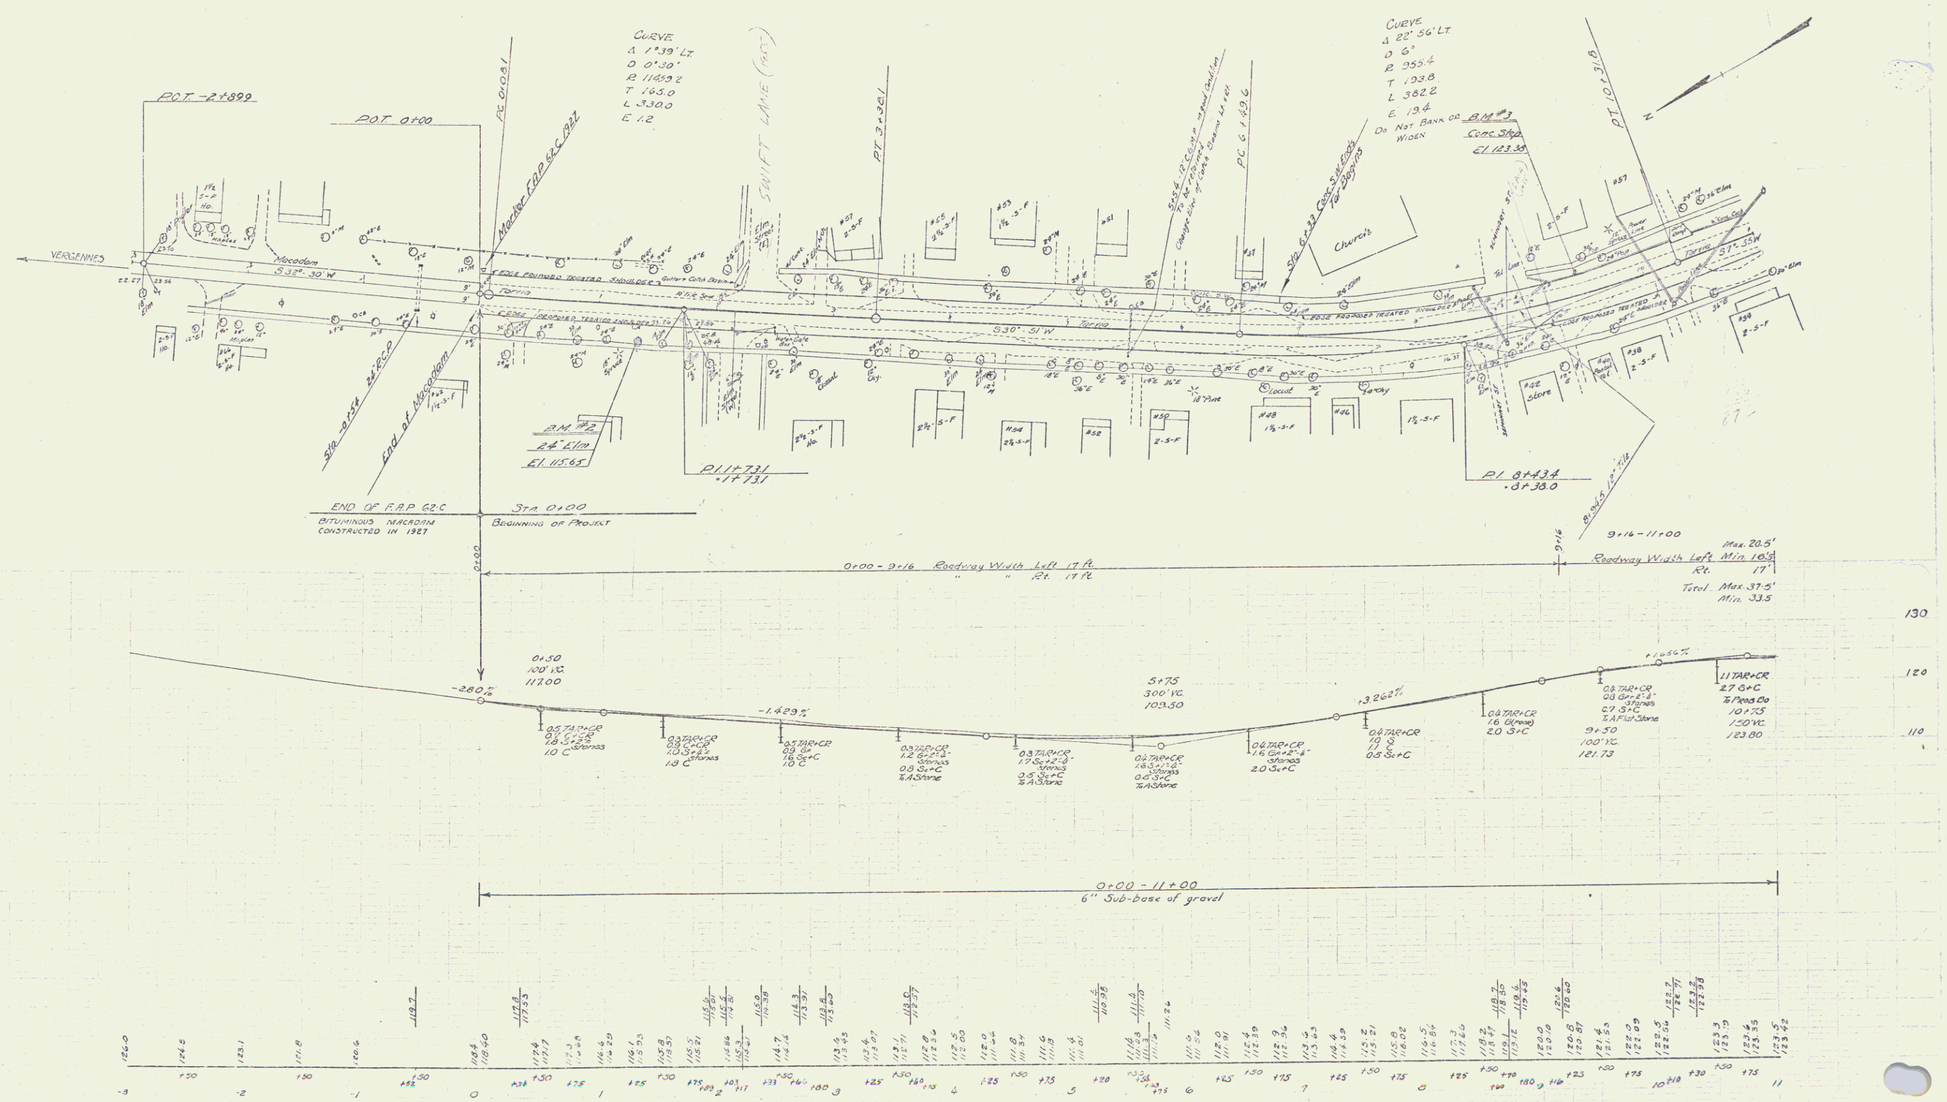

B.M. #2 SPIKE IN ROOT OF 24" ELM 28 FT. RIGHT OF STA. 11+35 ELEV. 115.65
B.M. #3 SPOT ON CONCRETE STEP 24 FT. LEFT OF STA. 9+93 ELEV. 123.33

SERIES NRM NO. 620
SHEET 5 OF 36

20