New Haven
Overpass
2-B-3

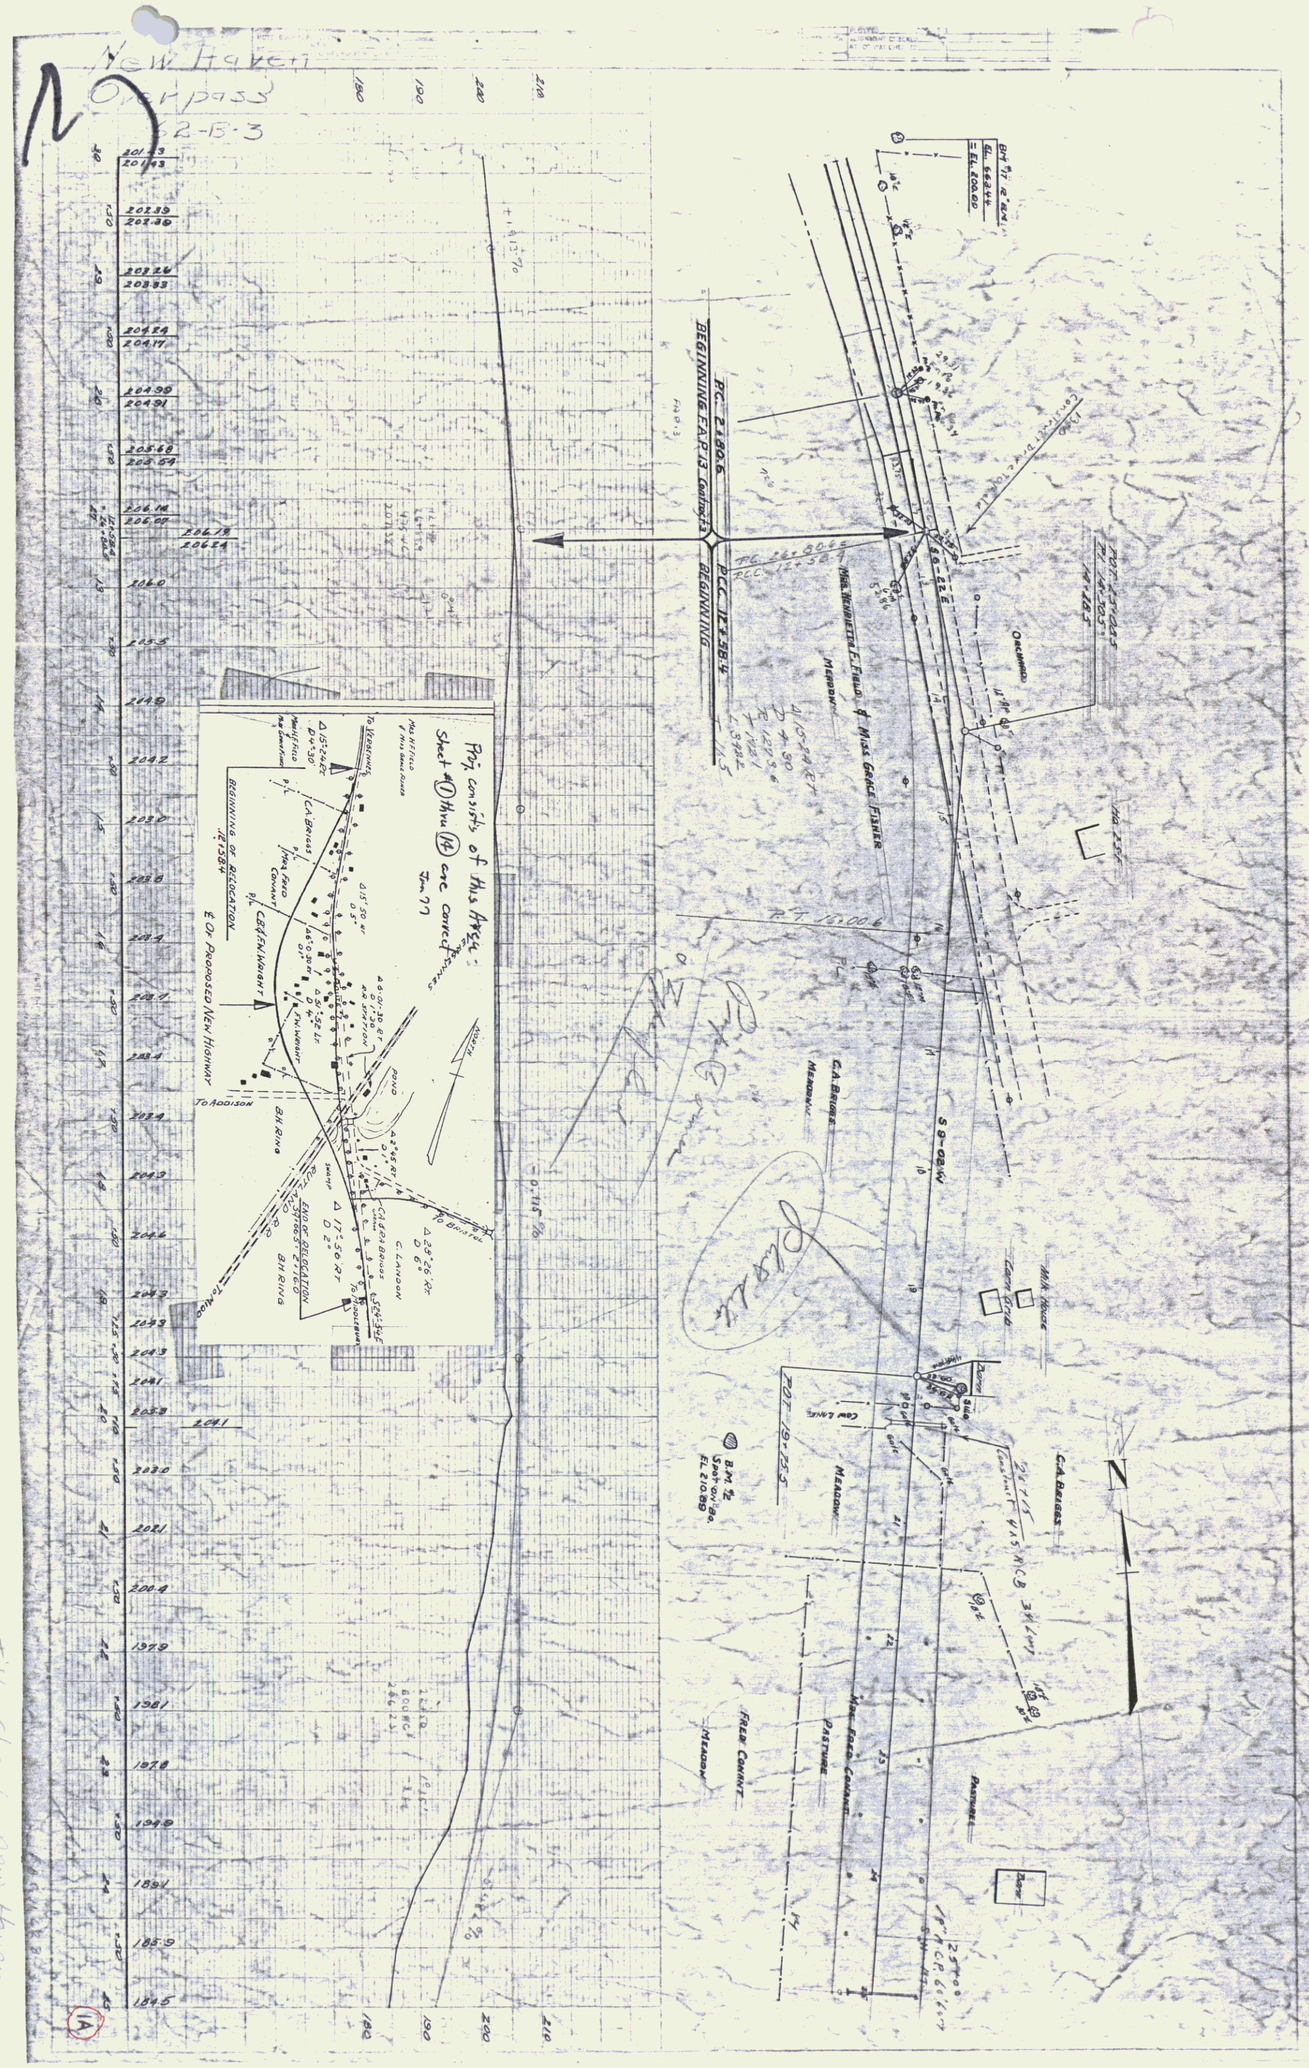

Title Sheet New Haven
63 2