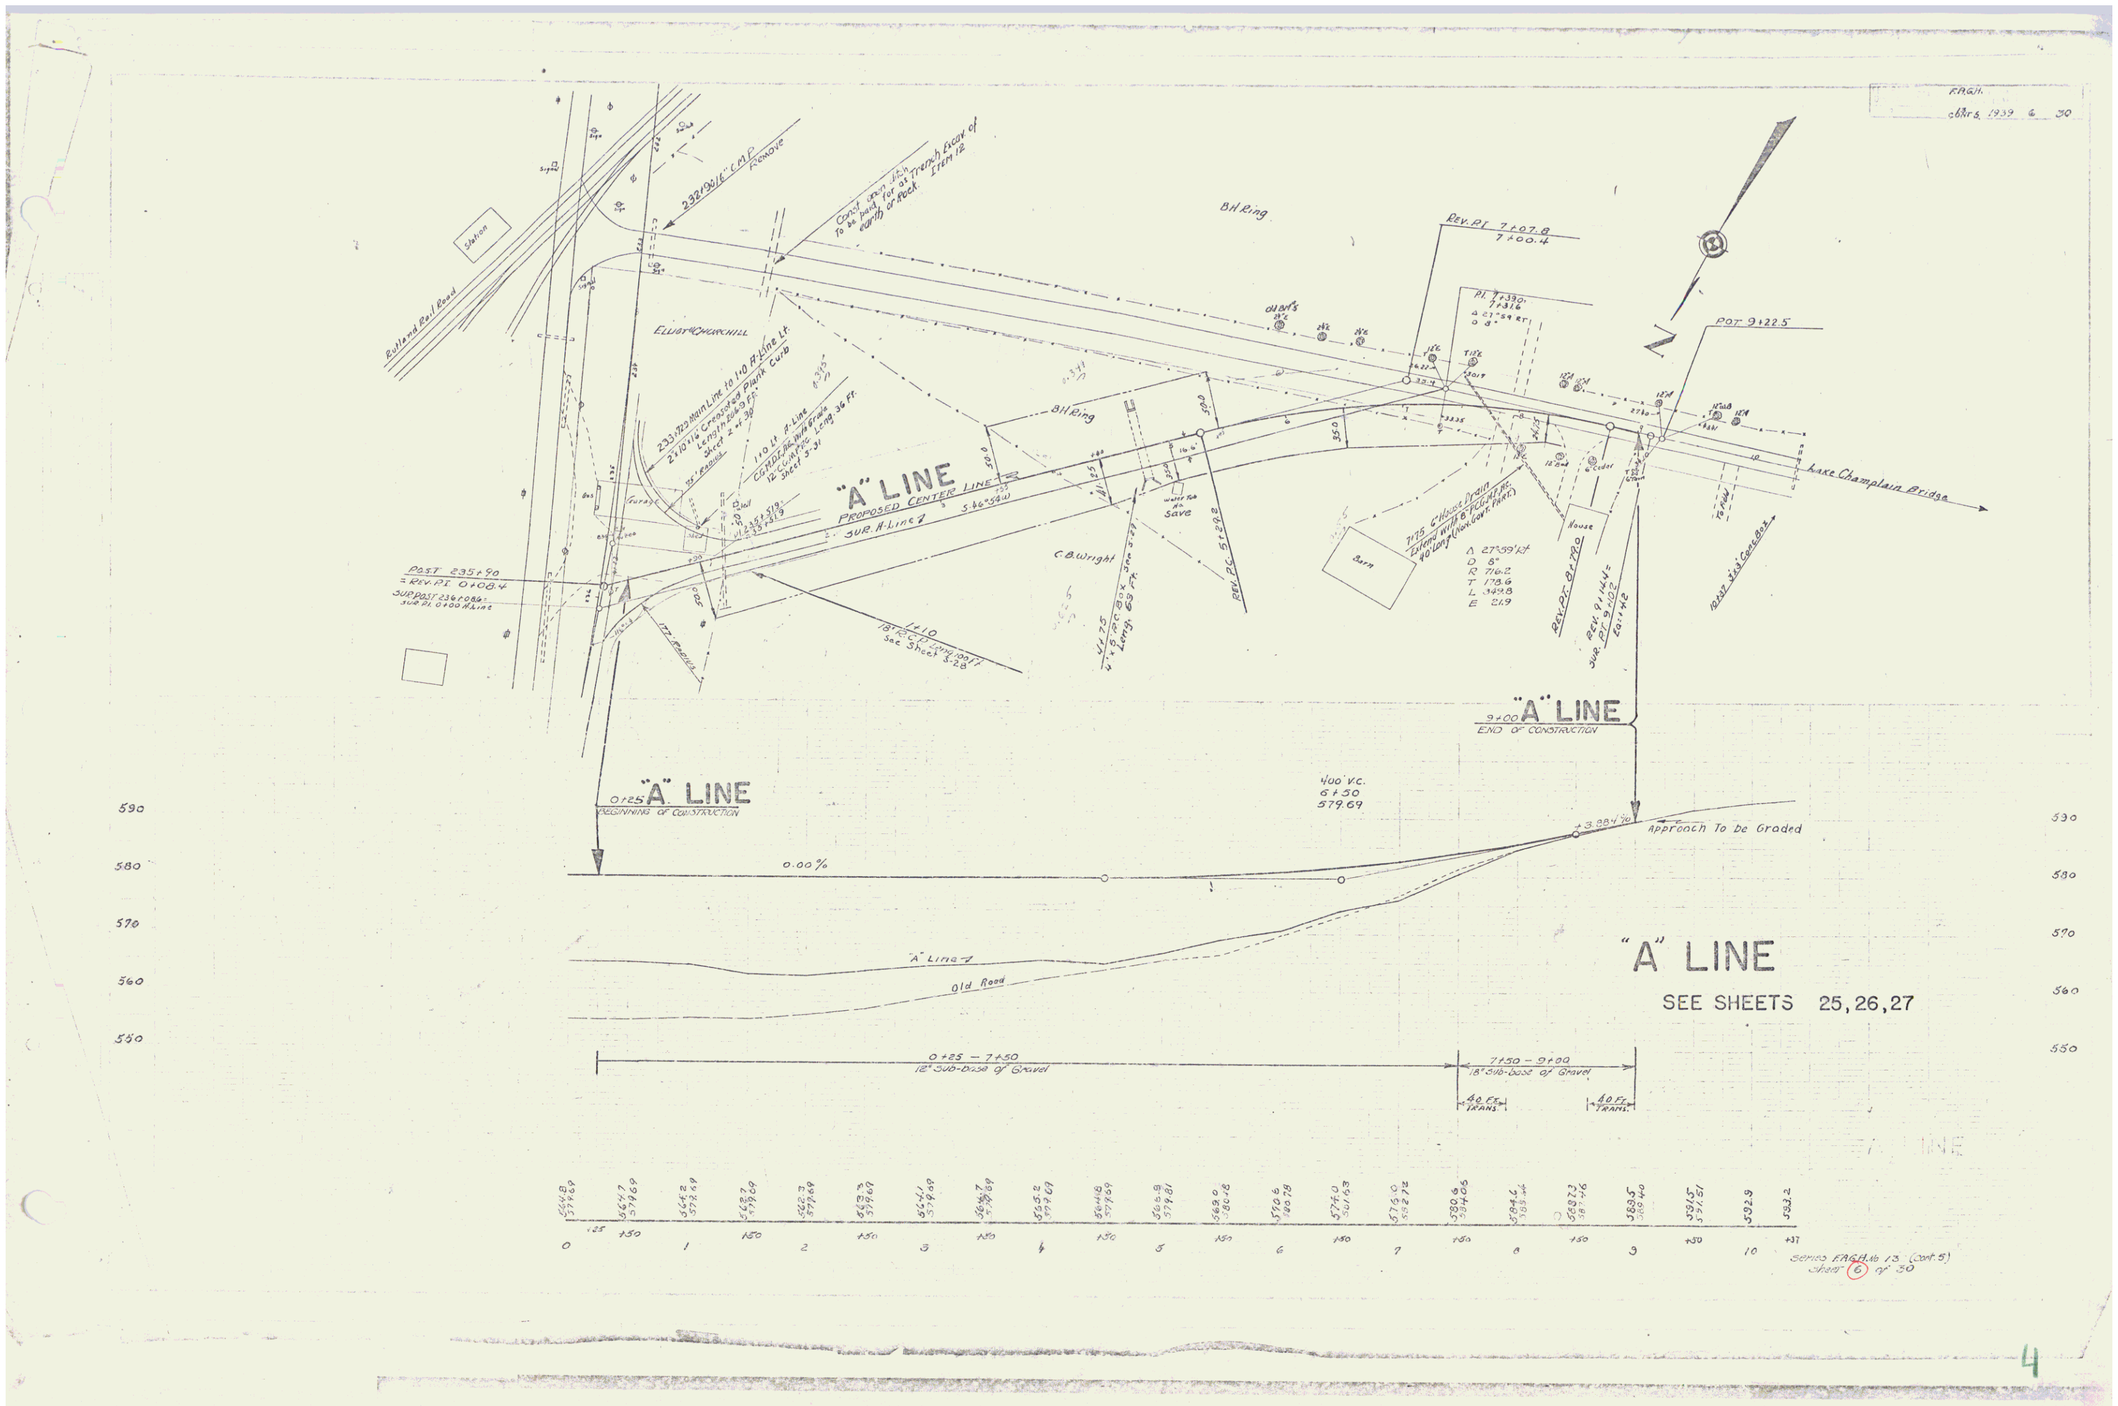

Series F.A.G.H. 13 (Cont. 5)
Sheet 6 of 30

4