FED. ROAD DIST. NO.	STATE	F.A.P. PROJ. NO.	FISCAL YEAR	SHEET NO.	TOTAL SHEETS

(CONT. 3)

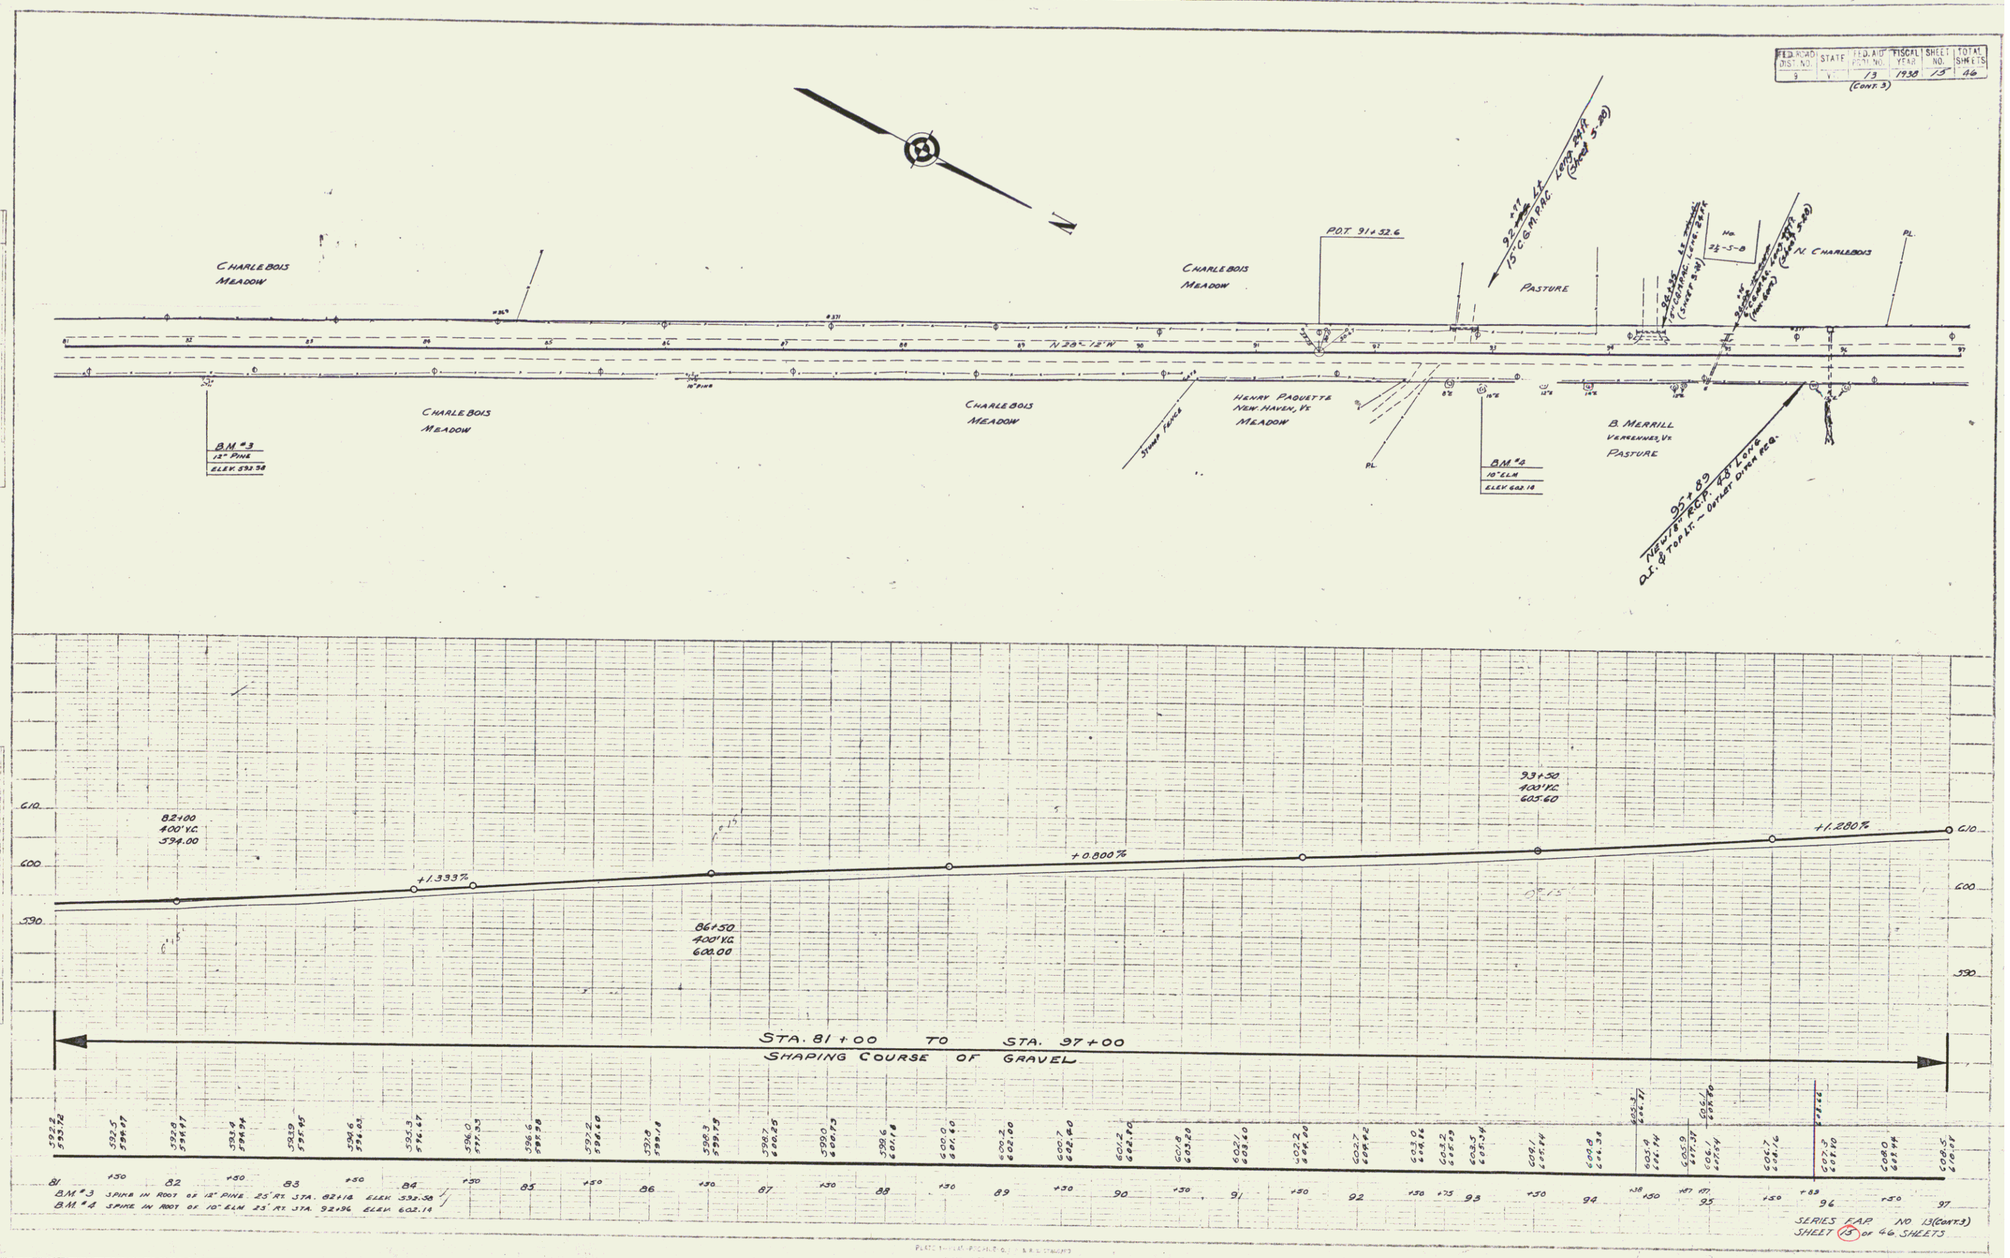

SERIES F.A.P. NO. 13 (CONT. 3)
