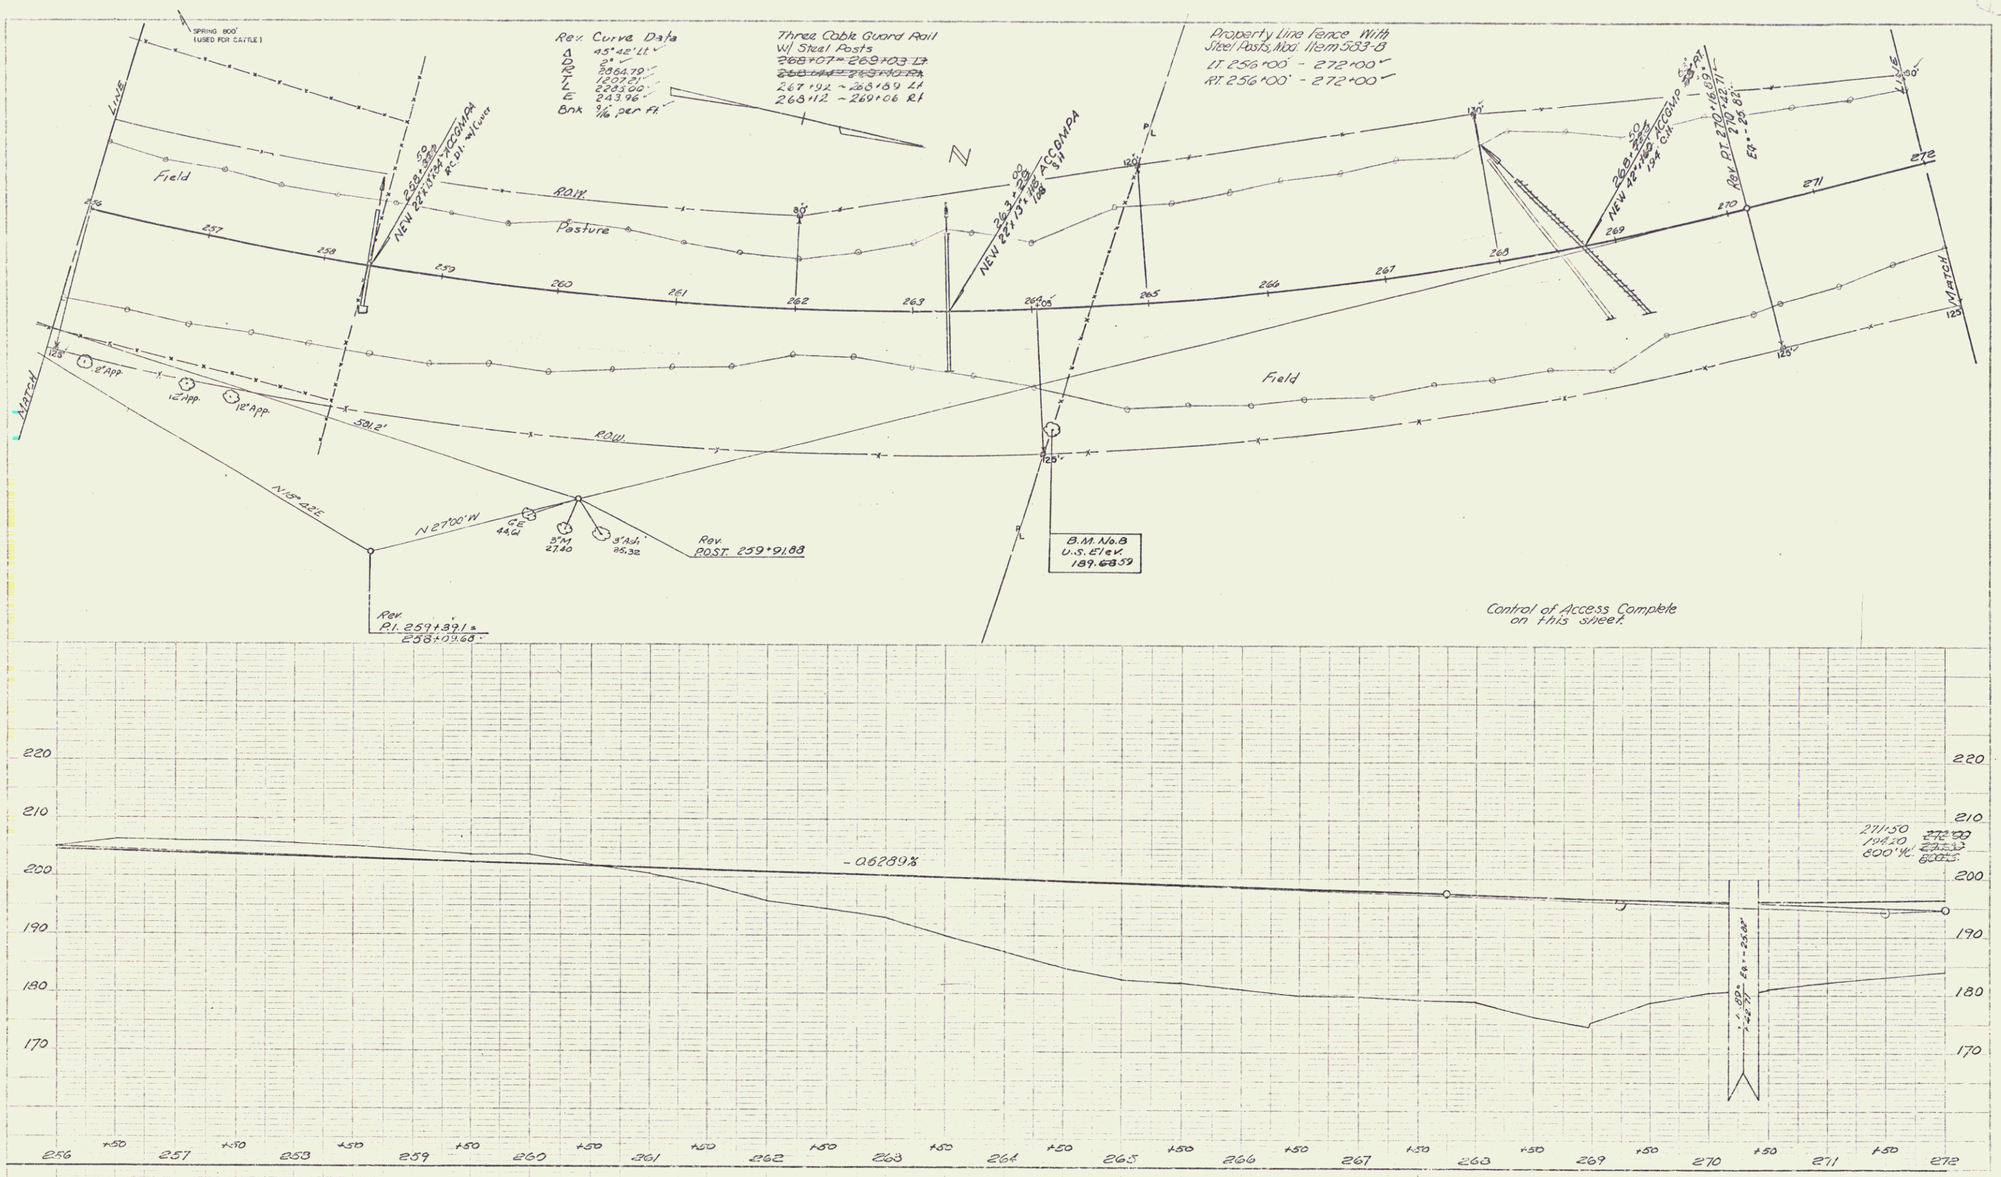

WALTHAM-FERRISBURG
F-019-4(3)
Sheet 20 of 94 Sheets

17