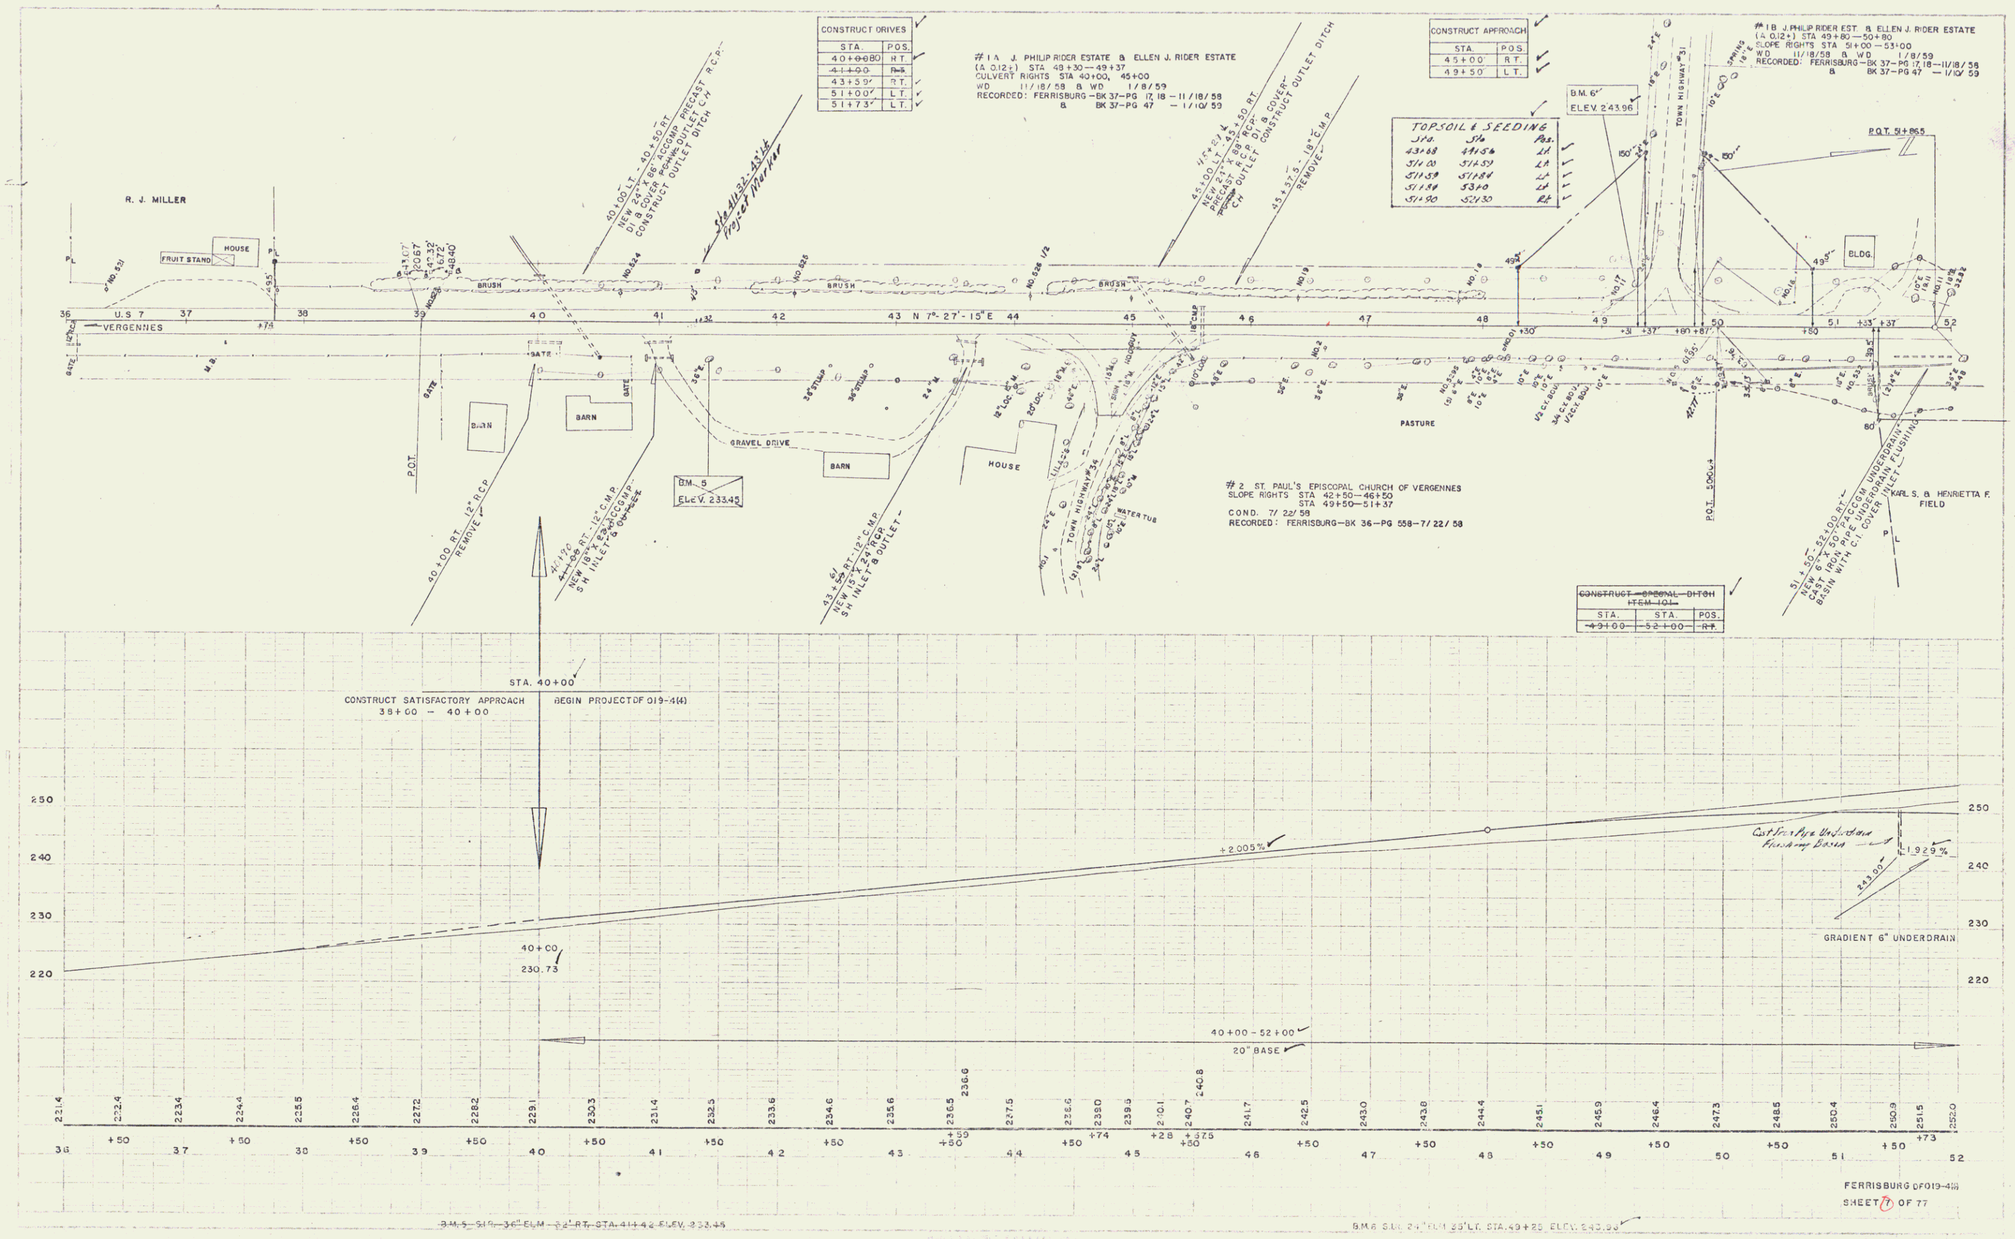

WEBSTER-MARTIN, INC. 8-57
WEBSTER-MARTIN, INC. 8-57

3