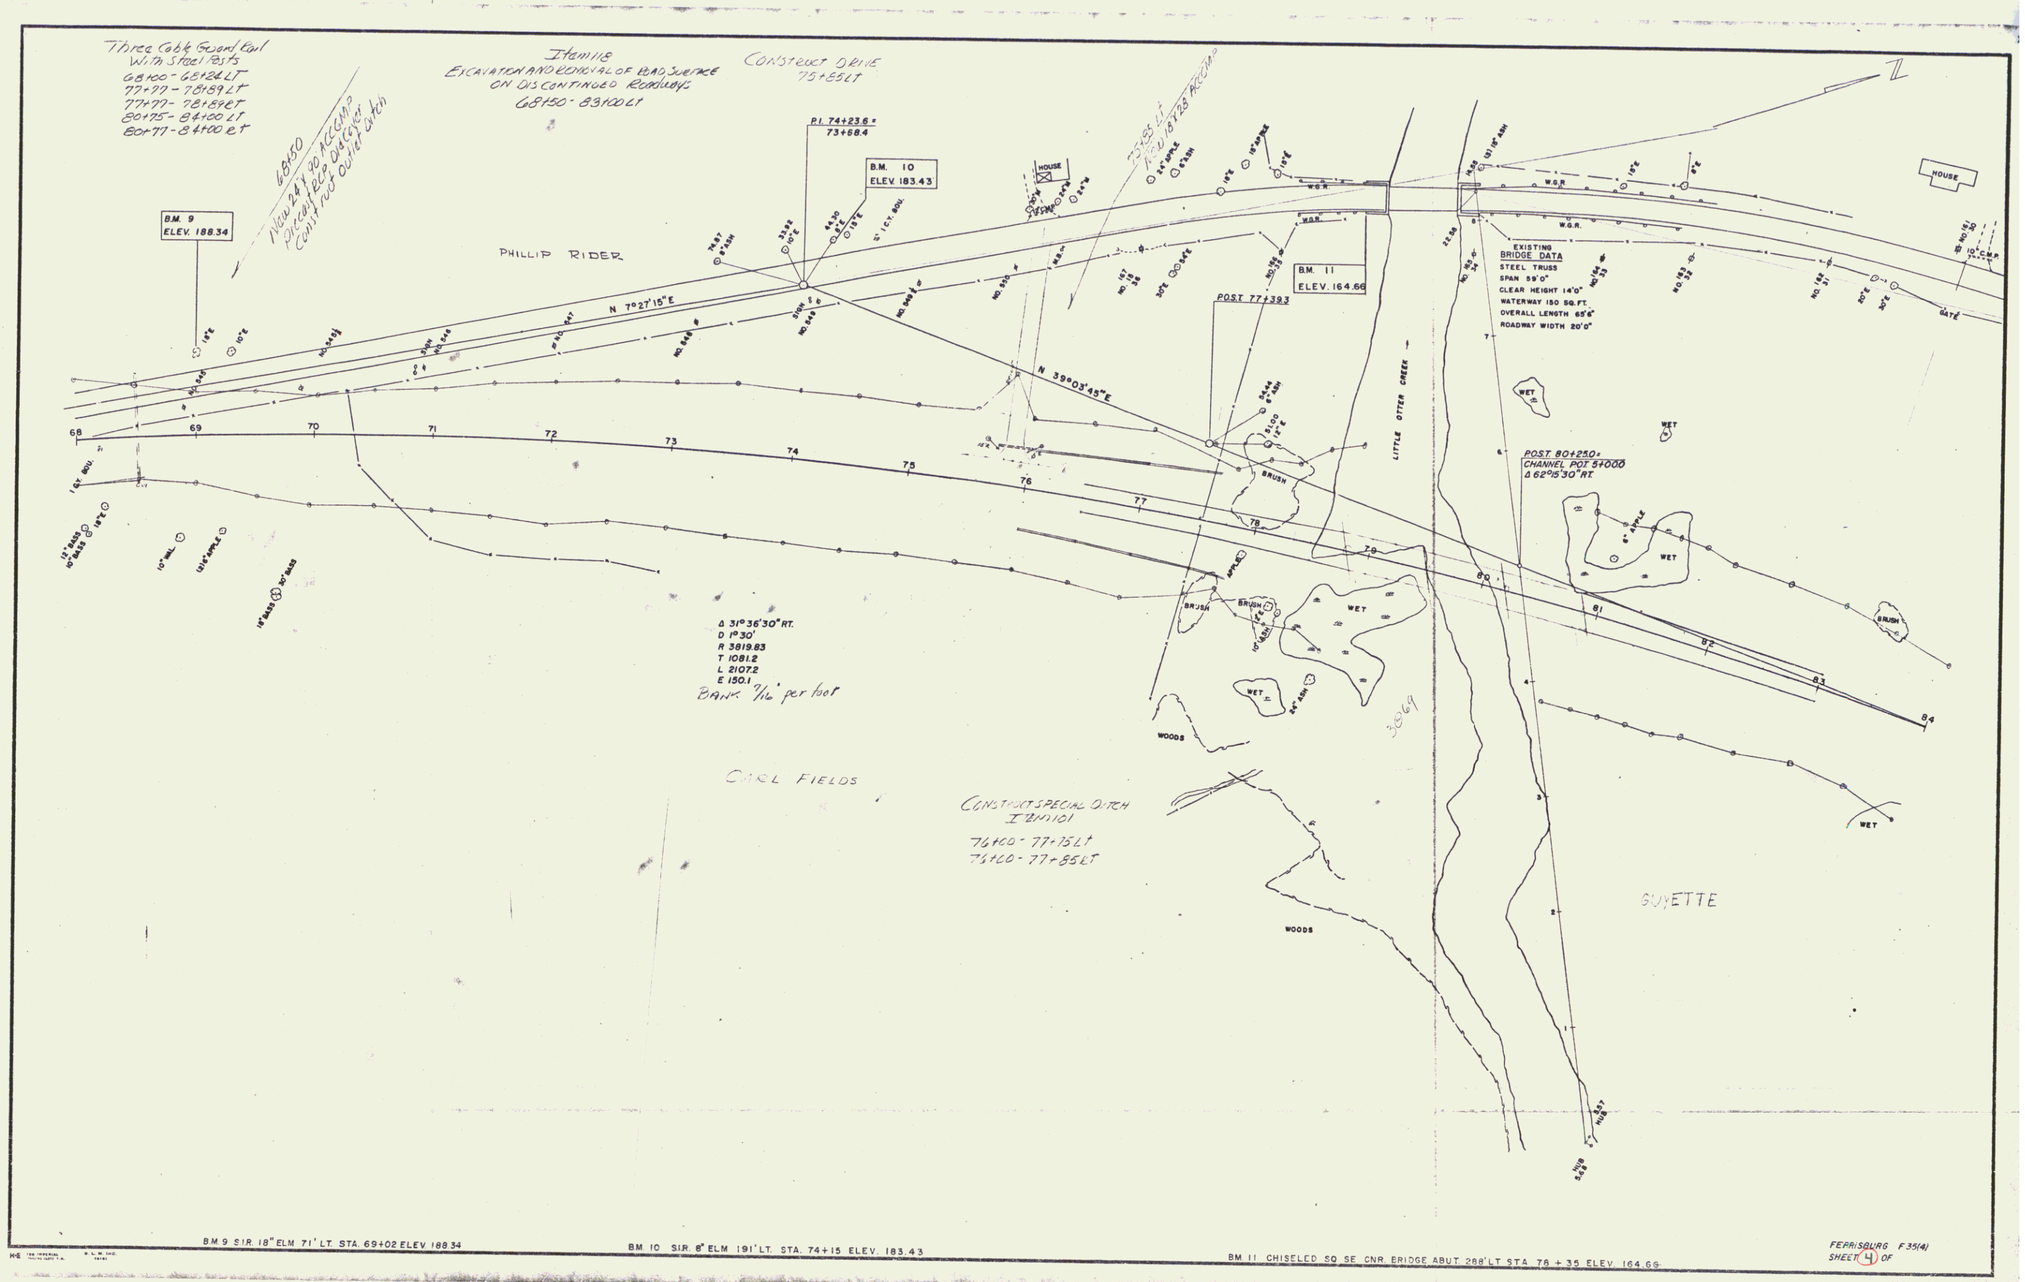
Three Cable Guard Rail
With Steel Posts
68+00 - 68+24 LT
77+77 - 78+89 LT
77+77 - 78+89 RT
80+75 - 84+00 LT
80+77 - 84+00 RT
Item 118
Excavation and Removal of Bad Surface
on Discontinued Roadways
68+50 - 83+20 LT
Construct Drive
75+55 LT
68+50
New 24" CMP to accomp
Drainage Ditch Discharge
Construct Outlet Ditch
P.I. 74+23.6 =
73+68.4
B.M. 10
ELEV. 183.43
B.M. 9
ELEV. 188.34
HOUSE
PHILLIP RIDER
N 7°27'15" E
N 39°03'45" E
B.M. 11
ELEV. 164.66
POST 77+39.3
EXISTING
BRIDGE DATA
STEEL TRUSS
SPAN 59'0"
CLEAR HEIGHT 14'0"
WATERWAY 150 SQ. FT.
OVERALL LENGTH 65'6"
ROADWAY WIDTH 20'0"
LITTLE OTTER CREEK
POST 80+250 =
CHANNEL POT. 57000
Δ 62°15'30" RT.
Δ 31°36'30" RT.
D 1°30'
R 3819.83
T 1081.2
L 2107.2
E 150.1
BANK 7/16" per foot
CARL FIELDS
CONSTRUCT SPECIAL DITCH
ITEM 101
76+00 - 77+75 LT
76+00 - 77+85 RT
3069
GUYETTE
WET
BRUSH
WOODS
GATE
BM 9 S.I.R. 18" ELM 71' LT. STA. 69+02 ELEV 188.34
BM 10 S.I.R. 8" ELM 191' LT. STA. 74+15 ELEV. 183.43
BM 11 CHISELED SQ SE CNR BRIDGE ABUT. 288' LT STA 78 + 35 ELEV. 164.66
FERRISBURG F 35(4)
SHEET 4 OF