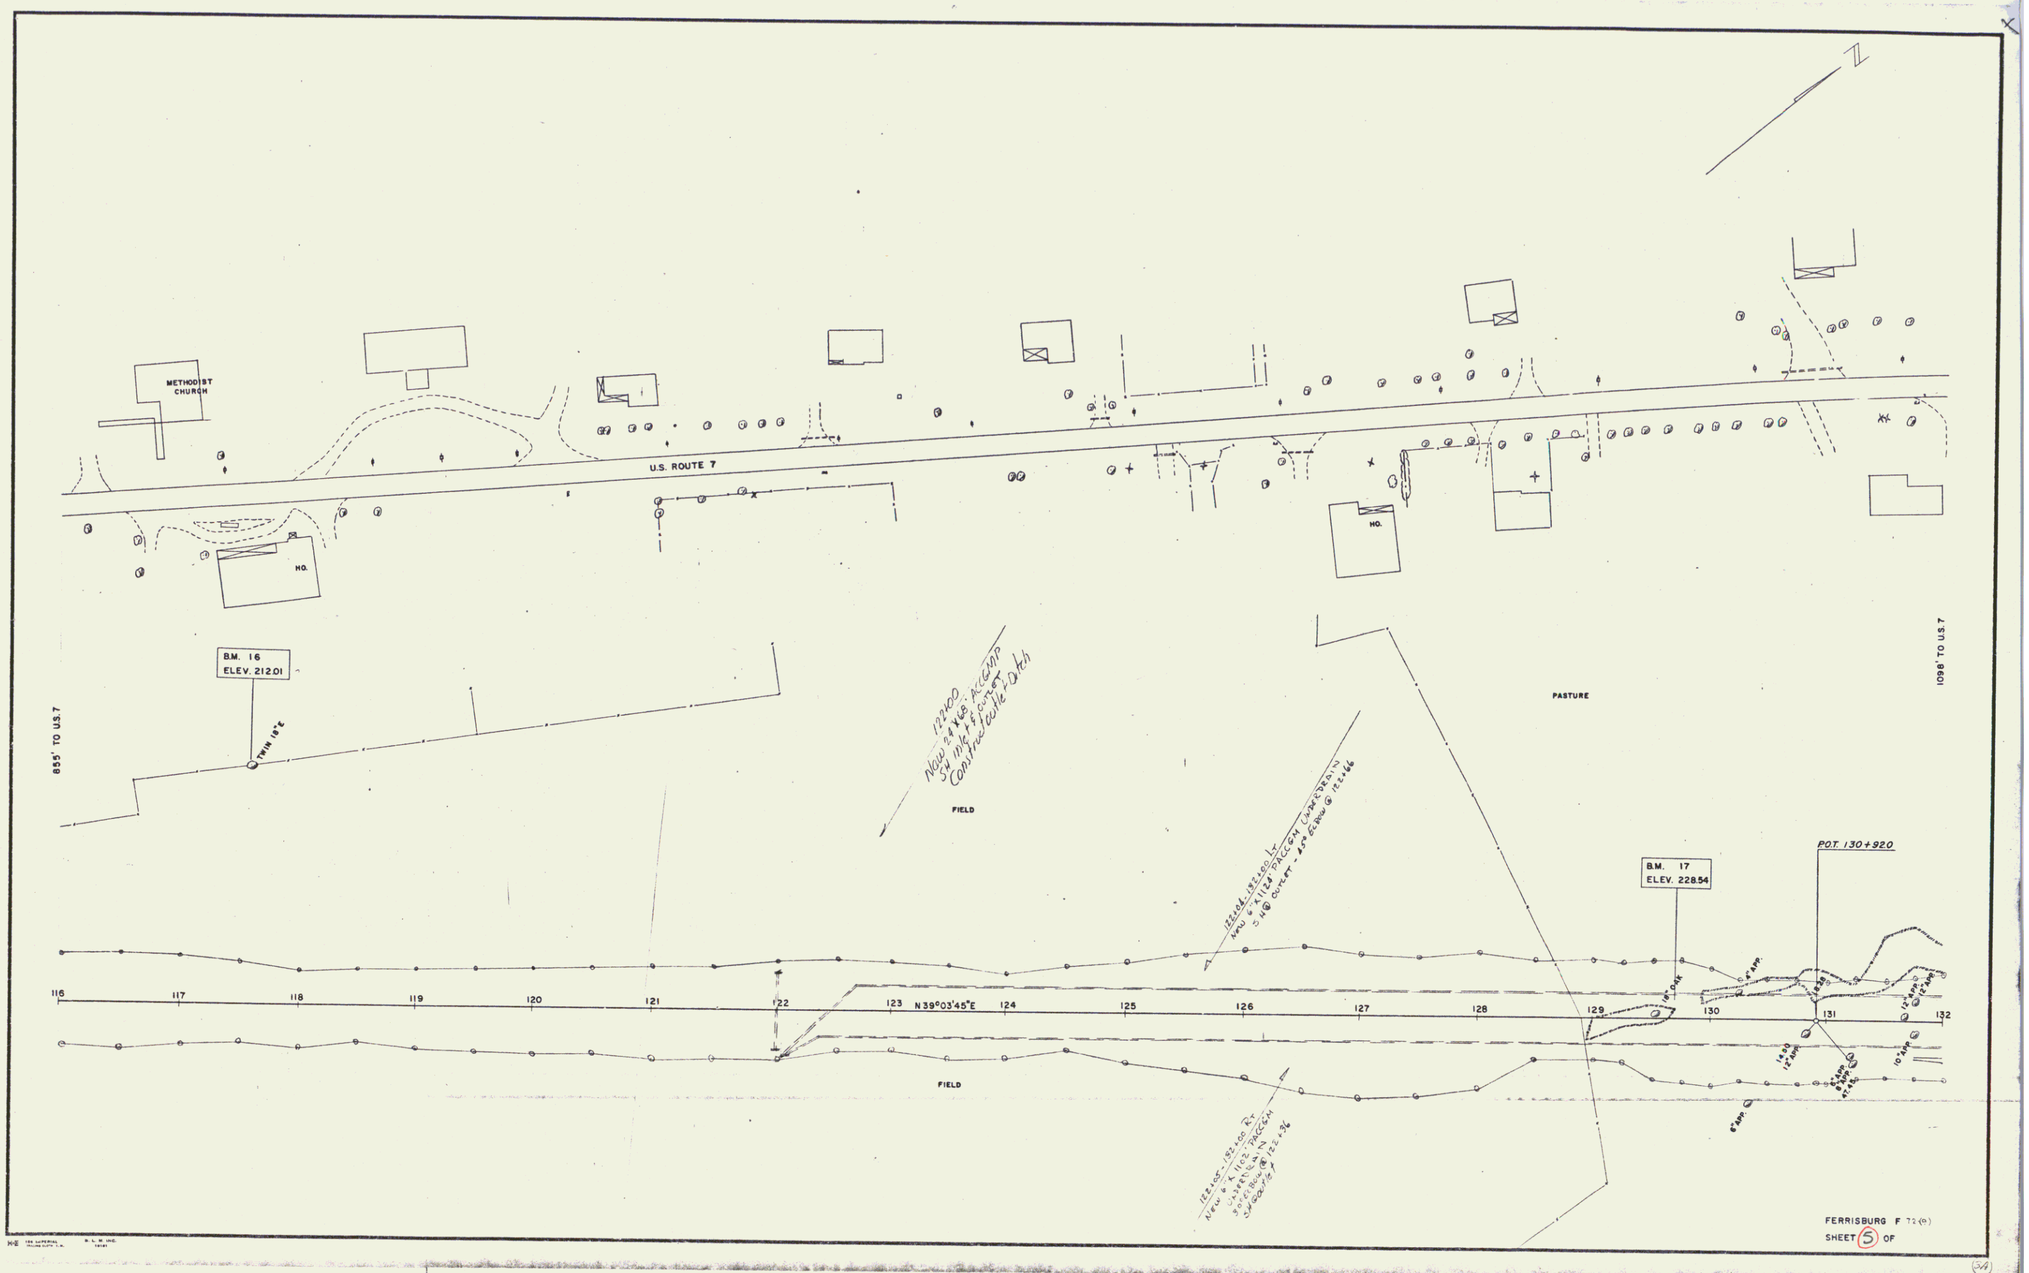
N
METHODIST CHURCH
U.S. ROUTE 7
HO.
HO.
B.M. 16
ELEV. 212.01
TWIN 18"ø
855' TO U.S.7
1098' TO U.S.7
PASTURE
FIELD
FIELD
B.M. 17
ELEV. 228.54
P.O.T. 130+920
116
117
118
119
120
121
122
123
N 39°03'45"E
124
125
126
127
128
129
130
131
132
FERRISBURG F 72(P)
SHEET 5 OF

5