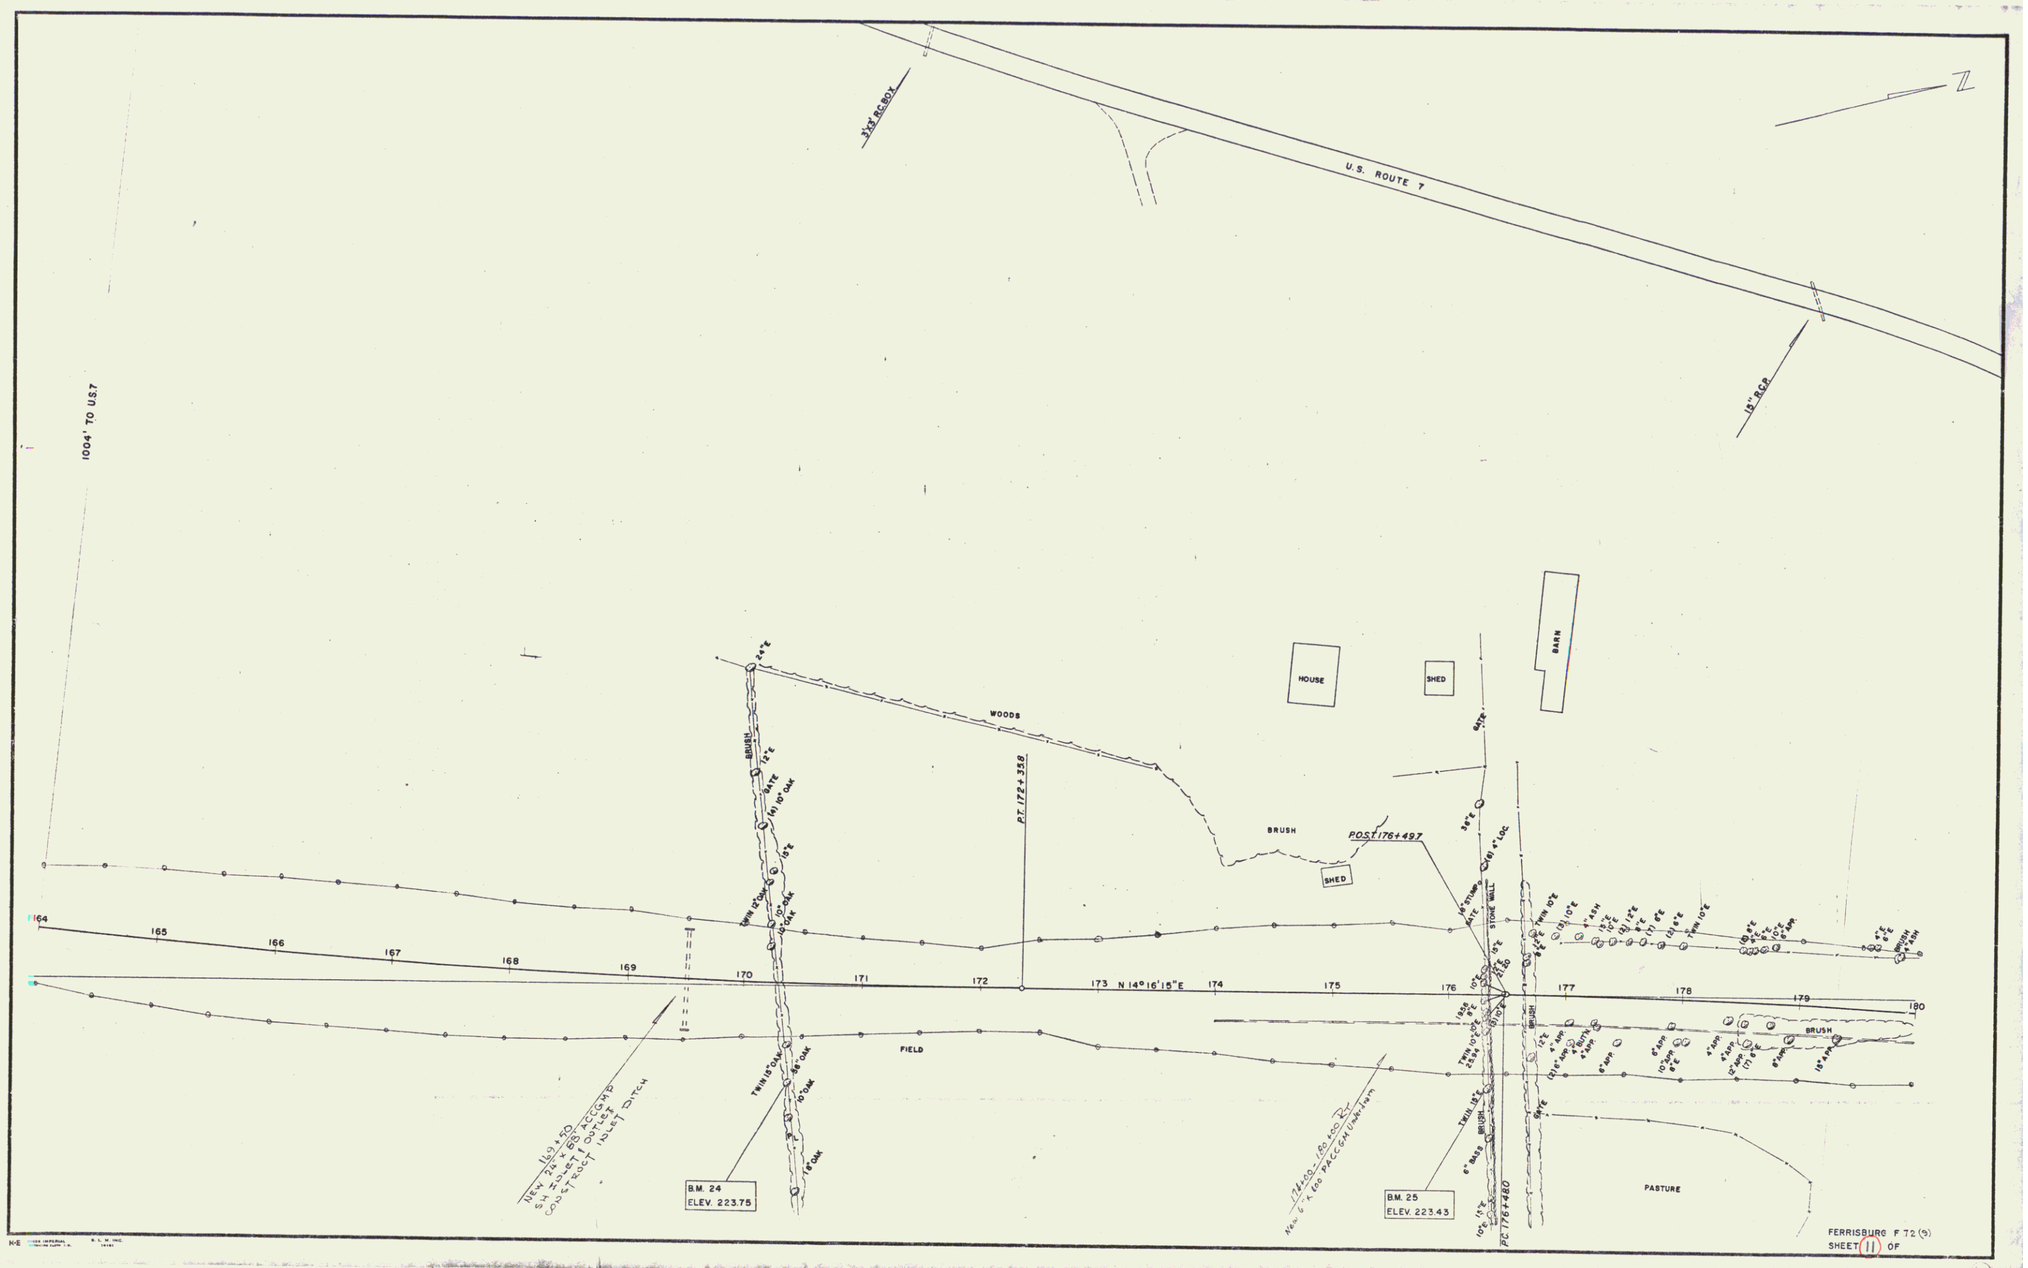
U.S. ROUTE 7
3'x4' RC BOX
18" RCP
N
1004' TO U.S.7
WOODS
HOUSE
SHED
BARN
BRUSH
P.T. 172+358
POST 176+497
SHED
STONE WALL
164
165
166
167
168
169
170
171
172
173 N 14°16'15"E
174
175
176
177
178
179
180
FIELD
BRUSH
PASTURE
B.M. 24
ELEV. 223.75
B.M. 25
ELEV. 223.43
PC 176+480
FERRISBURG F 72 (9)
SHEET 11 OF