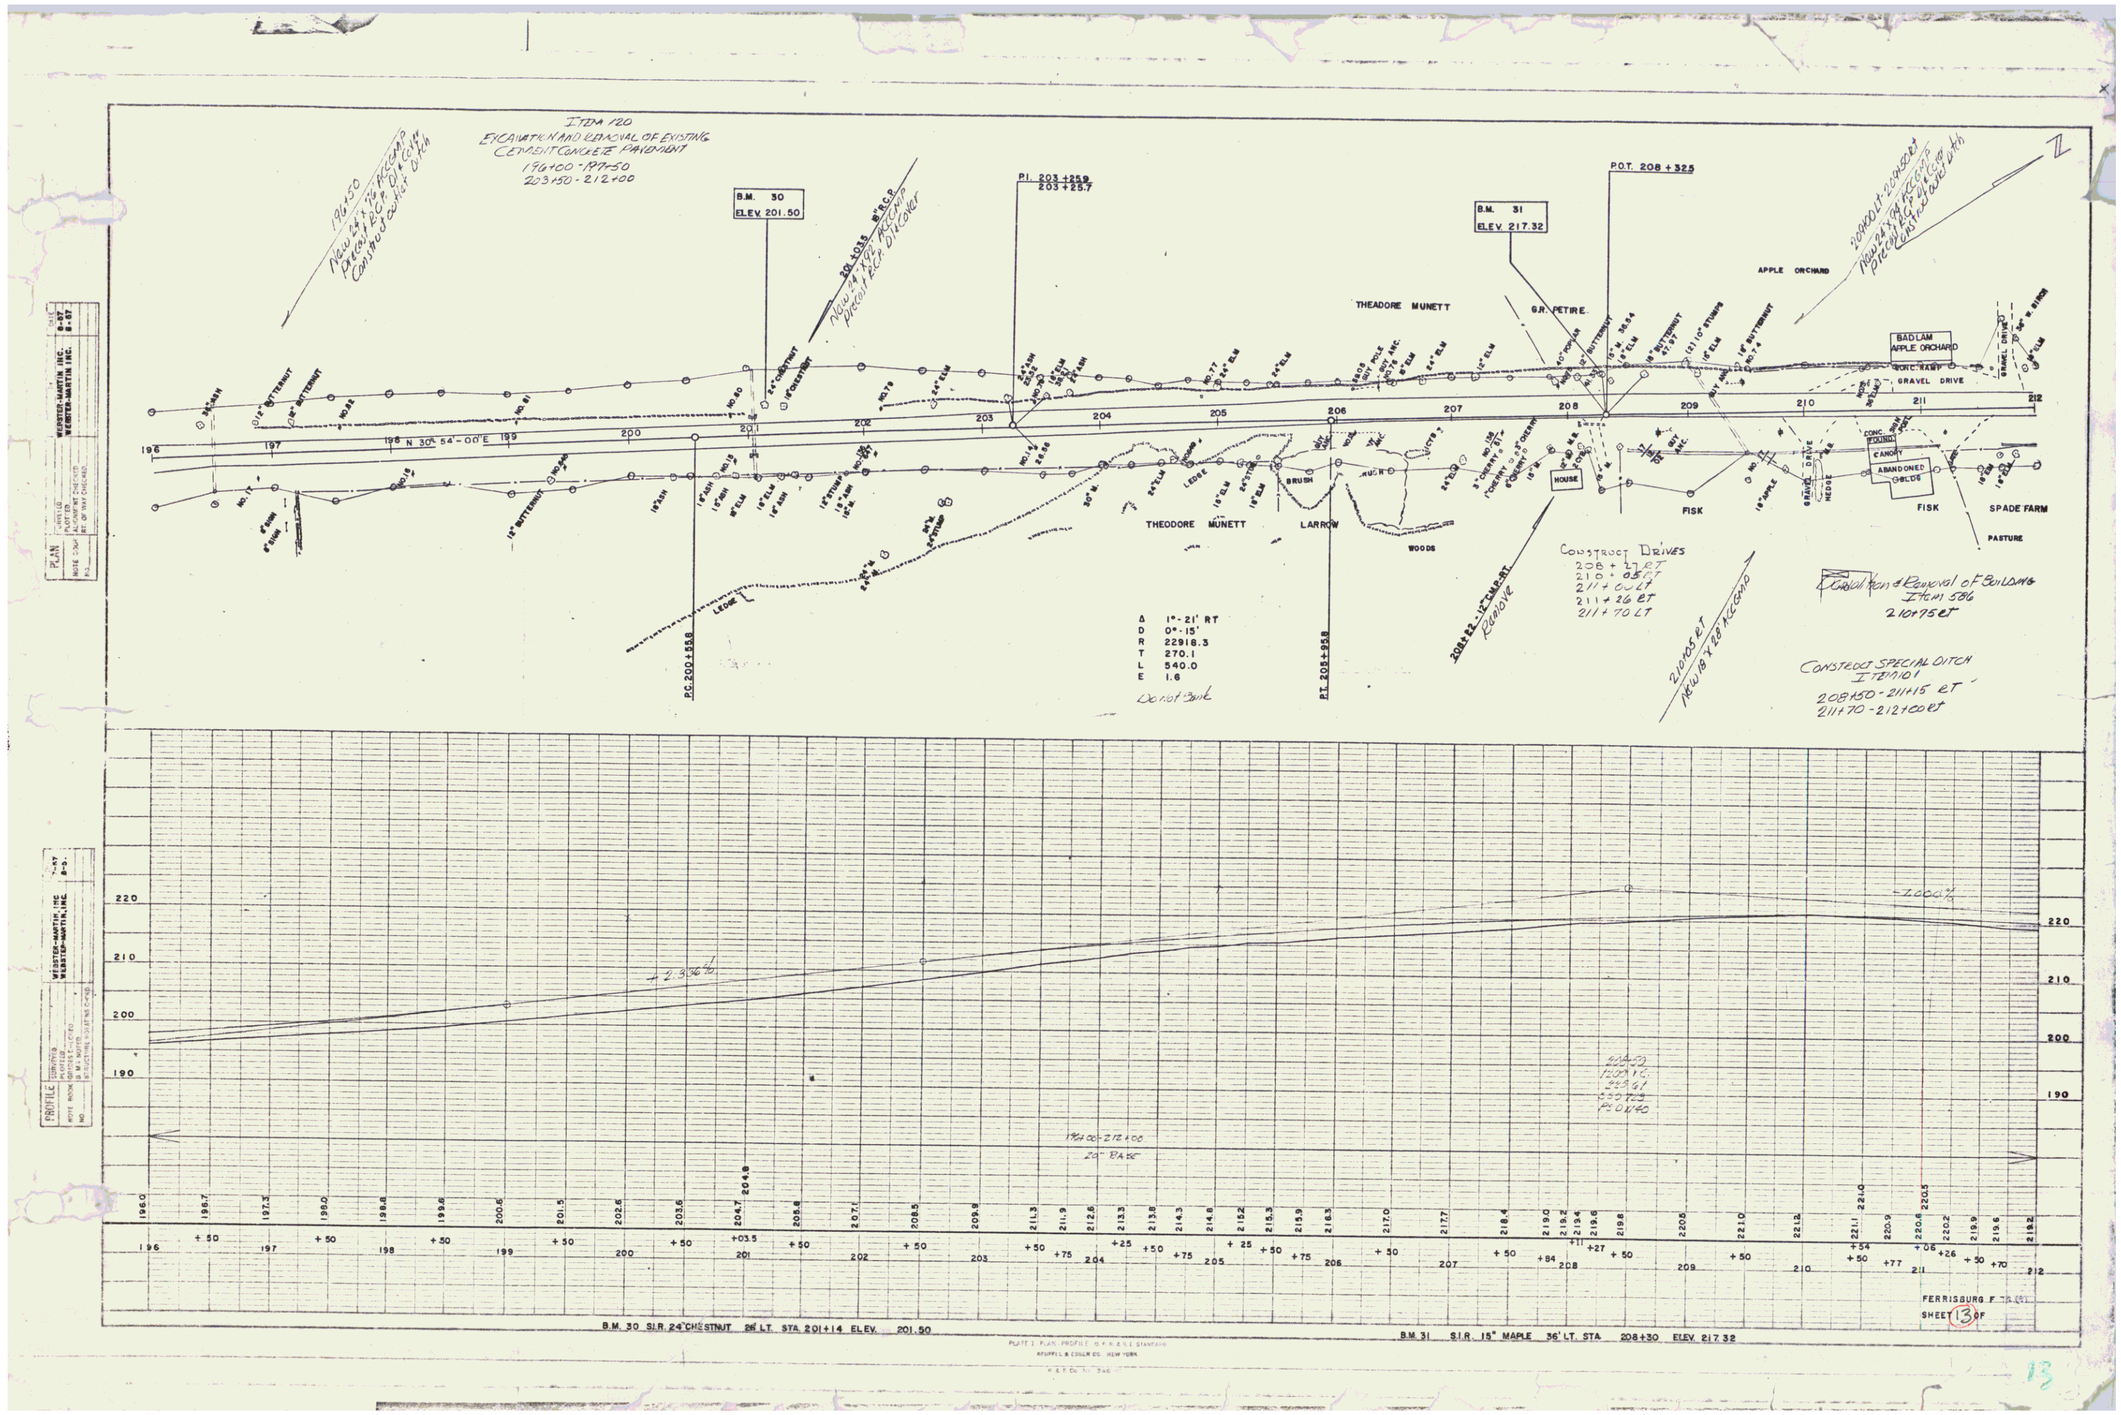
ITEM 120
EXCAVATION AND REMOVAL OF EXISTING CEMENT CONCRETE PAVEMENT
196+00 - 197+50
203+50 - 212+00
B.M. 30
ELEV. 201.50
P.I. 203+25.9
203+25.7
B.M. 31
ELEV. 217.32
P.O.T. 208+325
THEODORE MUNETT
G.R. PETIRE
APPLE ORCHARD
BADLAM APPLE ORCHARD
GRAVEL DRIVE
N 30° 54' - 00" E
HOUSE
BRUSH
LARROW
WOODS
FISK
SPADE FARM
PASTURE
CANOPY
ABANDONED OBLDG
P.C. 200+558
P.T. 205+958
Δ 1°-21' RT
D 0°-15'
R 22918.3
T 270.1
L 540.0
E 1.6
Do not Bank
Construct Drives
208+27 RT
210+05 RT
211+00 LT
211+26 RT
211+70 LT
Construct Special Ditch
Item 101
208+50 - 211+15 RT
211+70 - 212+00 RT
Item 586
210+75 RT
WEBSTER-MARTIN INC.
PLAN
PROFILE
B.M. 30 S.I.R. 24" CHESTNUT 26' LT. STA. 201+14 ELEV. 201.50
B.M. 31 S.I.R. 15" MAPLE 36' LT. STA. 208+30 ELEV. 217.32
FERRISBURG
SHEET 13 OF