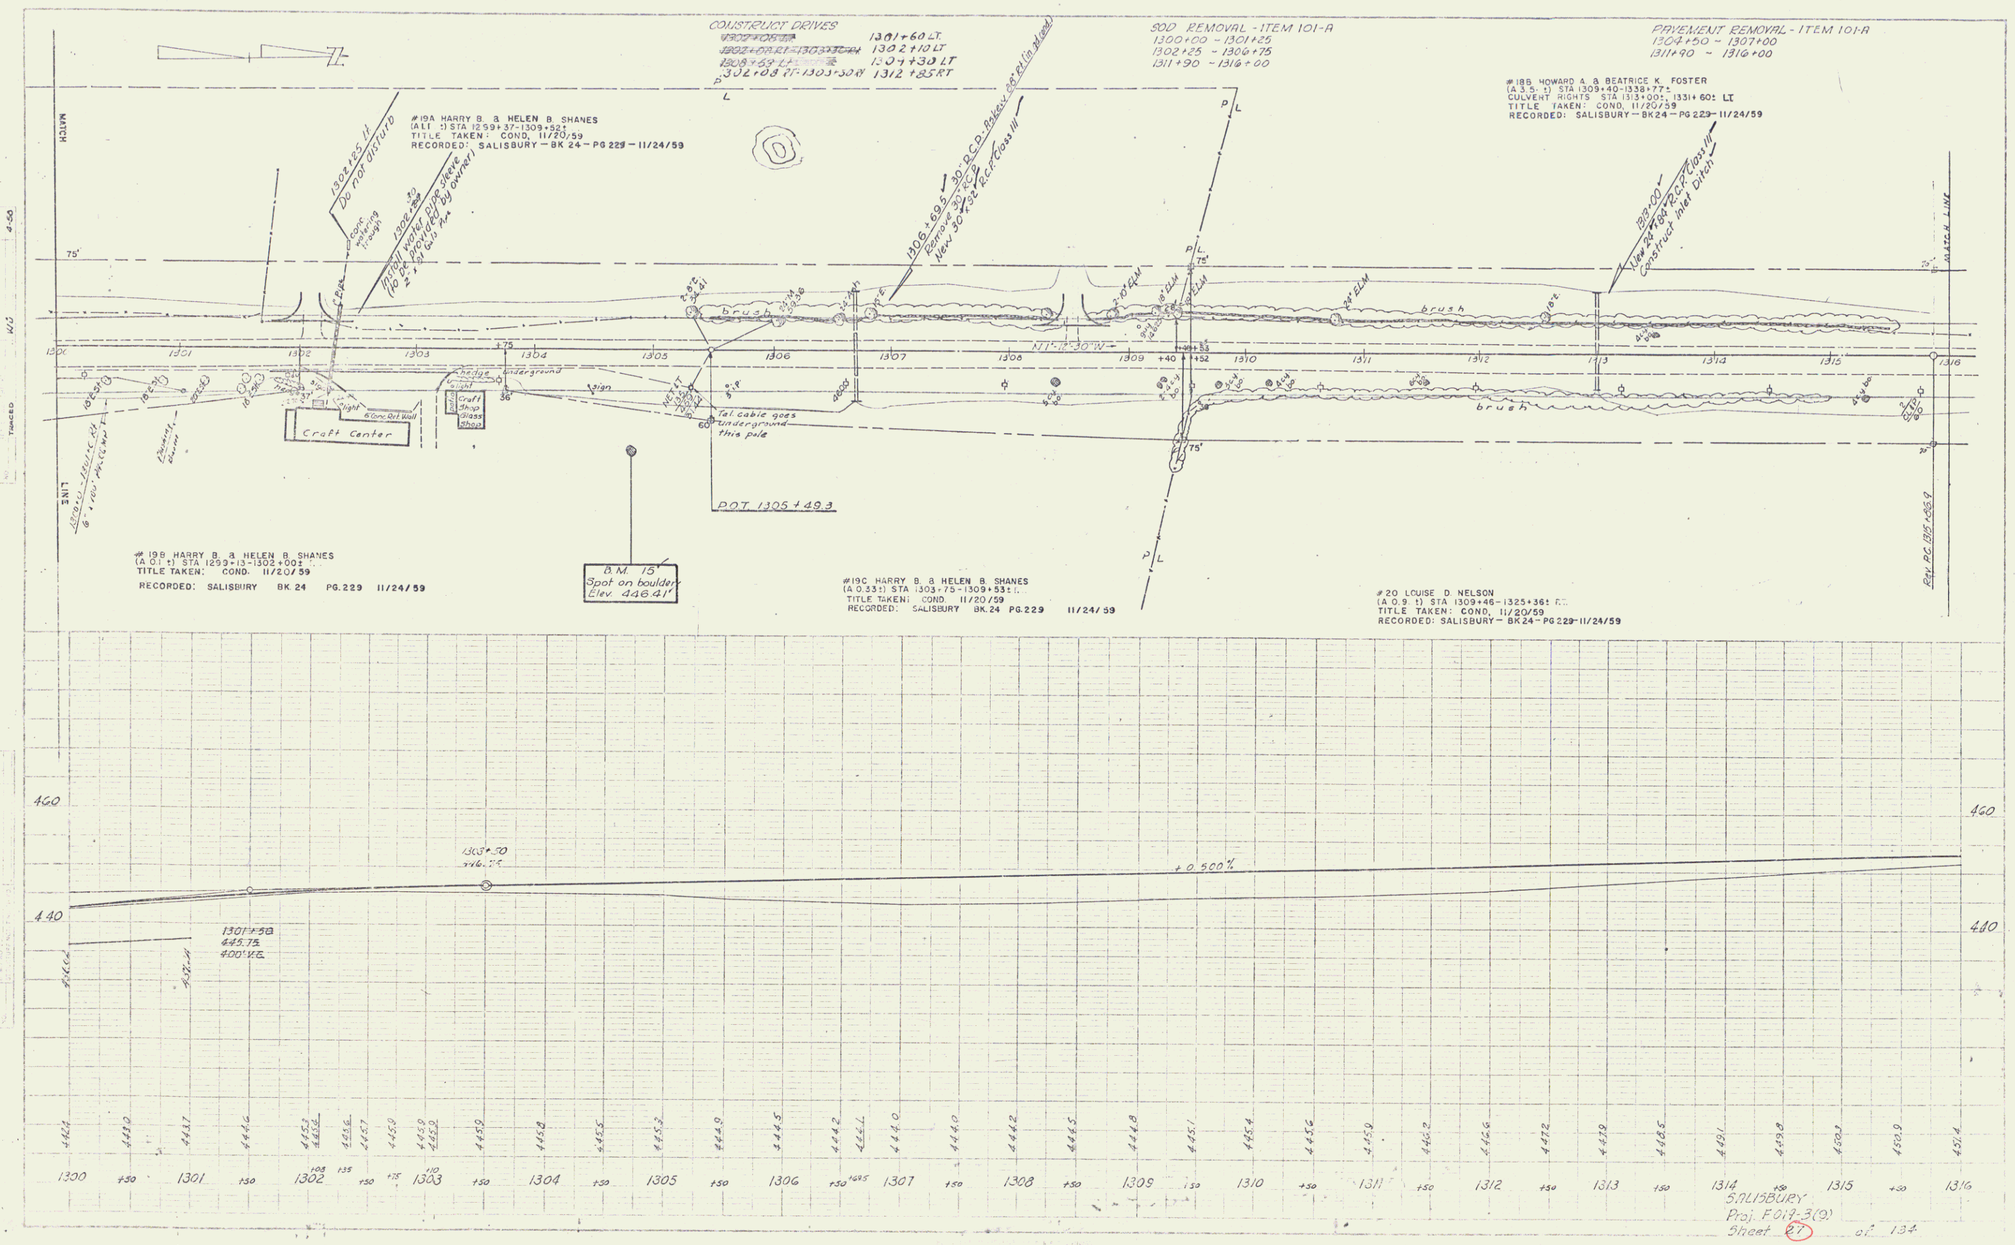

SALISBURY
Proj. F014-3(9)
Sheet 27 of 134

10