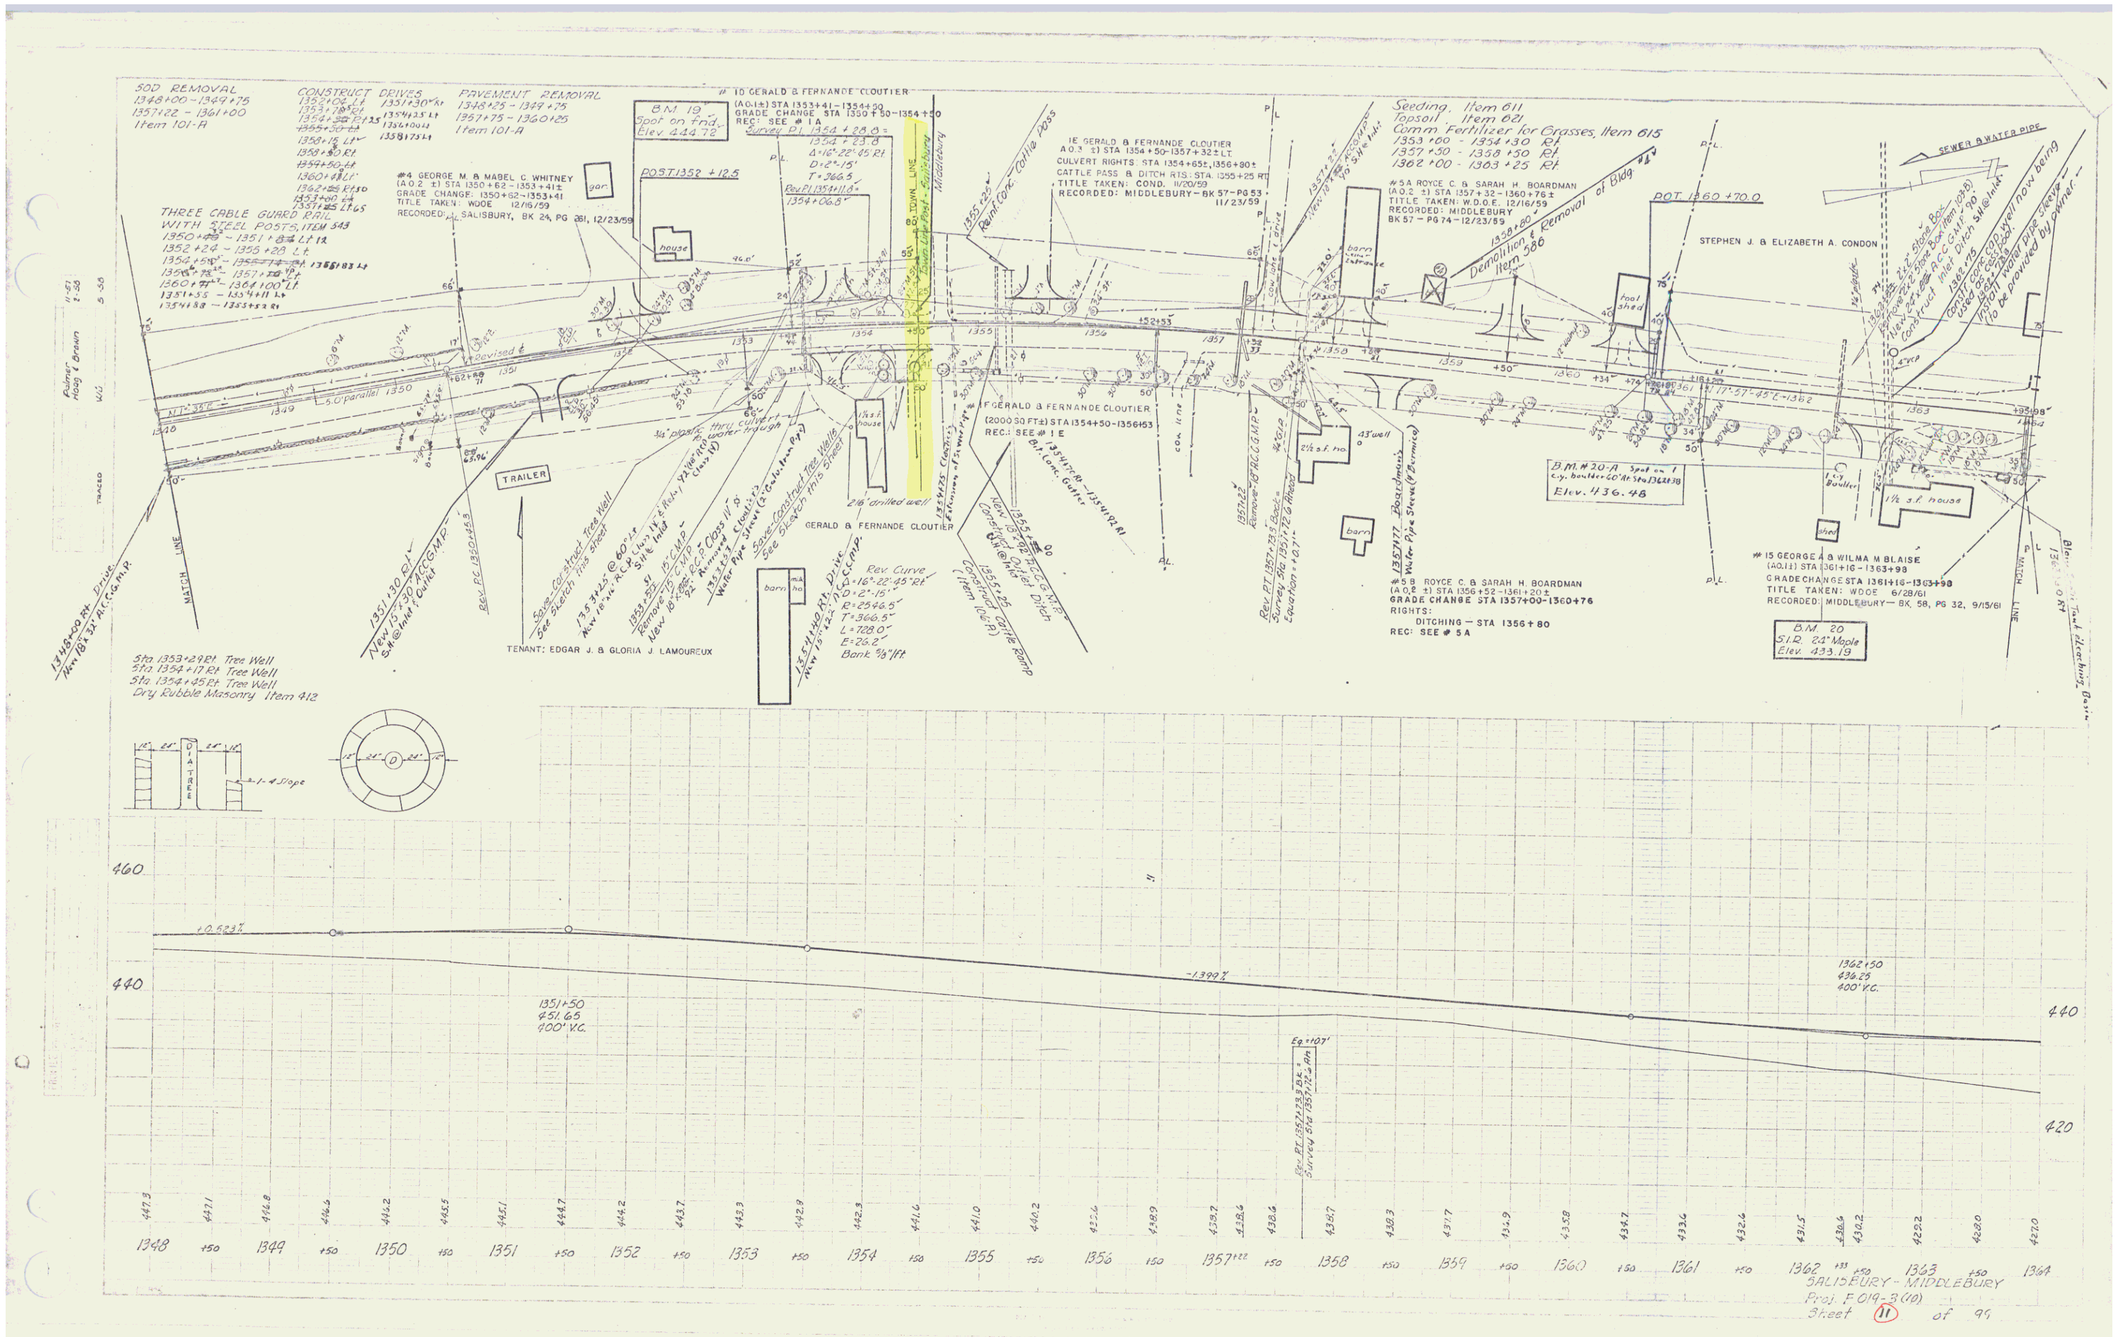
SOD REMOVAL
1348+00 - 1349+75
1357+22 - 1361+00
Item 101-A
CONSTRUCT DRIVES
PAVEMENT REMOVAL
Item 101-A
THREE CABLE GUARD RAIL WITH STEEL POSTS, ITEM 543
B.M. 19
Spot on fnd.
Elev. 444.78
POST 1352 +12.5
#4 GEORGE M. & MABEL C. WHITNEY
(A.O.2 ±) STA 1350+62 - 1353+41±
GRADE CHANGE: 1350+62 - 1353+41
TITLE TAKEN: WDOE 12/16/59
RECORDED: SALISBURY, BK 24, PG 261, 12/23/59
#10 GERALD & FERNANDE CLOUTIER
(A.O.1±) STA 1353+41 - 1354+20
GRADE CHANGE STA 1350+50 - 1354+50
REC: SEE # 1A
Curve (1) 1354+28.0 =
1354+23.8
Δ=16°-22'-45"Rt
D=2°-15'
T=366.5
Rev PI 1354+11.8
1354+06.8
house
barn
TRAILER
TENANT: EDGAR J. & GLORIA J. LAMOUREUX
GERALD & FERNANDE CLOUTIER
1E GERALD & FERNANDE CLOUTIER
(A.O.3 ±) STA 1354+50 - 1357+32± LT.
CULVERT RIGHTS: STA 1354+65±, 1356+80±
CATTLE PASS & DITCH RTS: STA 1355+25 RT
TITLE TAKEN: COND. 11/20/59
RECORDED: MIDDLEBURY - BK 57 - PG 53 - 11/23/59
1F GERALD & FERNANDE CLOUTIER
(2000.50 FT.±) STA 1354+50 - 1356+53
REC.: SEE # 1E
Seeding: Item 611
Topsoil: Item 621
Comm. Fertilizer for Grasses, Item 615
1353+00 - 1354+30 Rt
1357+50 - 1358+50 Rt
1362+00 - 1363+25 Rt
#5A ROYCE C. & SARAH H. BOARDMAN
(A.O.2 ±) STA 1357+32 - 1360+76±
TITLE TAKEN: W.D.O.E. 12/16/59
RECORDED: MIDDLEBURY
BK 57 - PG 74 - 12/23/59
Demolition & Removal of Bldg
Item 586
POT 1360 +70.0
STEPHEN J. & ELIZABETH A. CONDON
SEWER & WATER PIPE
B.M. #20-A
Elev. 436.48
#5B ROYCE C. & SARAH H. BOARDMAN
(A.O.2 ±) STA 1356+52 - 1361+20±
GRADE CHANGE STA 1357+00 - 1360+76
RIGHTS:
DITCHING - STA 1356+80
REC: SEE # 5A
#15 GEORGE A. & WILMA M. BLAISE
(A.O.1±) STA 1361+16 - 1363+98
GRADE CHANGE STA 1361+16 - 1363+98
TITLE TAKEN: WDOE 6/28/61
RECORDED: MIDDLEBURY - BK. 58, PG 32, 9/15/61
B.M. 20
S.I.R. 24" Maple
Elev. 433.19
1351+50
451.65
400' V.C.
1362+50
436.25
400' V.C.
-1.399%
+0.923%
Eq. +10.7'
Sta 1353+29 Rt Tree Well
Sta 1354+17 Rt Tree Well
Sta 1354+45 Rt Tree Well
Dry Rubble Masonry Item 412
Ditch
1:4 Slope
460
440
420
1348 1349 1350 1351 1352 1353 1354 1355 1356 1357 1358 1359 1360 1361 1362 1363 1364
SALISBURY - MIDDLEBURY
Proj. F 019-3(10)
Sheet 11 of 99

4