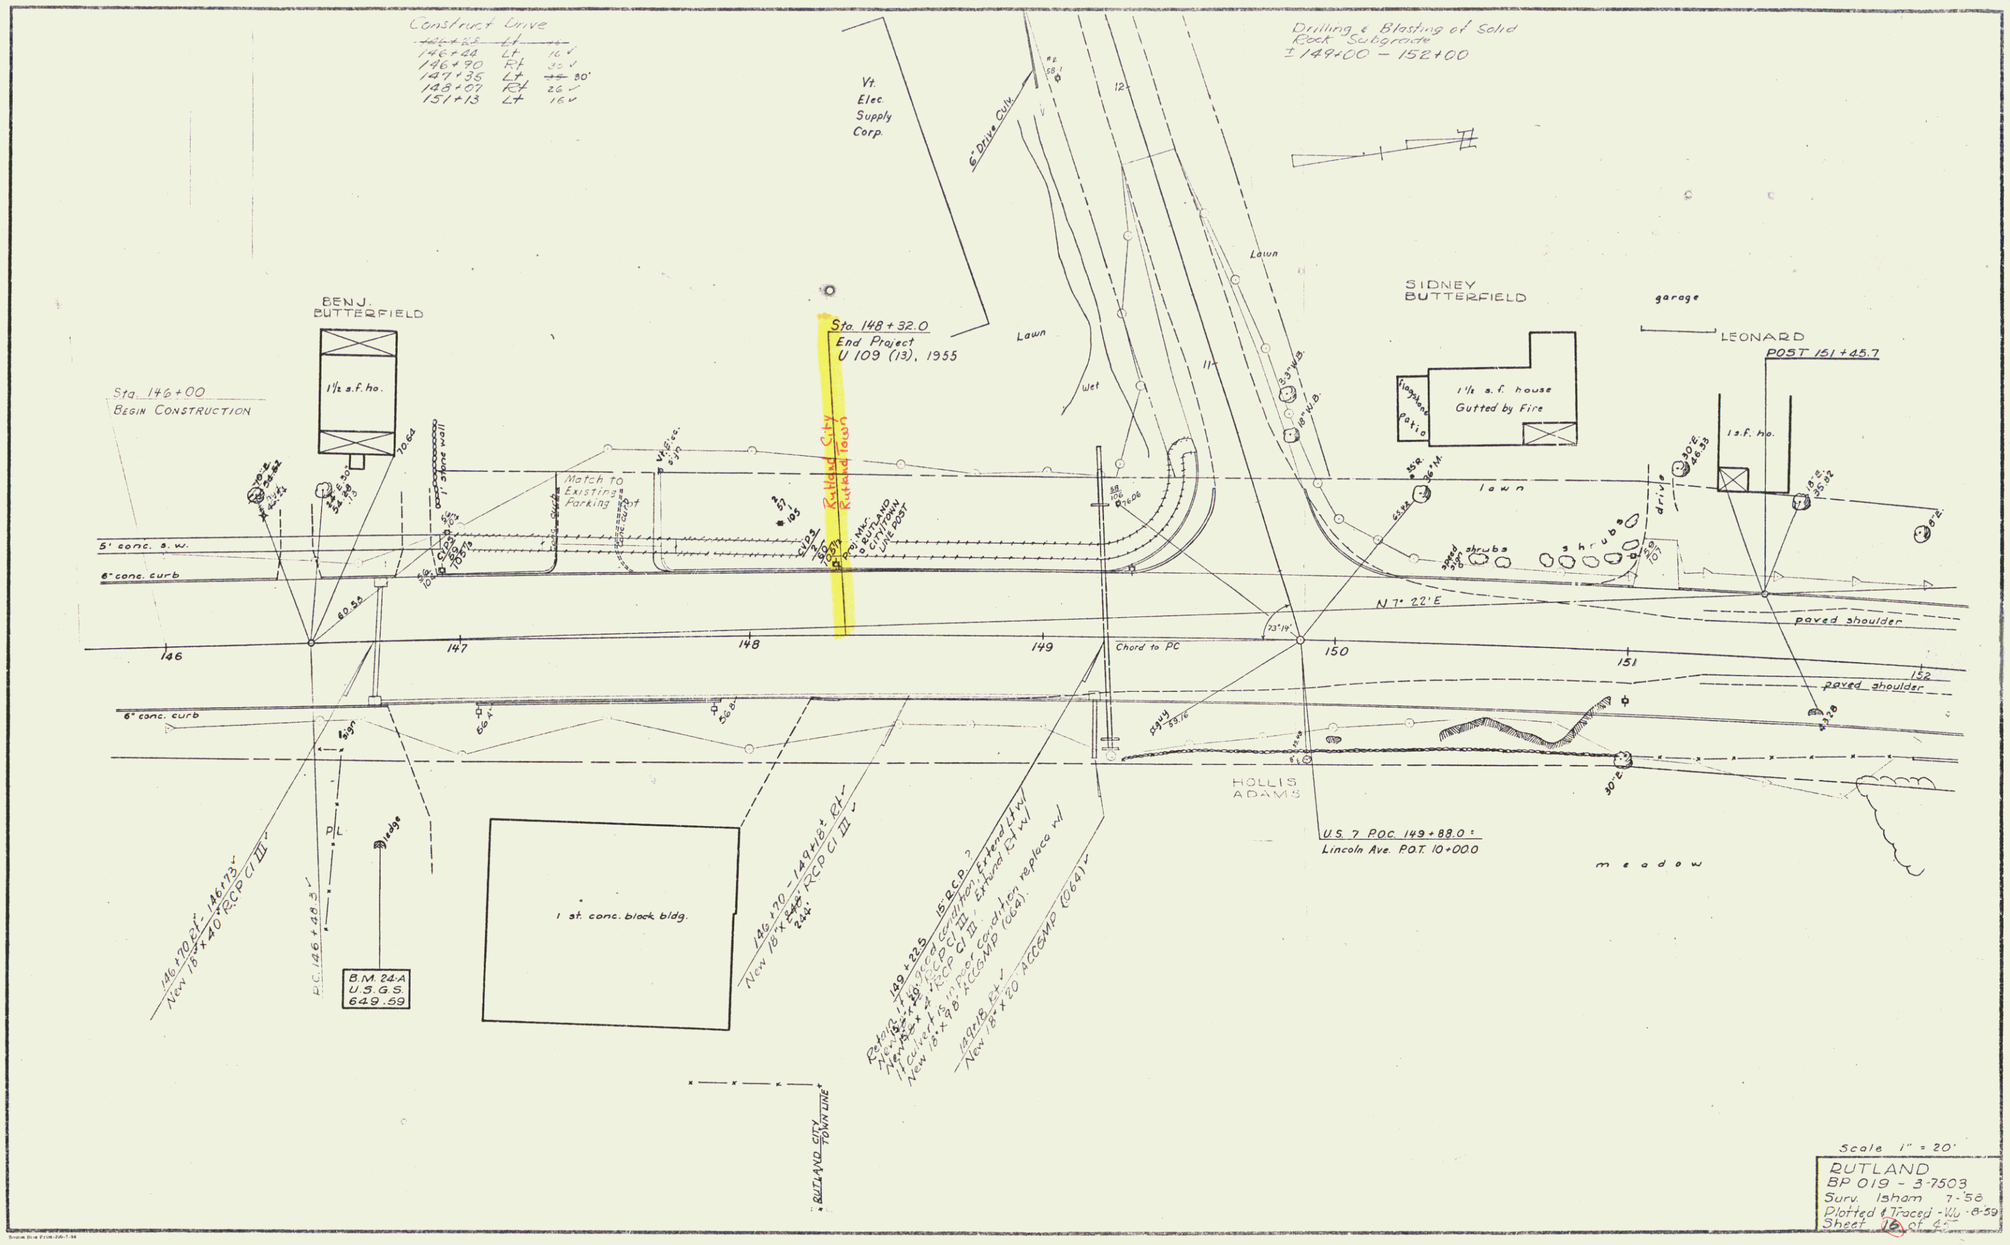
Construct Drive
146+22 Lt 16'
146+90 Rt 30'
147+35 Lt 80'
148+07 Rt 26'
151+13 Lt 16'
Drilling & Blasting of Solid Rock Subgrade
± 149+00 – 152+00
Vt. Elec. Supply Corp.
6" Drive Culv.
Lawn
Wet
BENJ. BUTTERFIELD
1½ s.f. ho.
Sta. 146+00
BEGIN CONSTRUCTION
Sta. 148+32.0
End Project
U 109 (13), 1955
Rutland City
Rutland Town
Match to Existing Parking Lot
5' conc. s.w.
6" conc. curb
SIDNEY BUTTERFIELD
garage
1½ s.f. house
Gutted by Fire
Impound Patio
LEONARD
POST 151+45.7
1 s.f. ho.
drive
lawn
shrubs
N 7° 22' E
paved shoulder
146
147
148
149
150
151
152
Chord to PC
HOLLIS ADAMS
U.S. 7 P.O.C. 149+88.0 ±
Lincoln Ave. P.O.T. 10+000
meadow
146+70 Rt – 146+73
New 18" x 40' RCP Cl III
P.C. 146+48.3
P/L
B.M. 24-A
U.S.G.S.
649.59
1 st. conc. block bldg.
146+70 – 149+16 ± Rt
New 18" x 244' RCP Cl III
149+22.5 15" RCP ?
Remove 1 ft. of RCP ?
New 15" x 19' RCP Cl III
Extend Lt wl
New 15" x 2 RCP Cl III
Extend Rt wl
New 18" x 18' ACCMP (064)
149+18 Rt ±
New 18" x 20' ACCMP (064)
RUTLAND CITY TOWN LINE
Scale 1" = 20'
RUTLAND
BP 019 - 3-7503
Surv. Isham 7-58
Plotted & Traced - WJ - 8-59
Sheet 16 of 47

2