



NEW RAIN CONCRETE PIPE CULVERTS REQUIRED
 STATION CURVE DIAM. LENGTH
 24+80 12' 30'

DRIVEWAY PIPE CULVERTS REQUIRED
 STATION CURVE DIAM. LENGTH
 24+80 12' 30'



109A 1931 5 192

WOOD GUIDE POSTS
 STA. LEFT RIGHT
 18450

CURVE #2
 R 14327
 T 1392
 L 2775
 E 67

PLAN
 DATE 11/12/31
 DRAWN BY C.E. BROWN
 CHECKED BY C.E. BROWN

PROFILE
 DATE 11/12/31
 DRAWN BY C.E. BROWN
 CHECKED BY C.E. BROWN

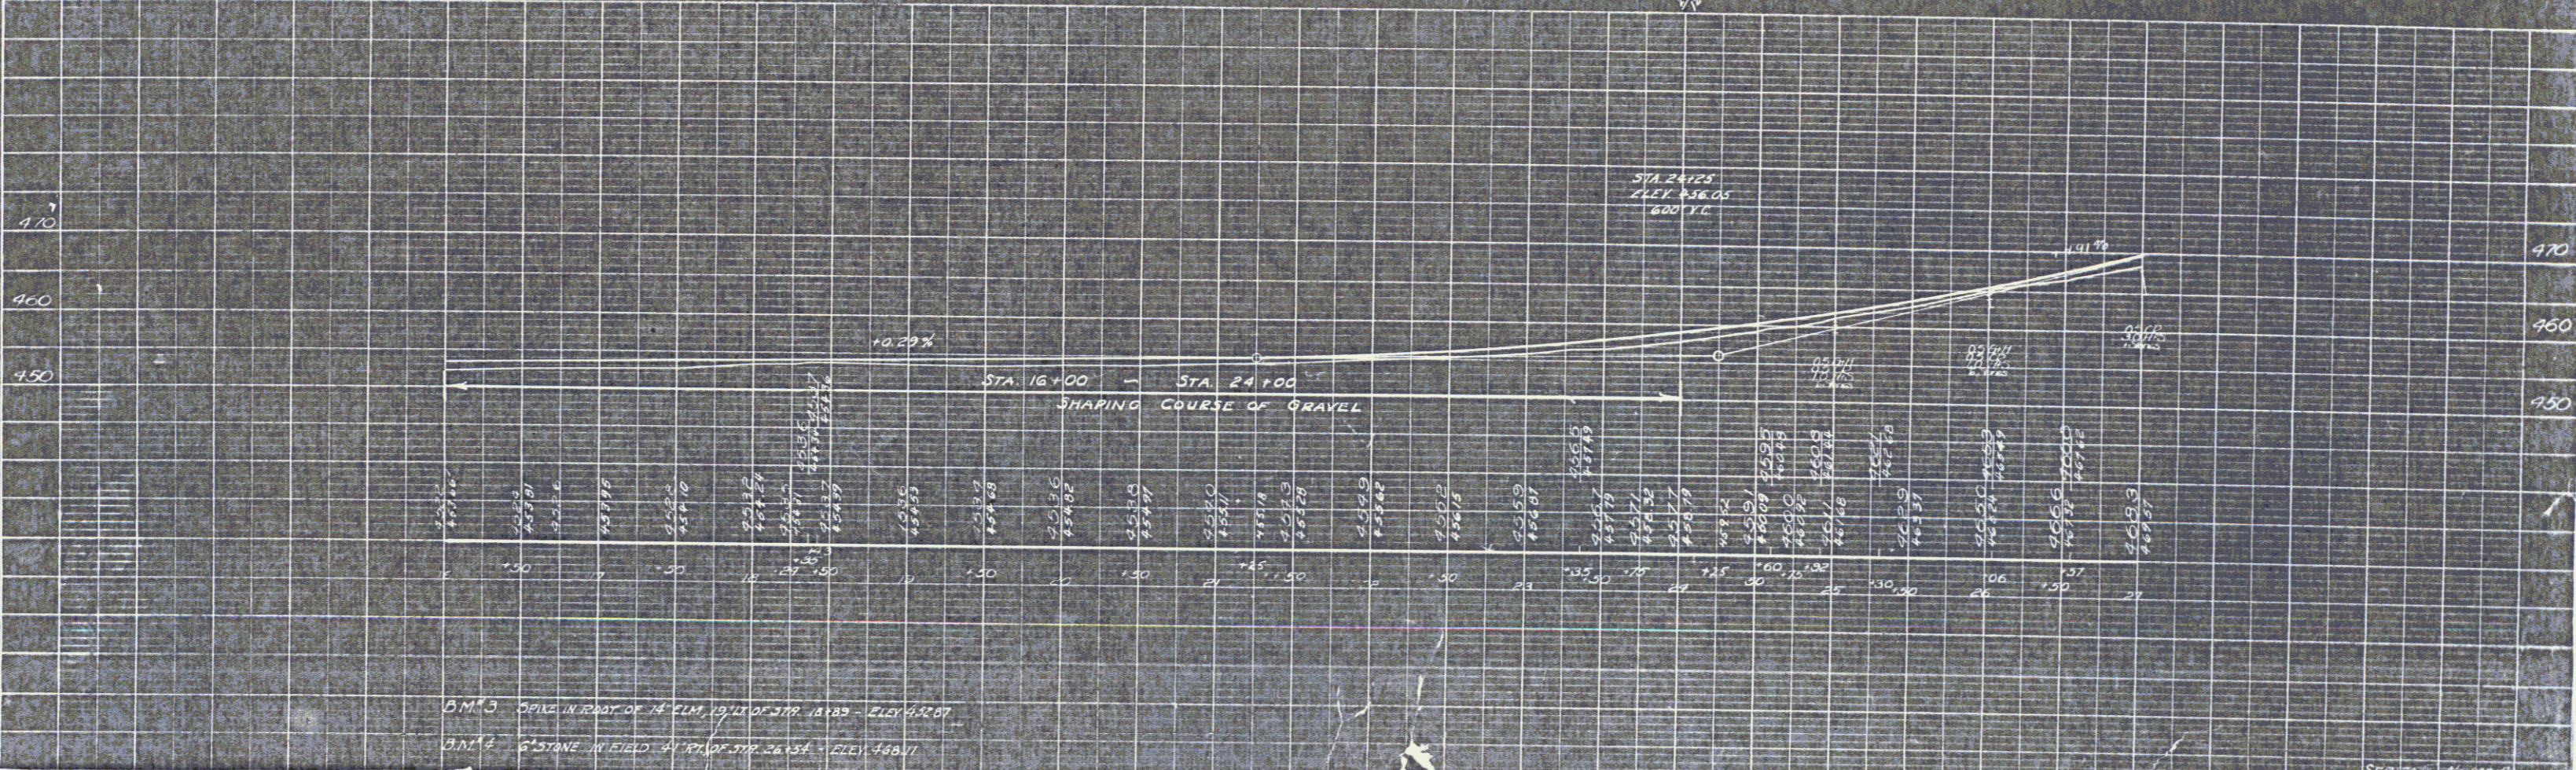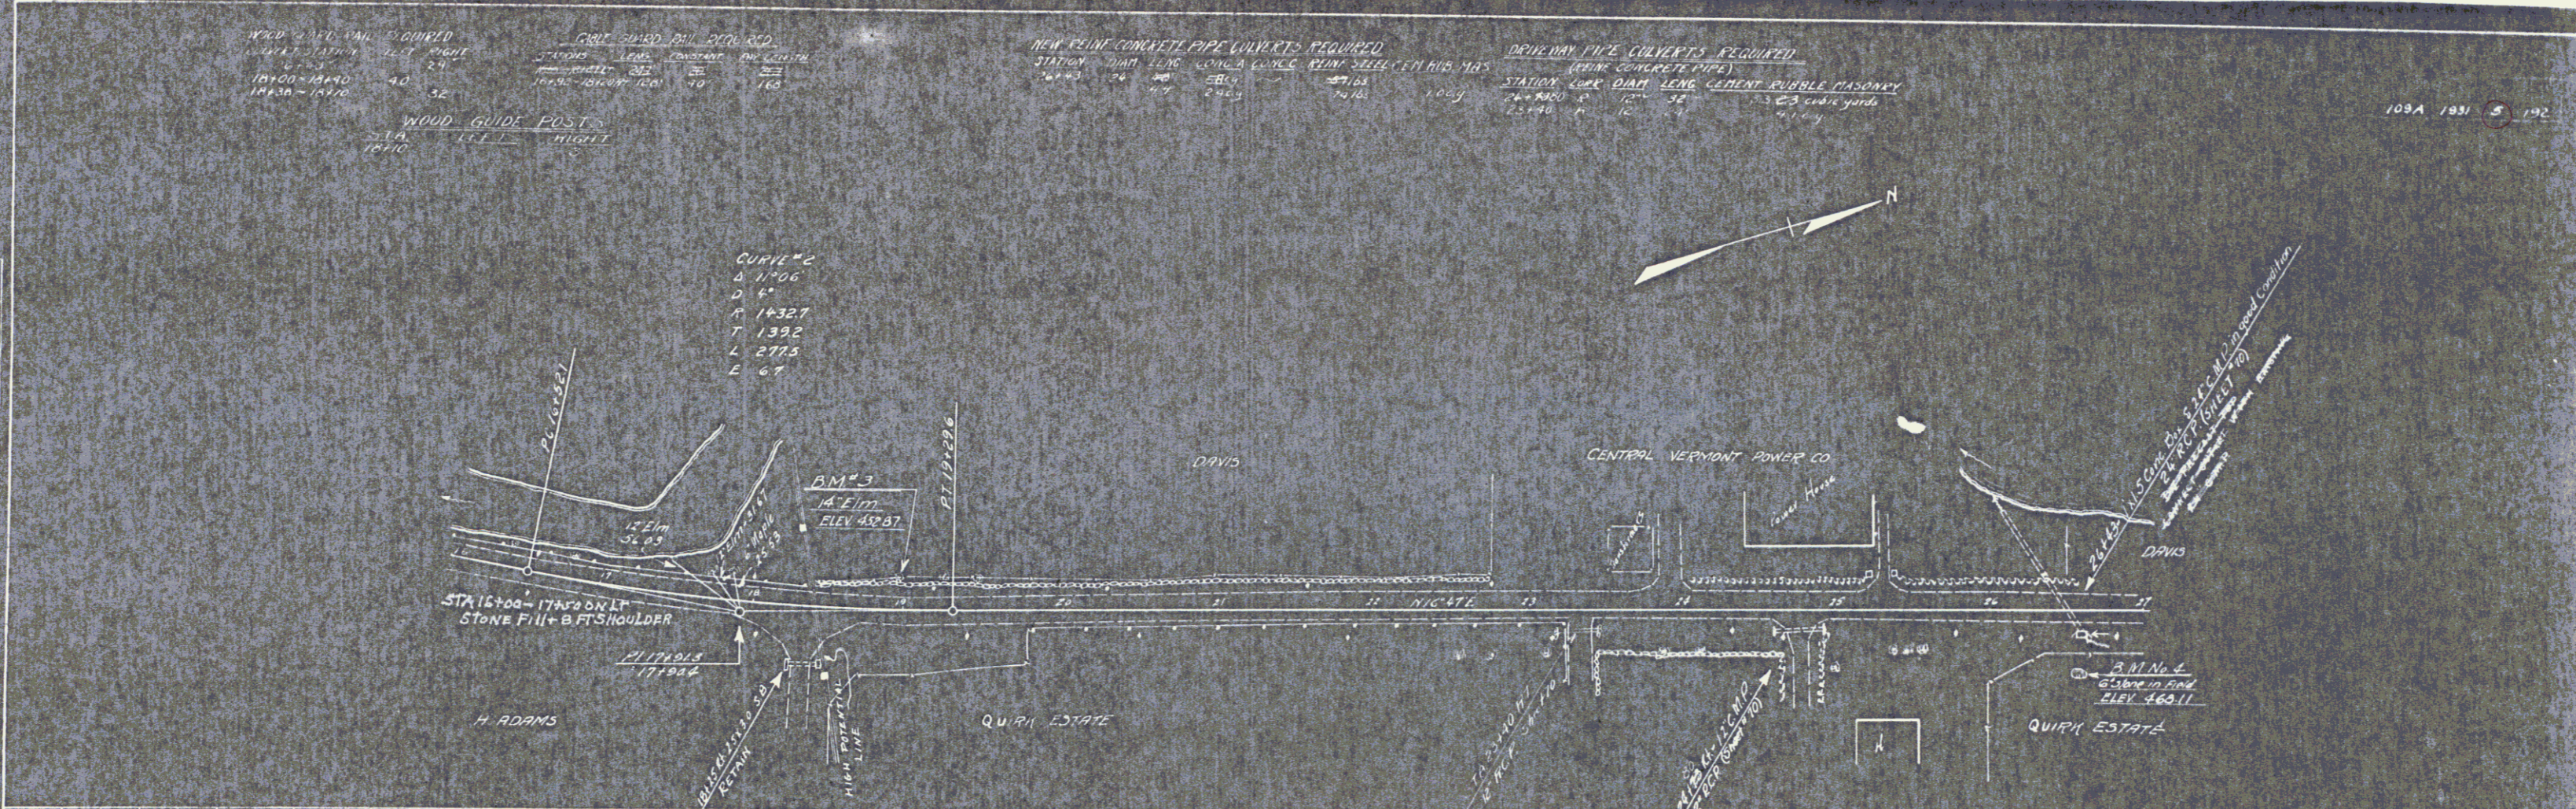


109A 1931

Sheet 5
 2