

WOOD GUARD RAIL REQUIRED
CURRENT STATION LEFT RIGHT

107900	107716	12
107900	107710	20



NEW SPIN CEMENT PIPE CULVERTS REQUIRED

STATION	DIAM	LENS	CONC. A CONC. B	EXTRA STEEL
107900	24"	20'	1.0	1.0

DRAINAGE PIPE CULVERTS REQUIRED
(CONCRETE PIPE)

STATION	LENS	CONC. A CONC. B	EXTRA STEEL
107900	20'	1.0	1.0


STANDARD UNDERPAVING REQUIRED
16" P.C. STRENGTH

STATION	LENGTH	CEMENT RUBBLE MASONRY
118+89	123+00	4.11


SIDE DRAINS

STA	LEN	FLY
107900	10'	14'

103 A JAN 21 192

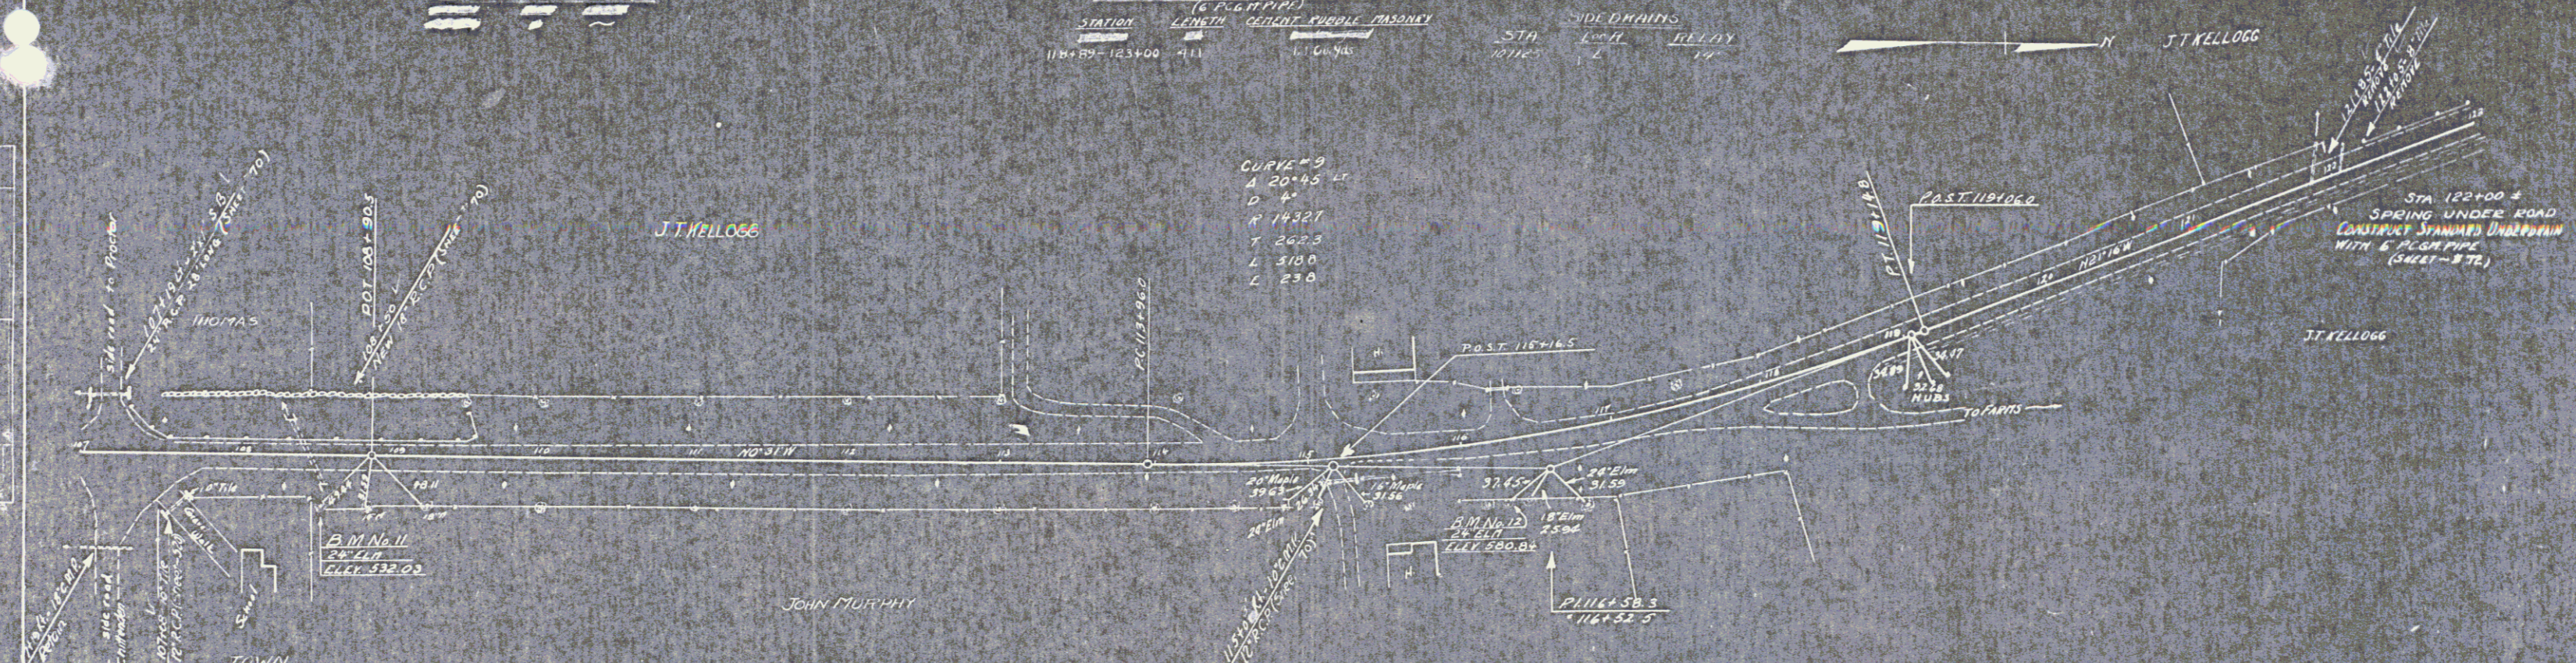

CURVE #9
A 20+45 LT
D 4"
R 14327
T 262.5
L 310.0
L 23.0

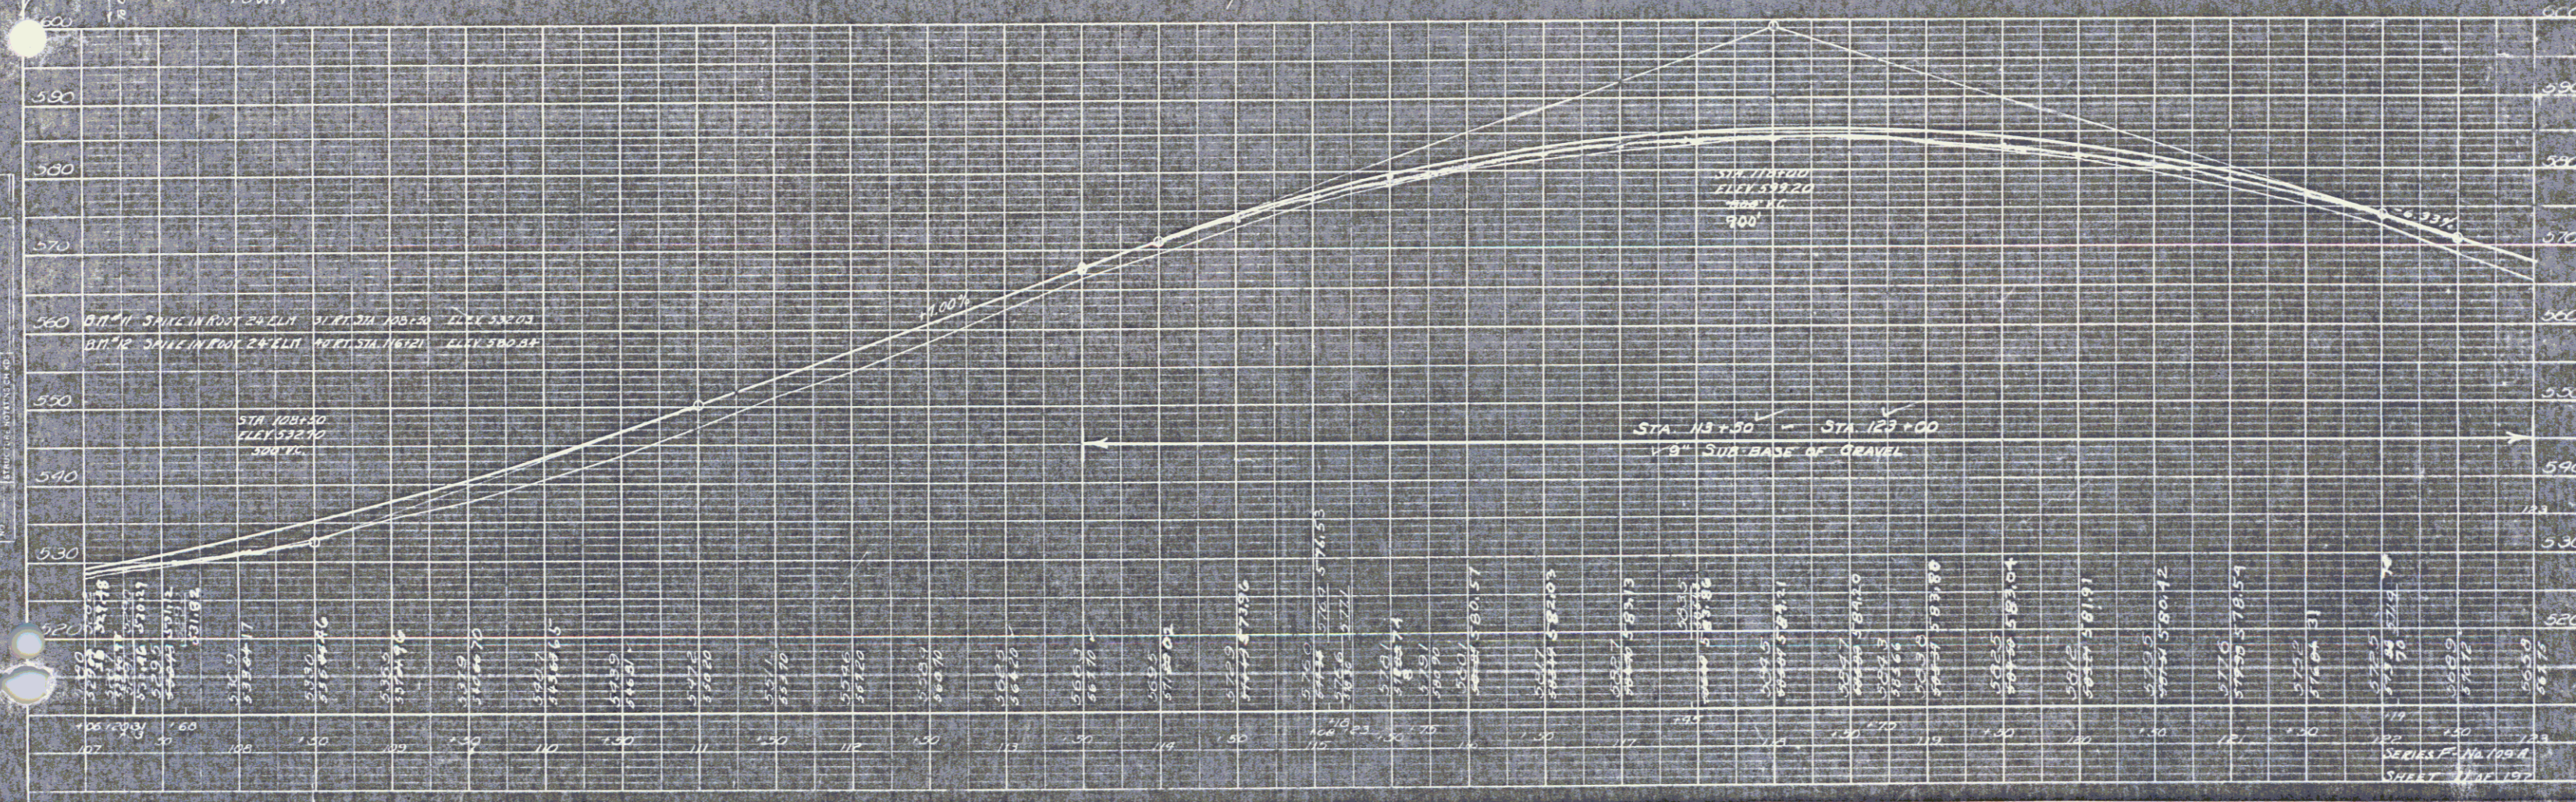





