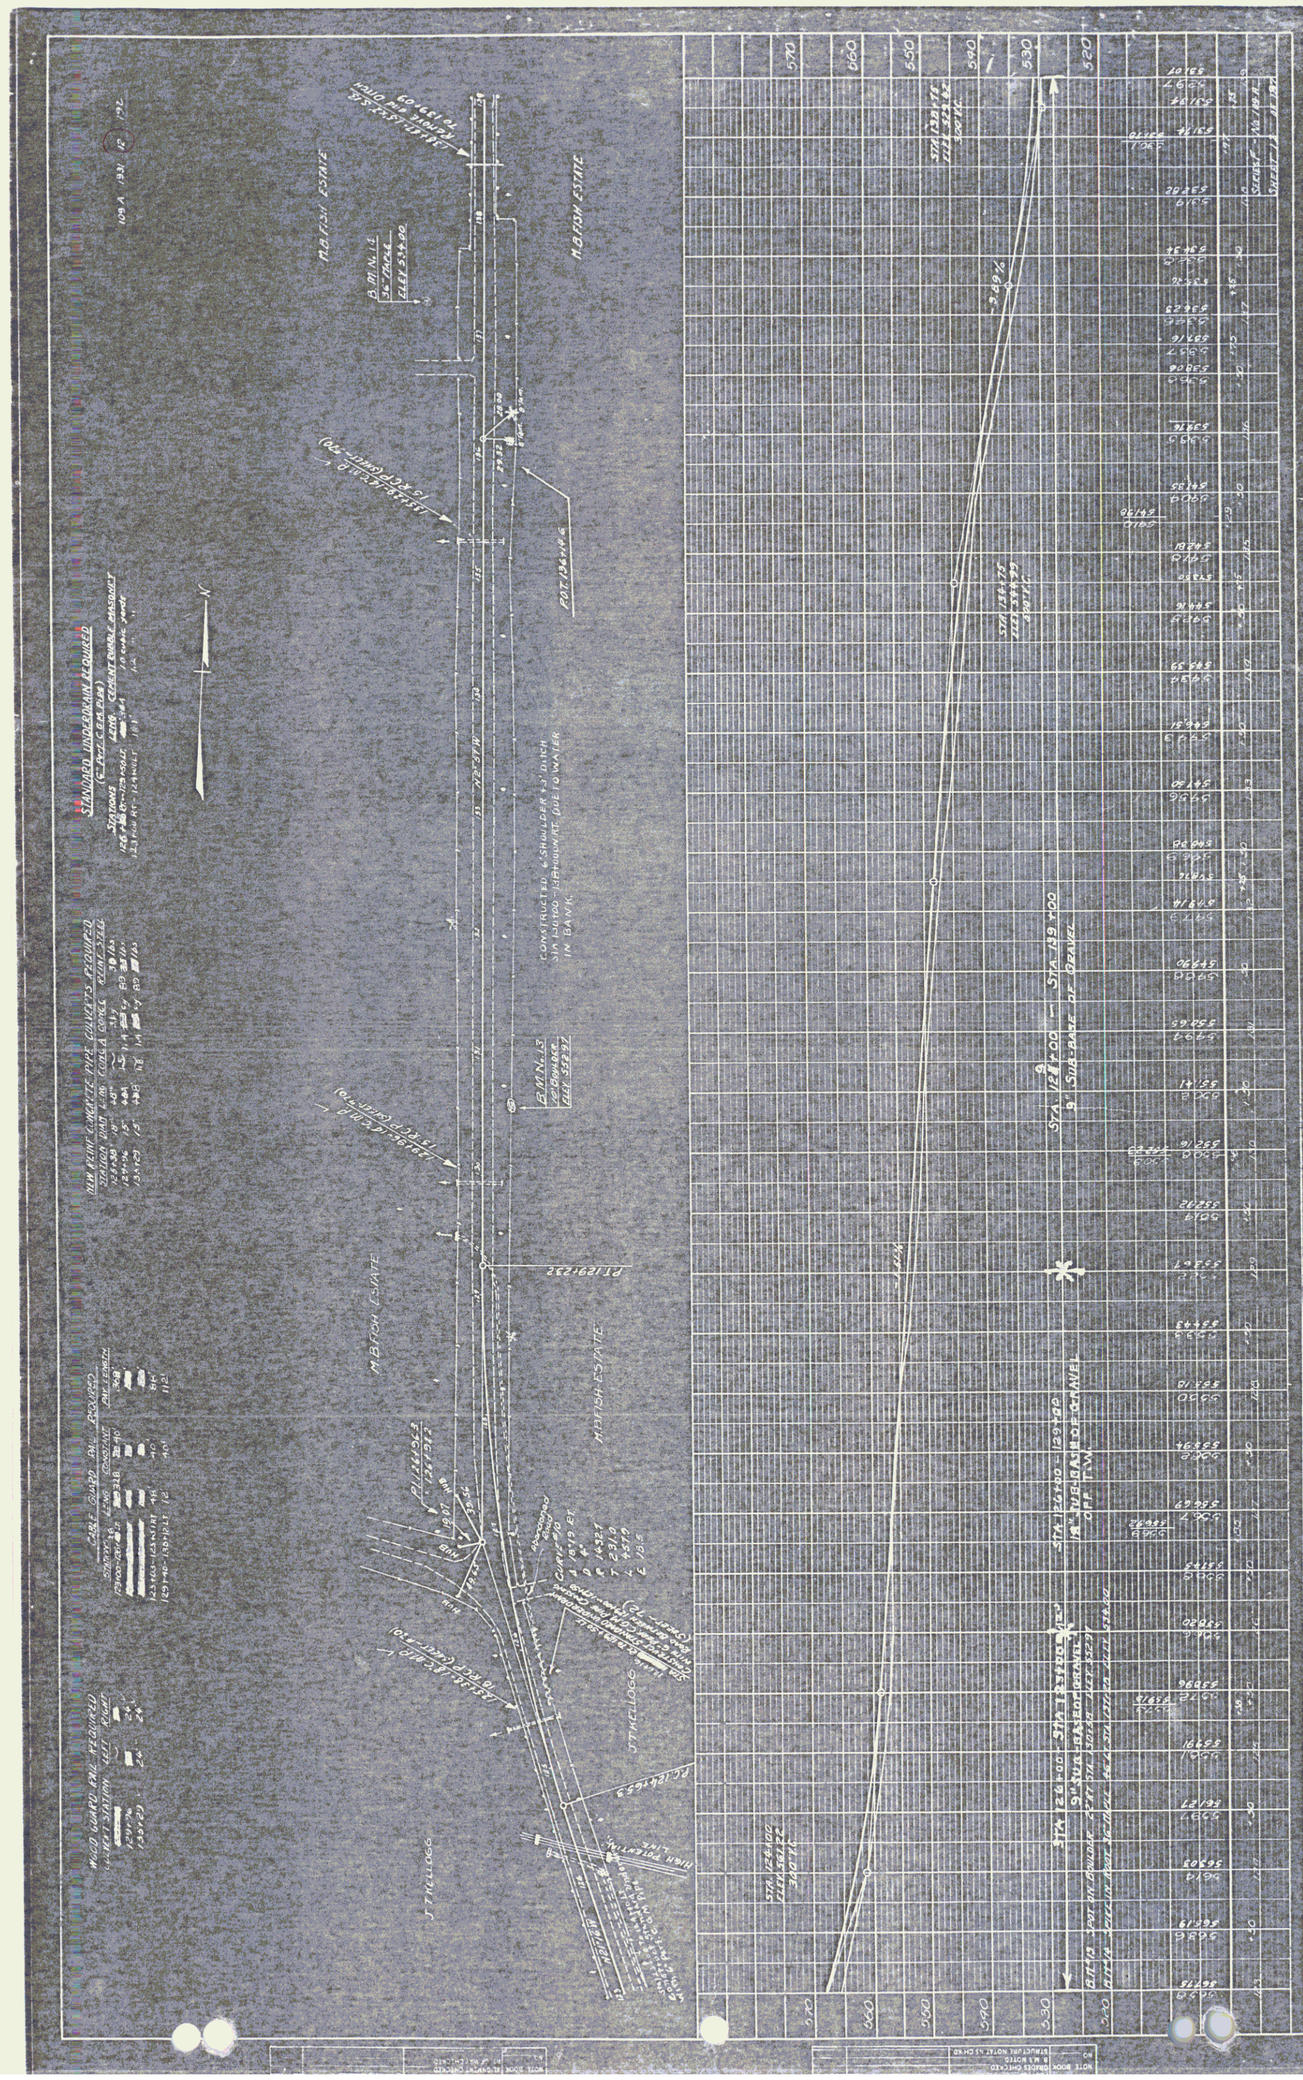
STANDARD UNDERDRAIN PLACEMENT
(CL PAVEMENT)
NW PIPE CULVERTS PROVIDED
CAST QUAD AN PROVIDED
WOOD QUARD RAIL PROVIDED
M.B. FOX ESTATE
M.B. FOX ESTATE
M.BITCH ESTATE
MARSH ESTATE
J.T. McLLOGG
J.T. McLLOGG
CONSTRUCTED 6' SHOULDER + 3' DITCH
SIN PIPED - SEPARATE DUE TO WATER
IN BANK.
PLOT SAVING
N
STA 126+00 - STA 129+00
6' SHOULDER PAVEMENT
STA 126+00 - 129+00
PAVEMENT
