








REV. CURVE #16

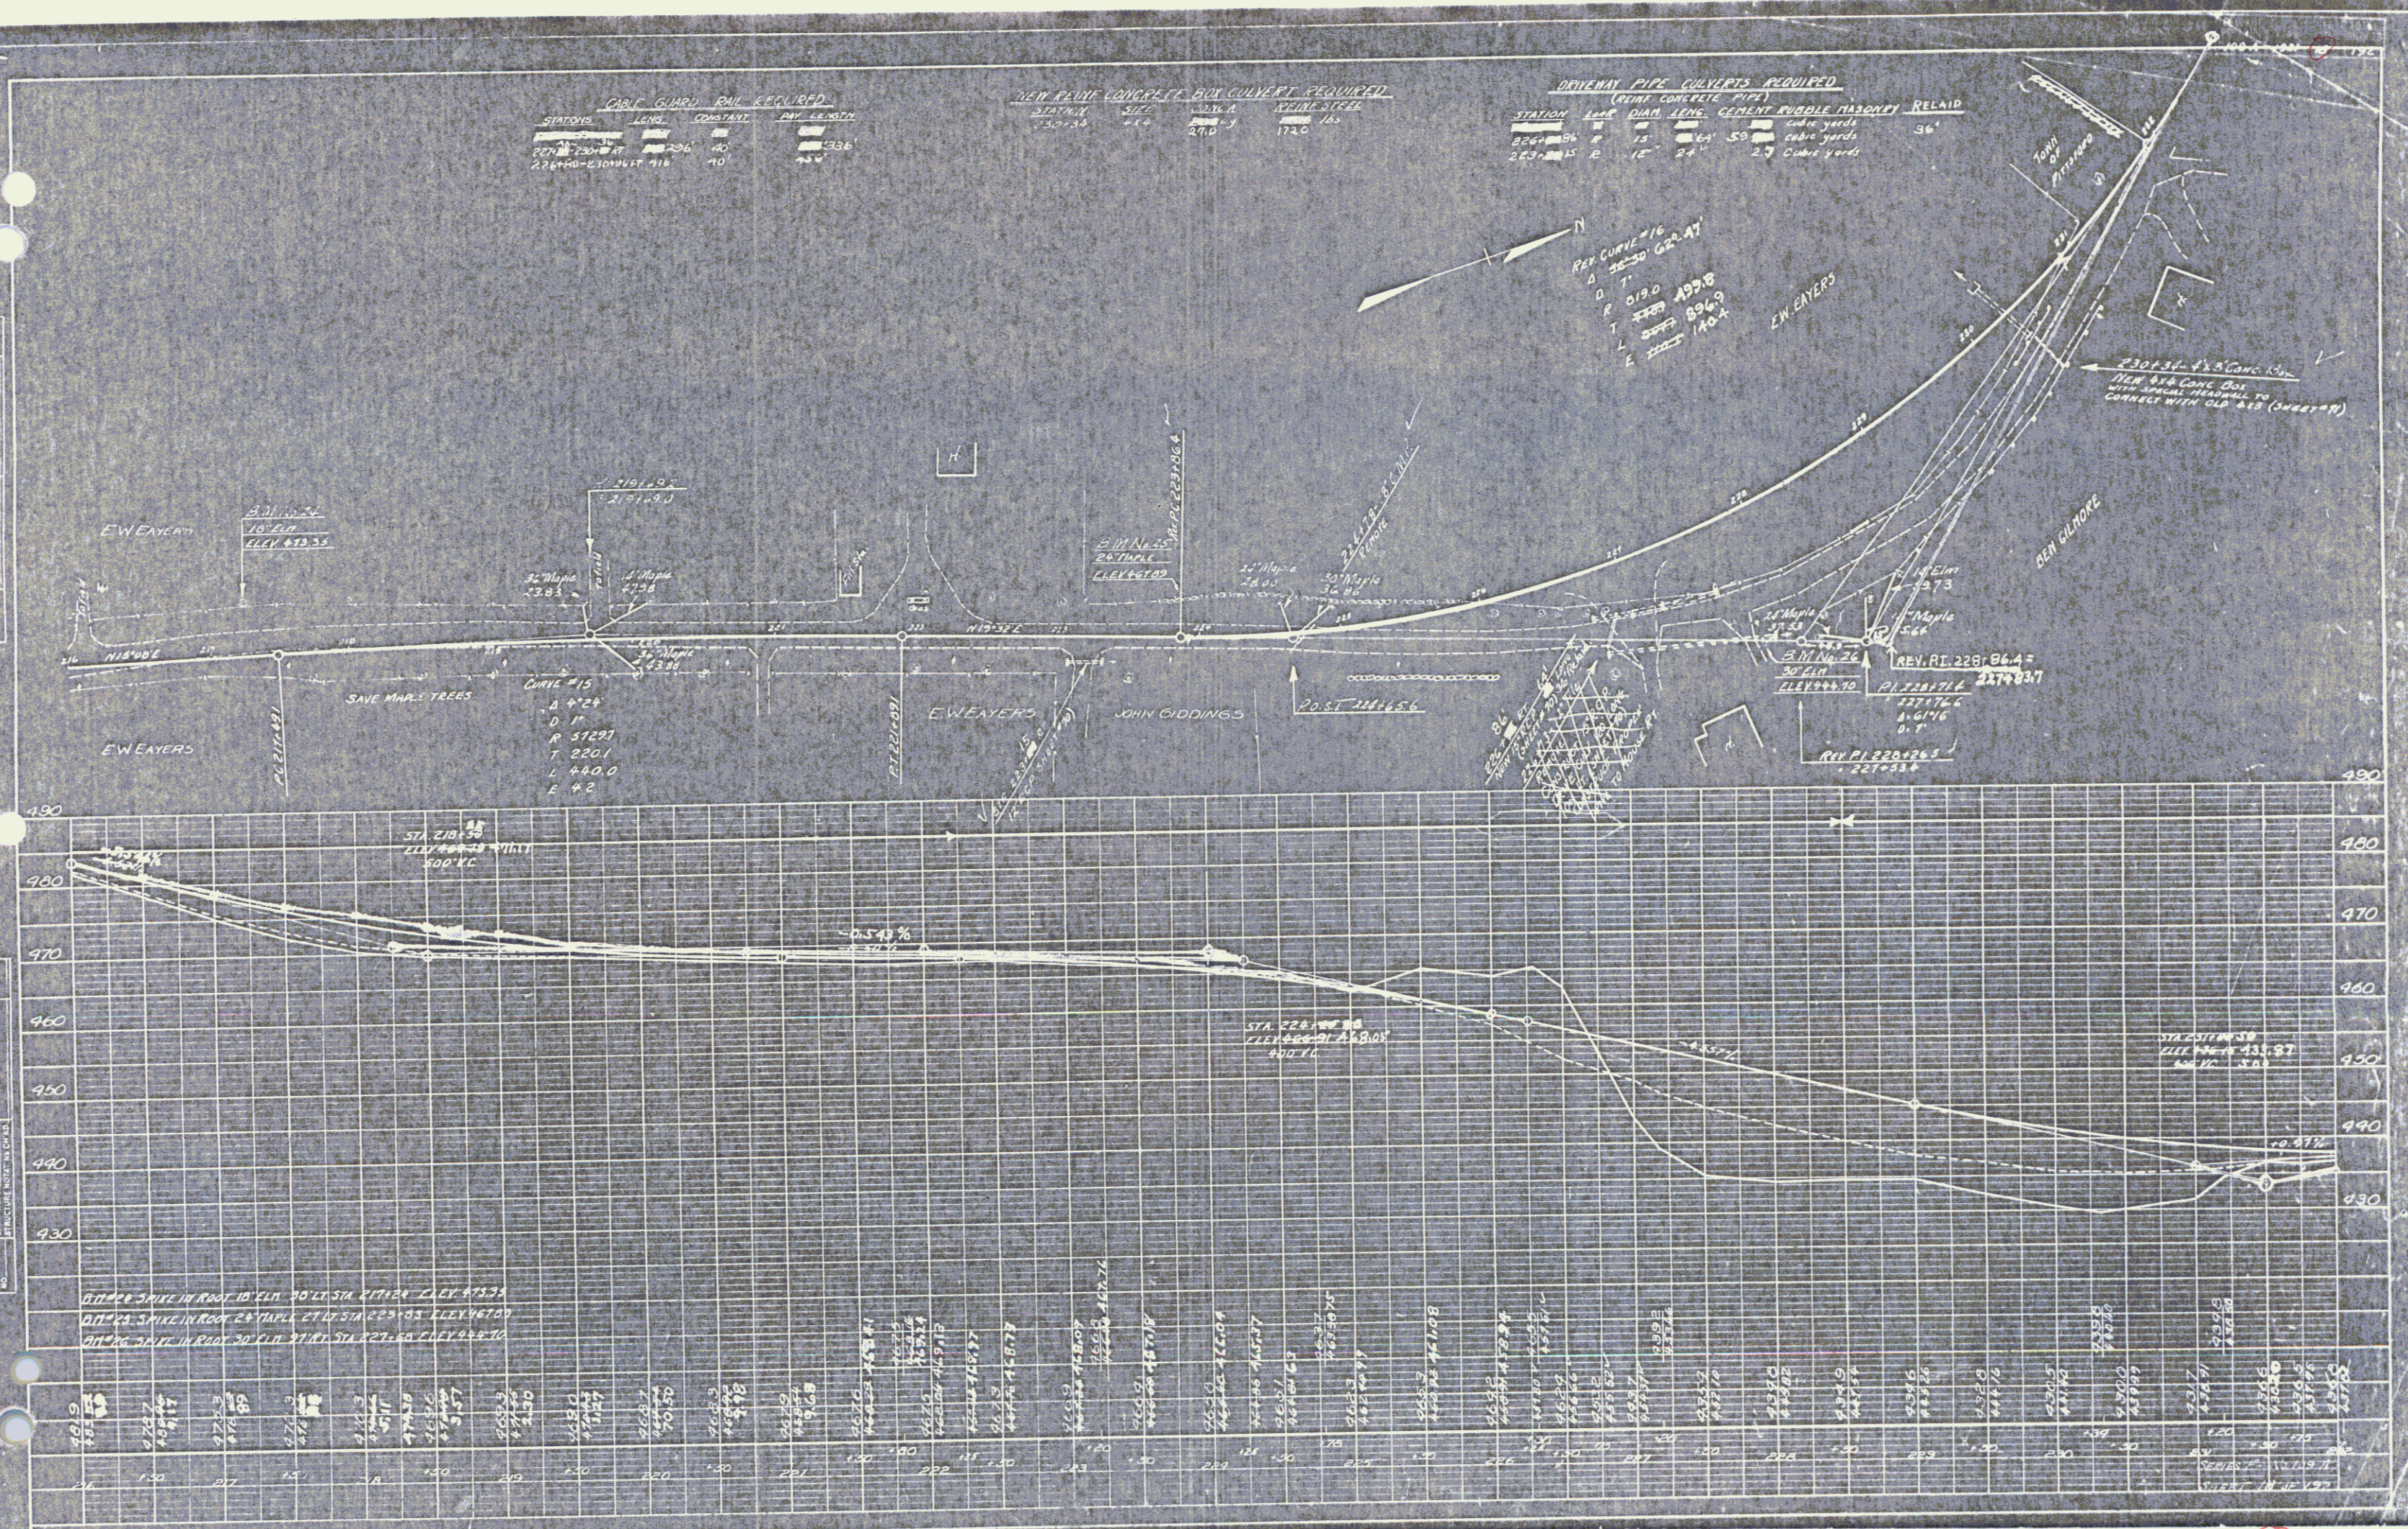


