FED. ROAD DIST. NO.	STATE	FED. AID PROJECT NO.	SHEET NO.	TOTAL SHEETS
9	VT.	109 A 1931	29	192

WOOD GUARD RAIL REQUIRED

Culvert Sta.	Left	Right
383+80	24'	24'
390+60	24'	24'

NEW REINF. CONCRETE PIPE CULVERTS REQUIRED

Station	Diam.	Leng.	Conc. A	Conc. C	Reinf. Steel
390+60	15"	40'		23cy	331lbs.

CULVERT REPAIRS REQUIRED

Station	Type	Extension	Conc. A	Reinf. Steel
383+80	2x3	4'Rt. 6'Lt.	84cy	609lbs.

DRIVEWAY PIPE CULVERTS REQUIRED
(Reinf. Conc. Pipe)

Station	Lor R	Diam.	Leng.	Cement	Rubble Masonry
386+50	L	15"	32'	26cy	
387+75	R	15"	32'	26cy	

Parcel	Kind of Instrument	Date of Instrument	Grantor	Grantee	Recorded Filed and Book Page	Date	Remarks
A	QCD.	5-9-31	J.G.&M.Shelvey	St. of Vt.	A1 123-120	5-28-31	

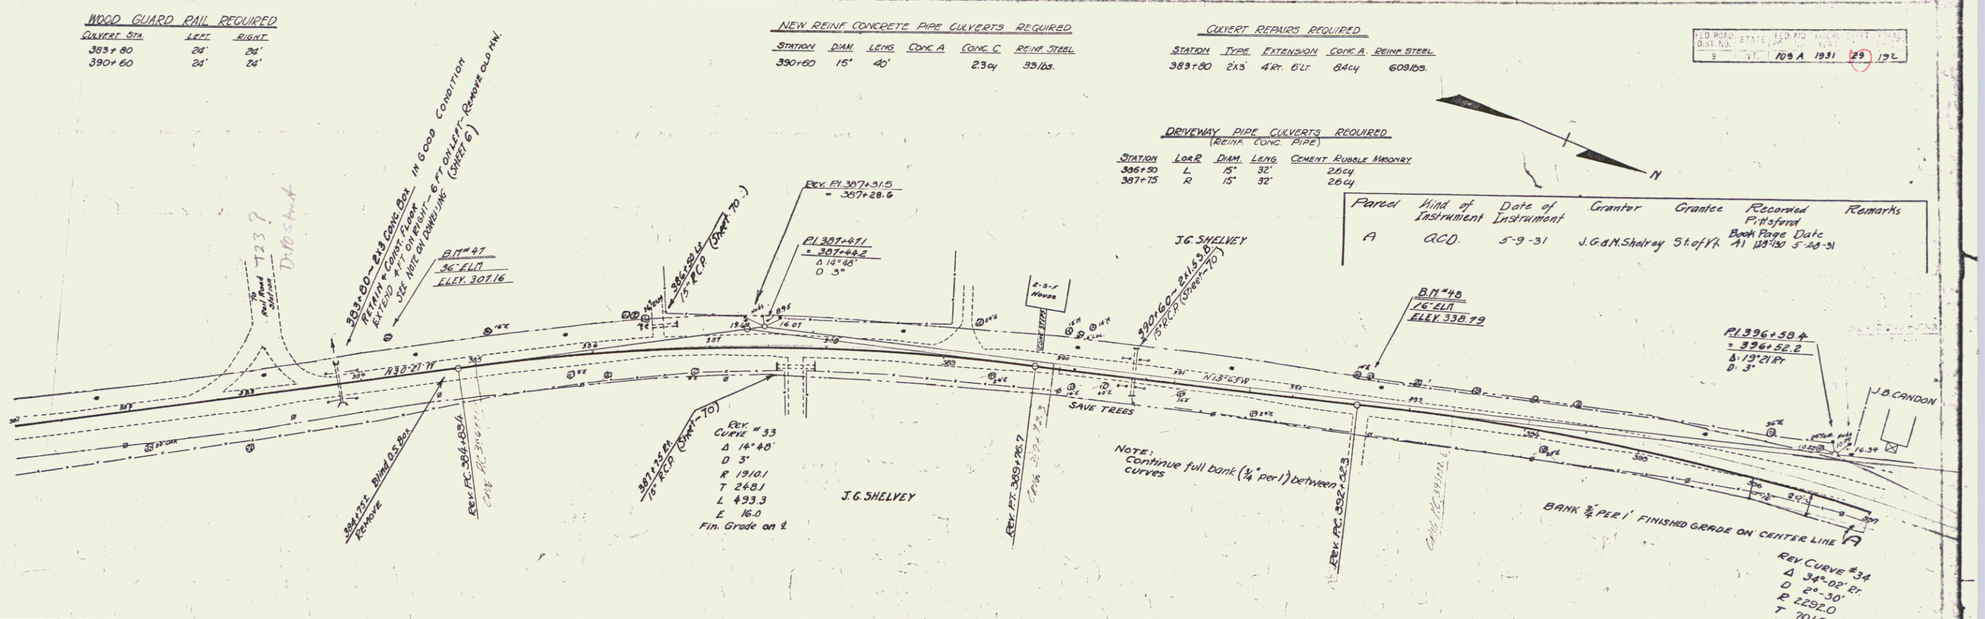

31