FED. AID STATE ROAD PROJECT
BRIDGE NO. | STATE ROAD NO. | TOTAL SHEETS
109 A 1931 31 192

WOOD GUARD RAIL REQUIRED

Culvert Sta.	Left	Right
423+32	24'	24'

Parcel	Kind of Instrument	Date of Instrument	Grantor	Grantee	Recorded Pittsford Book Page	Date	Remarks
Culv. #1	QC.D.	7-17-31	Mary L. Holden et al	St. of Vt.	A1 183-3	7-17-31	Culv. Sta. 423+32

NEW REINF. CONCRETE PIPE CULVERTS REQUIRED

Station	Diam.	Leng.	Conc. A	Conc. C	Reinf. Steel
423+32	24"	48'	2.4 cy.	~	341 lbs.

DRIVEWAY PIPE CULVERTS REQUIRED

Station	Lor R	Diam.	Leng.	Reinf. Conc. Pipe Cement	Rubble Masonry
414+50	L.	12"	28'	2.3 cy.	
425+50	R.	15"	28'	2.6 cy.	

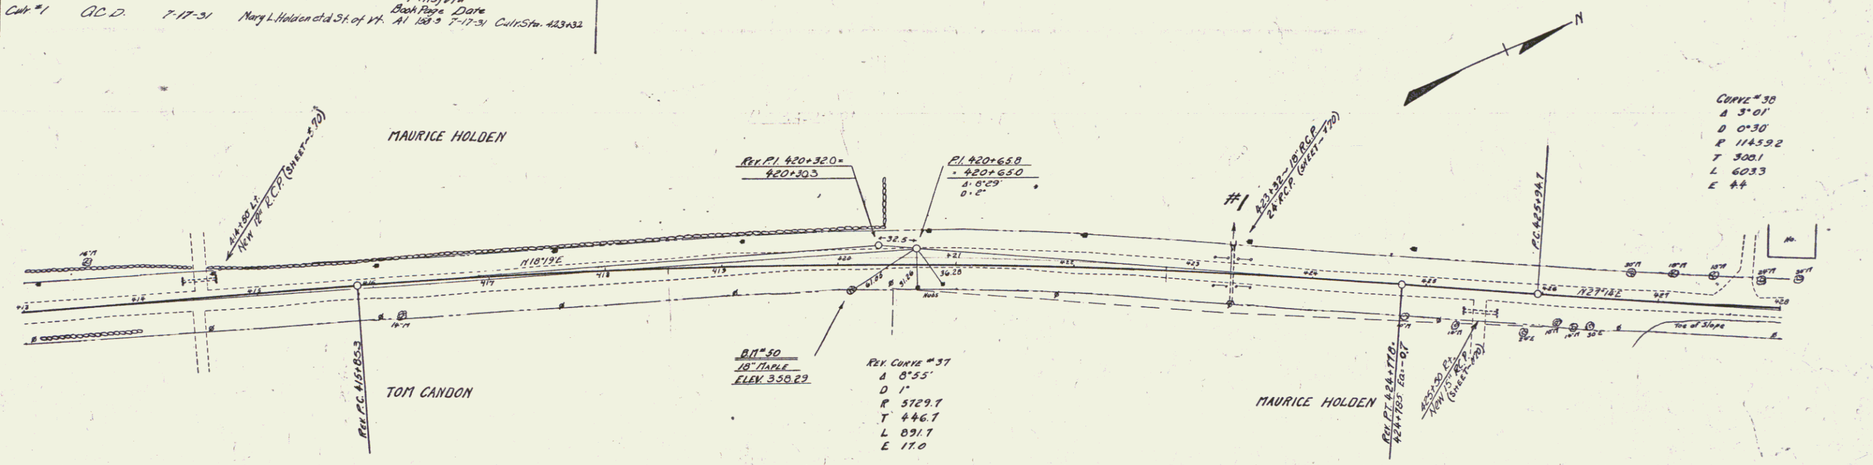

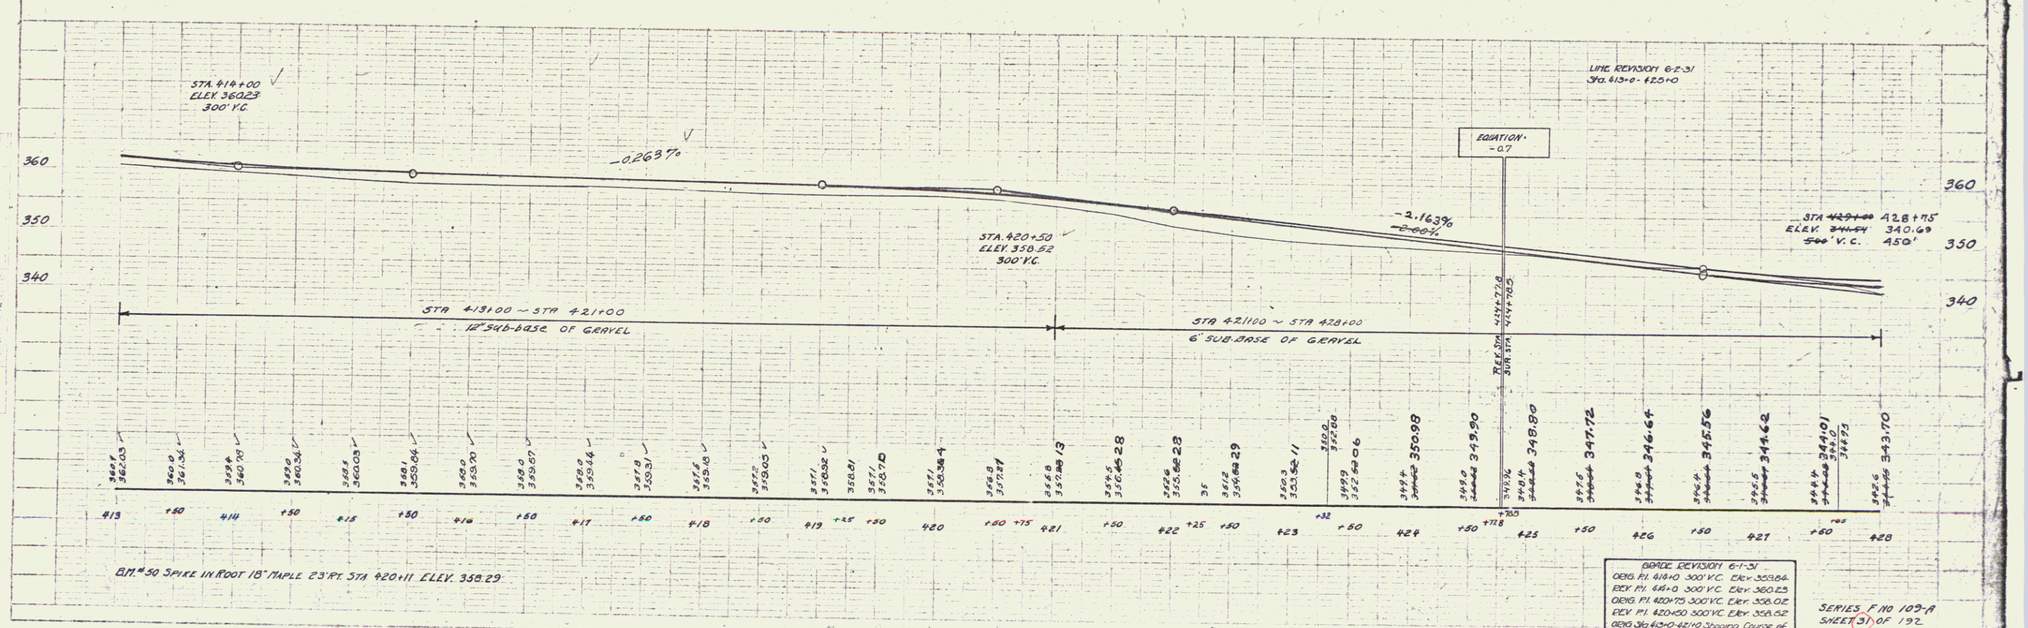

Series F110 109-A
Sheet 31 of 192

33