FED. ROAD DIST. NO.	STATE	FED. AID PROJ. NO.	FISCAL YEAR	SHEET NO.	TOTAL SHEETS
9	VT.	109A	1931	44	192

WOOD GUARD RAIL REQUIRED

CULVERT STATION	LEFT	RIGHT
623+95	24'	24'

NEW REINF. CONCRETE PIPE CULVERTS REQUIRED

STATION	DIAM.	LENG.	CONC. A	CONC. C	REINF. STEEL
623+95	15"	40'	—	2.3 cy.	33 lbs.

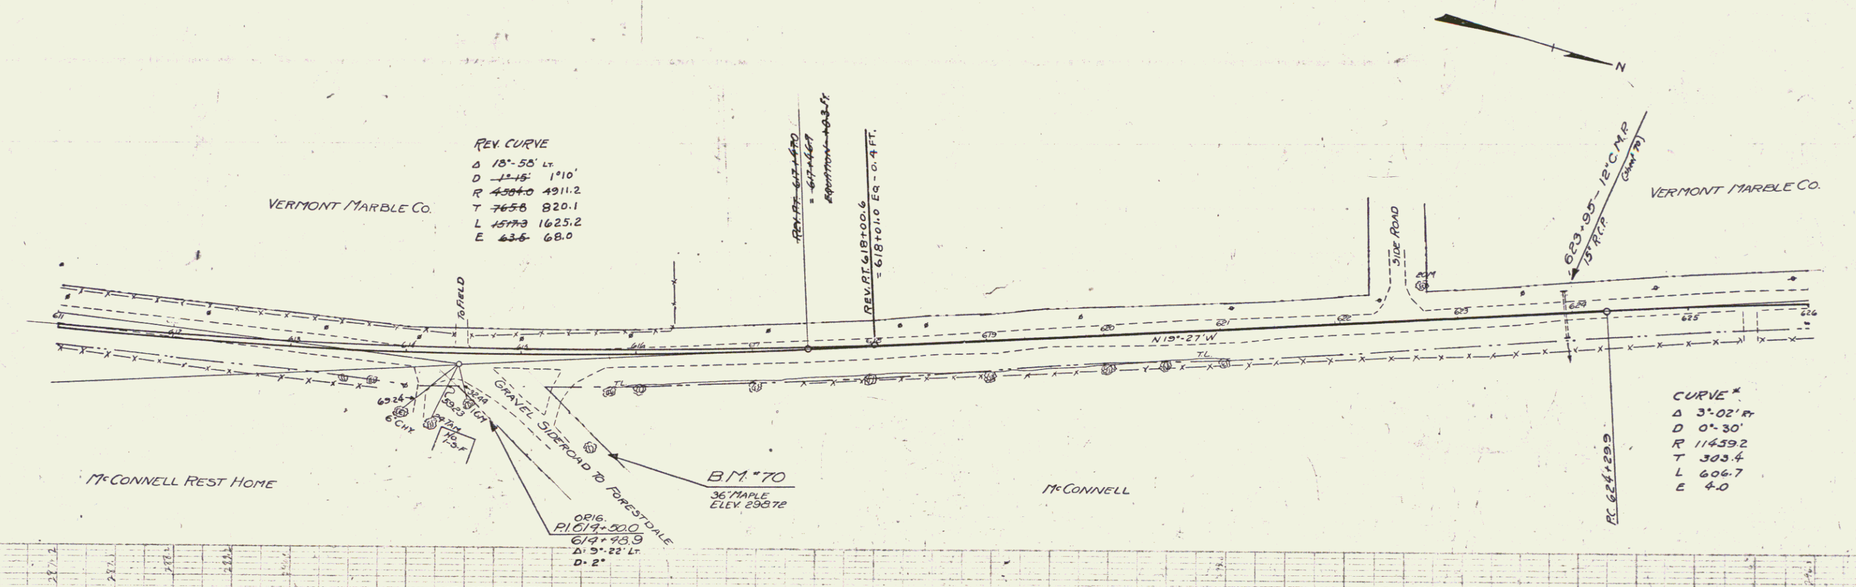

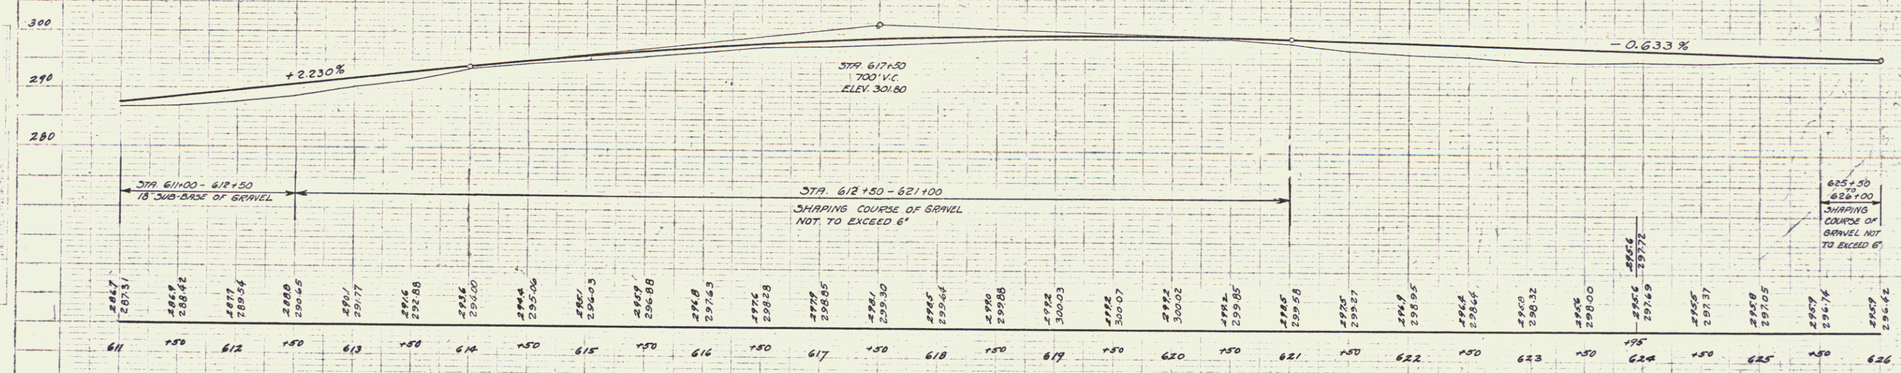

B.M. "70 SPIKE IN ROOT 36" MAPLE 75' Rt. 615+60 ELEV. 298.72

SERIES F. NO. 109-A
SHEET 44 OF 192

46