FED. AID PROJ. NO.	STATE	FED. AID FISCAL YEAR	SHEET	TOTAL SHEETS
	VT.	109-A 1931	62	192

CABLE GUARD RAIL REQUIRED

STATIONS	LENG.	CONSTANT	PAY LENGTH
874+00 - 875+30 Lt.	130'	20'	150'
874+00 - 875+30 Rt.	130'	20'	150'

CULVET REPAIRS REQUIRED

STATION	EETENSION	CONC. A	REINF. STEEL
874+22	5 FT. RT. - 5 FT. LT.	17.9 C.Y.	1269 lbs.

DRIVEWAY PIPE CULVERTS REQUIRED
(REINF. CONC. PIPE)

STATION	L or R	DIAM.	LENG.	CEMENT RUBBLE MASONRY
885+95	Rt.	12"	24'	2.3 c.y.
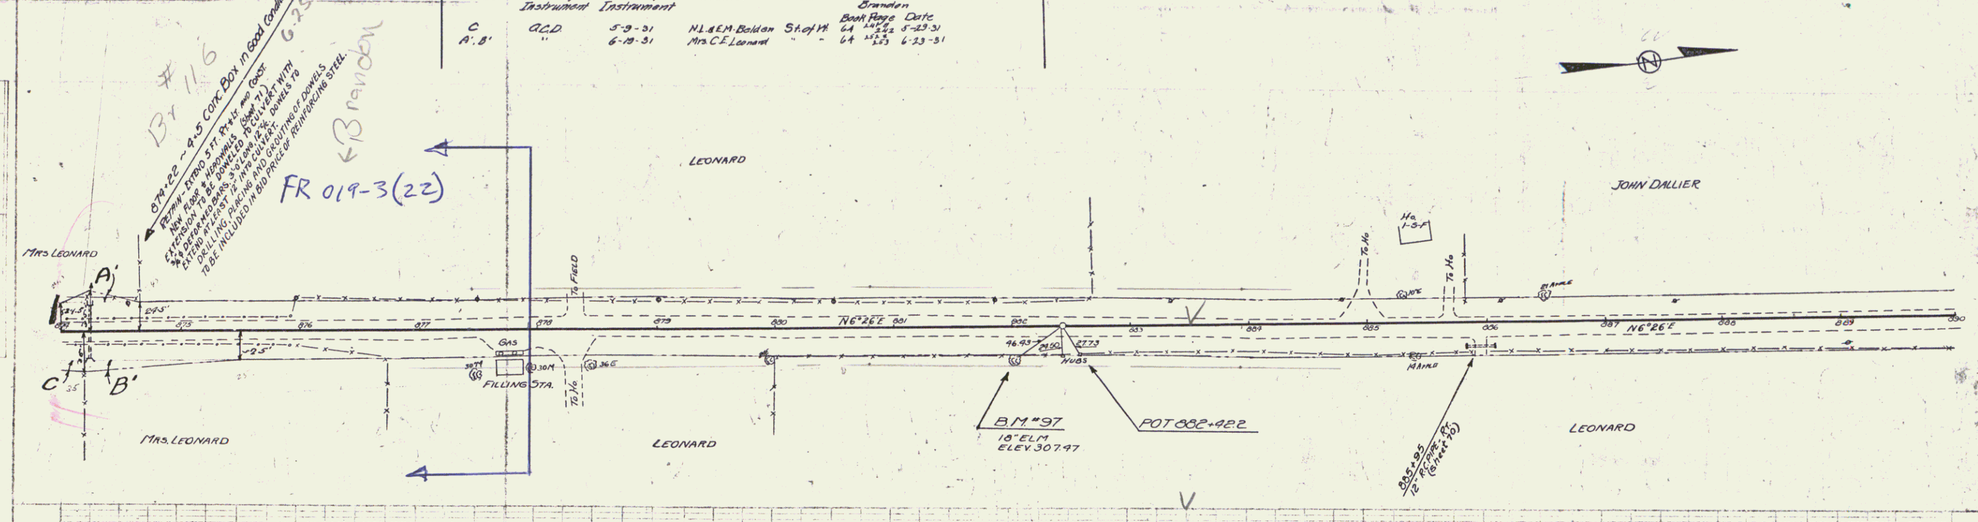
Parcel	Kind of Instrument	Date of Instrument	Grantor	Grantee	Recorded Grantee Book	Page	Date	Remarks
C	G.C.D.	5-9-31	N.L. & E.M. Baldan	St. of Vt.	64	122	5-23-31	
A', B'	"	6-19-31	Mrs. C.E. Leonard	" "	64	123	6-23-31