FED. HWY. DIST. NO.	STATE	FED. AID PROJ. NO.	FISCAL YEAR	SHEET NO.	TOT. SHTS.
9	VT.	109A	1931	63	192

WOOD GUARD RAIL REQUIRED

CULVERT STATION	LEFT	RIGHT
890+20	24'	24'

NEW REINF. CONCRETE PIPE CULVERTS REQUIRED

STATION	DIAM.	LENG.	CONC. A	CONC. C	REINF. STEEL
890+20	18"	32'	—	3.0	33 lbs.

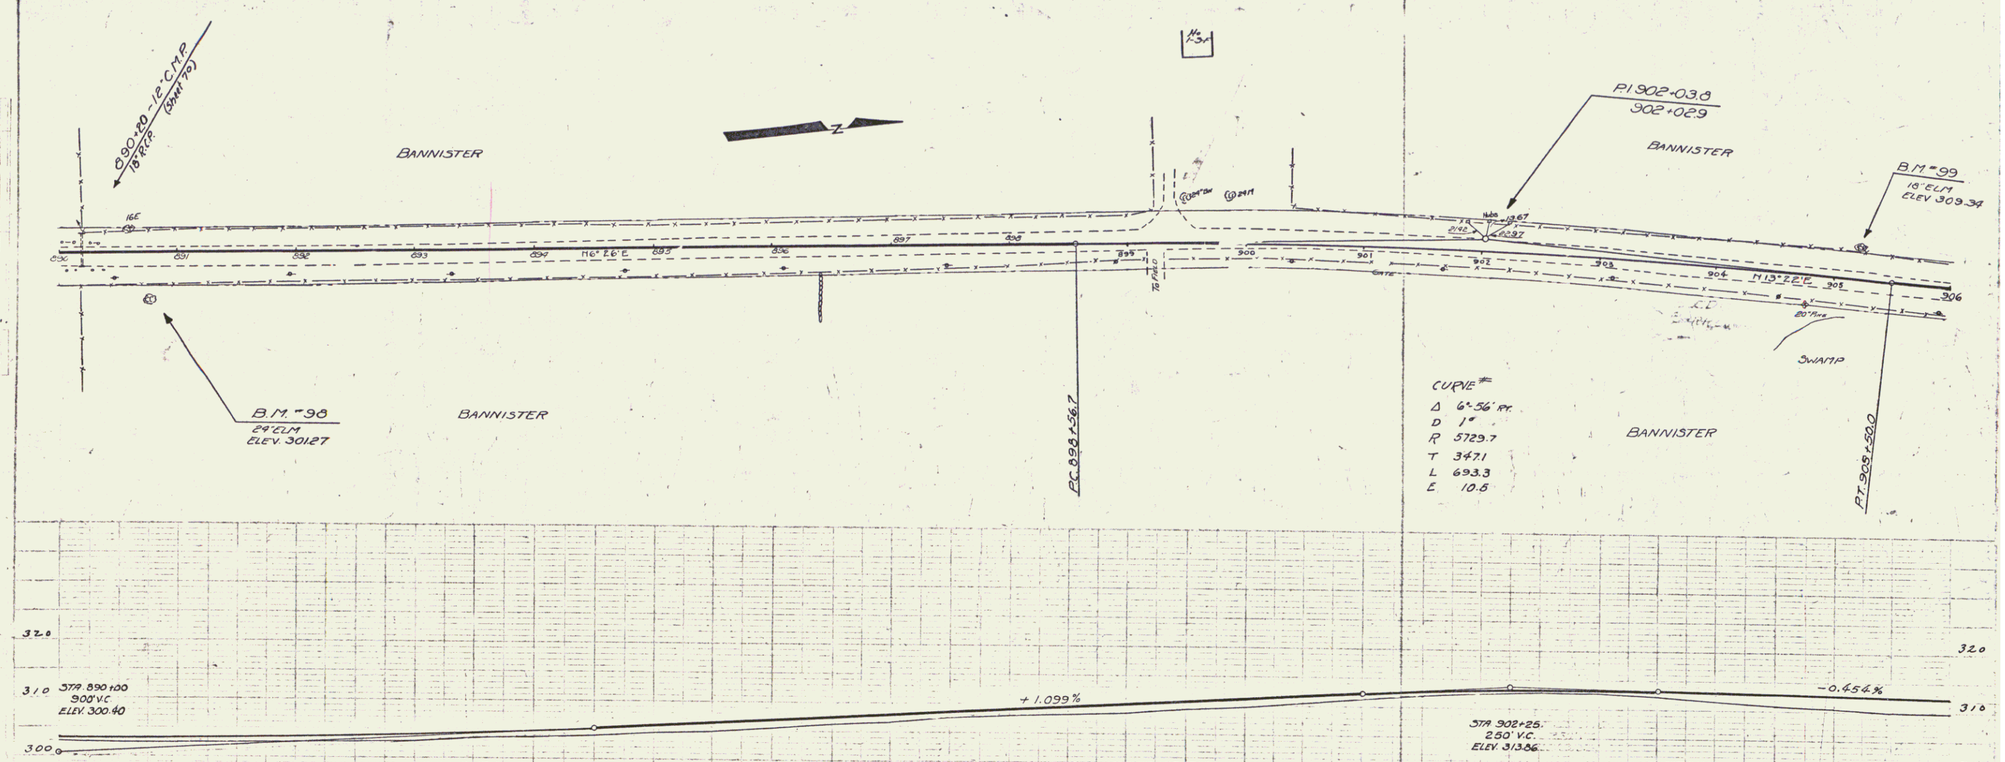

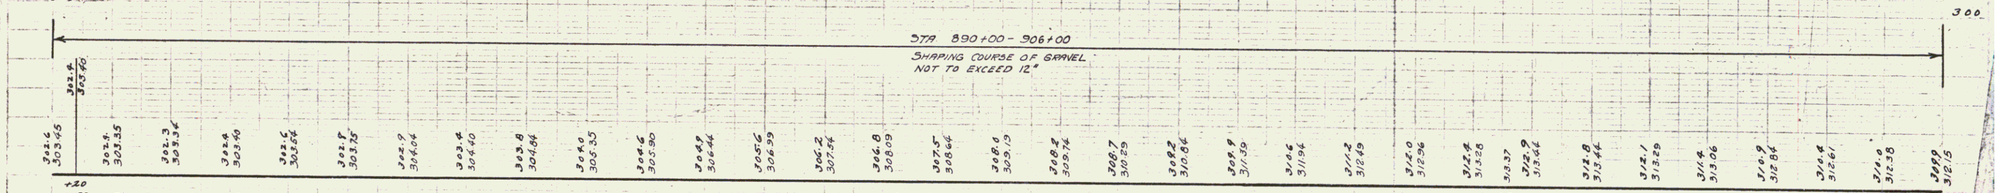

B.M. #98 SPIKE IN ROOT 29" ELM 38' Rt. 890+73 ELEV. 301.27
99 " " " 18" ELM 23' Lt. 905+32 ELEV. 309.34

SERIES E No. 109-A
SHEET 63 OF 192

65