Parcel	Kind of Instrument	Date of Instrument	Grantor	Grantee	Recorded Book Page	Date	Remarks
B'	O.C.D.	4-30-31	AA & E Langlois	State of Vt.	A1 133	5-3-31	
A	"	5-28-31	Jennie I. Bassett	"	A1 130-1	6-20-31	

CABLE GUARD RAIL REQUIRED

STATIONS	LENG	CONSTANT	PER LENGTH
173+50-175+50 LT.	200'	40'	240'
173+50-175+50 RT.	200'	40'	240'

NEW REINF CONCRETE PIPE CULVERTS REQUIRED

STATION	DIAM	LENG	CONC A	CONC C	REINF STEEL
174+03	30"	68	32 cy.	~	38 lbs.

DRIVEWAY PIPE CULVERTS REQUIRED

STATION	LOC	DIAM	LENG	CONC PIPE	CONCRETE RUBBLE MASONRY
177+00	Rt	12"	36'	2.3 cy.	

FEDERAL AID PROJECT	STATE	FEDERAL PROJECT NUMBER	YEAR	TOTAL SHEETS	SHEET NO.
		109 A	1931		19L

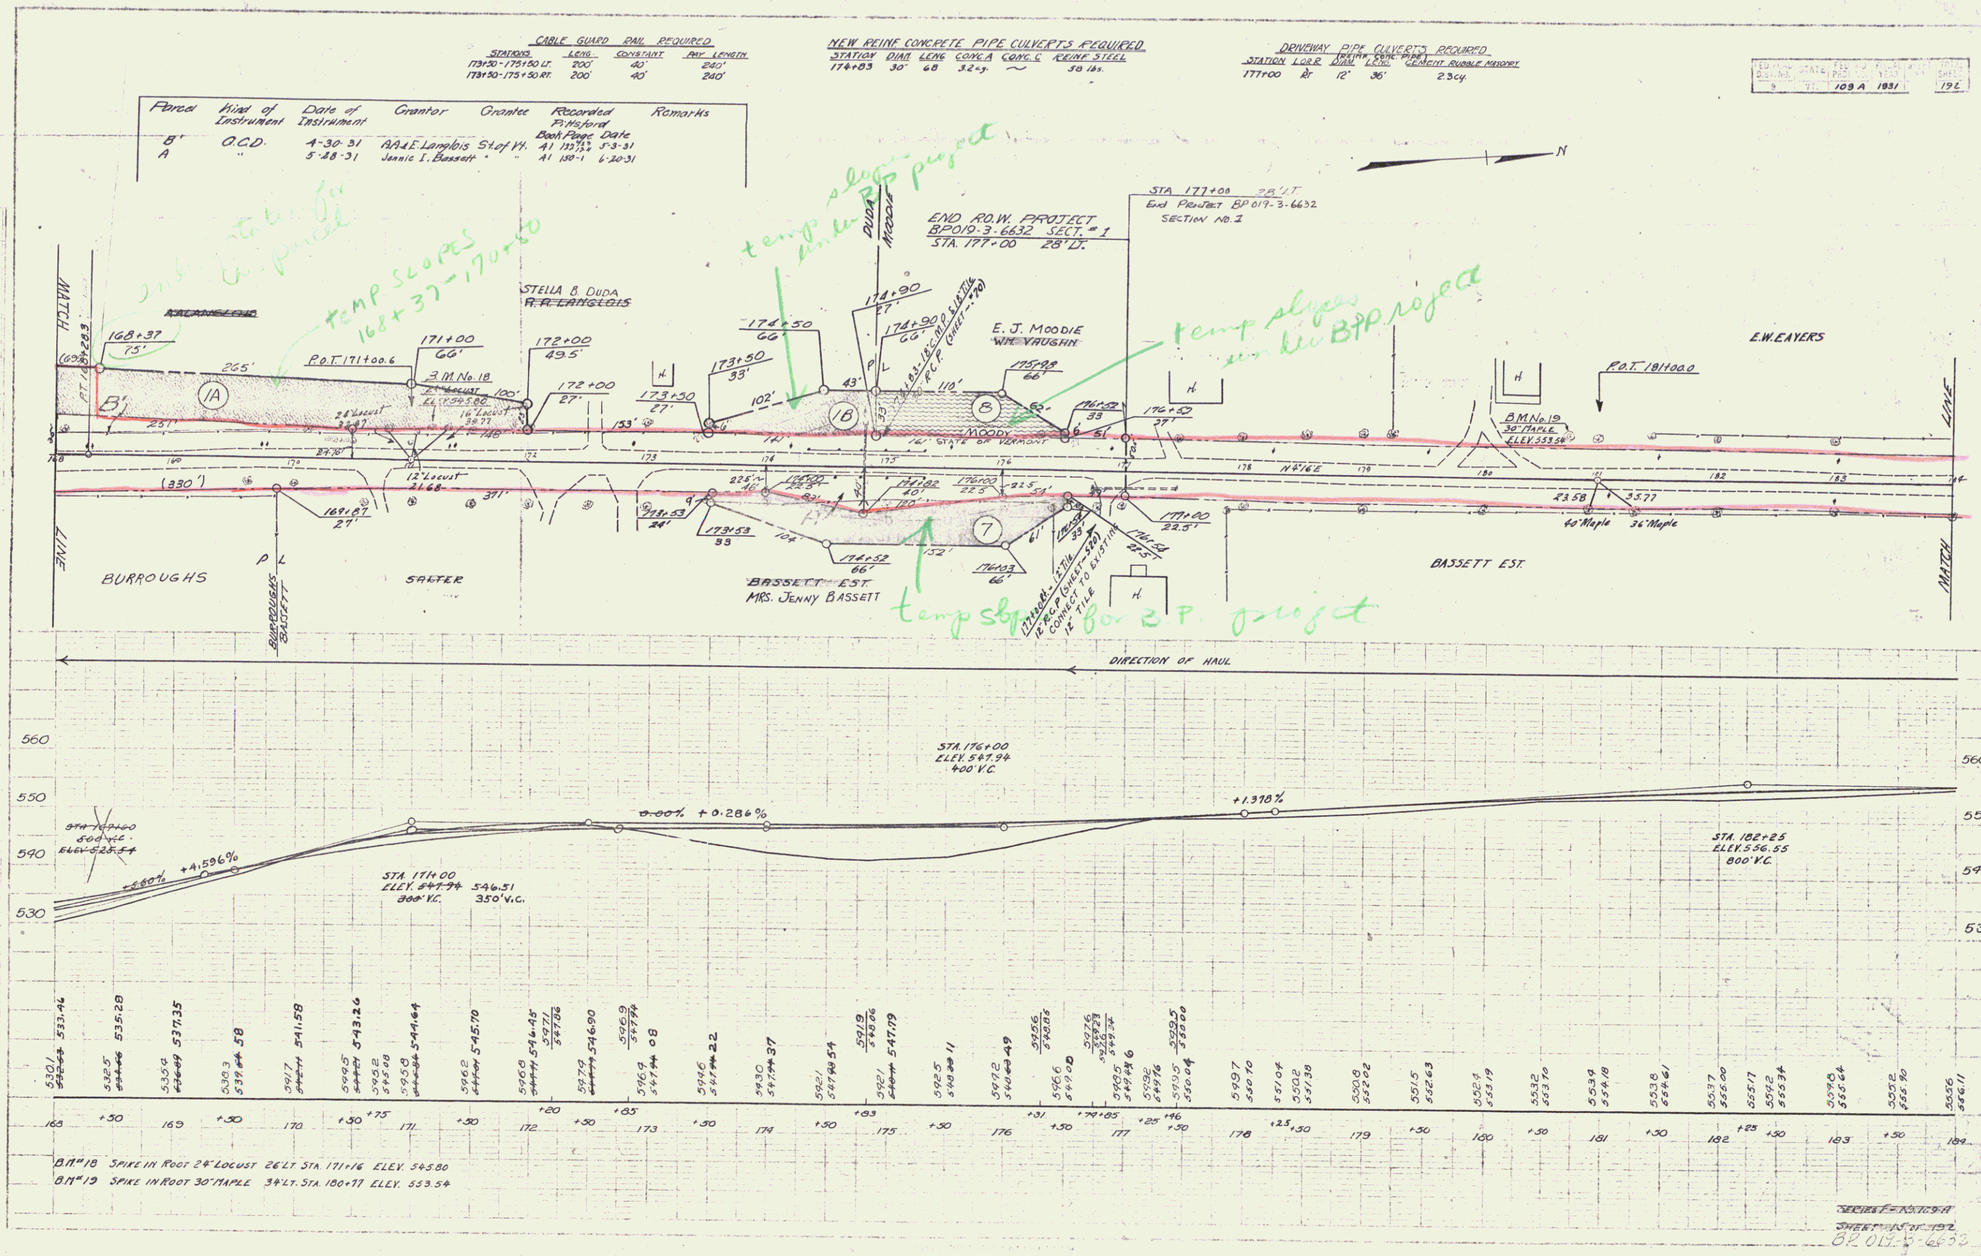

SECT. F-R 109-A
SHEET NO. 19 OF 19L
BP 019-3-6632
SHEET 5 OF 7 6