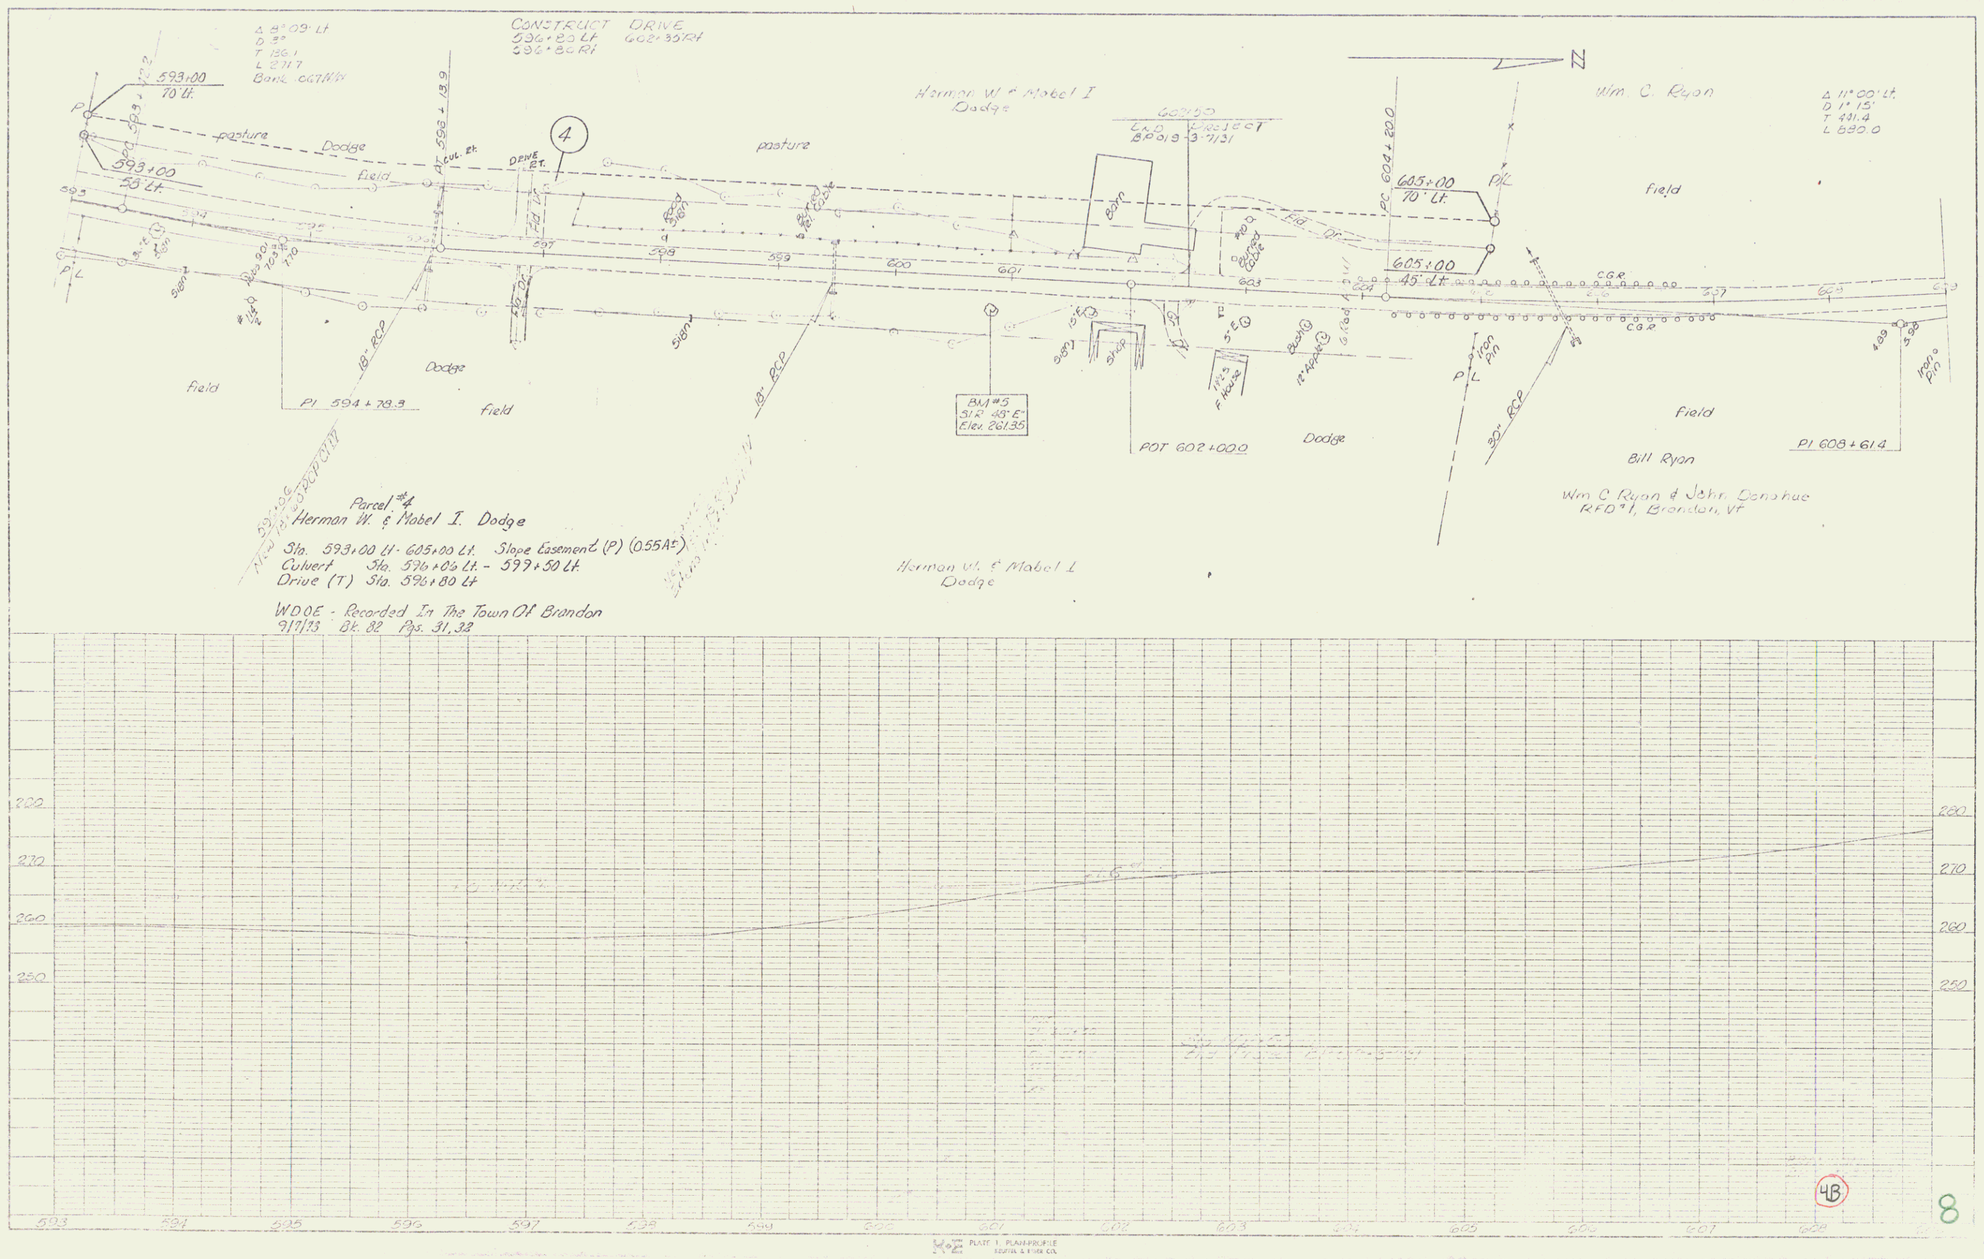
Δ 8°09' Lt.
D 3°
T 186.1
L 371.7
Bank OCTW4
CONSTRUCT DRIVE
596+80 Lt. 602+35 Rt
596+80 Rt
593+00
70' Lt.
593+00
50' Lt.
pasture
Dodge
field
598+13.9
Culv. Et.
DRIVE Et.
4
Herman W. & Mabel I Dodge
pasture
Bldg.
Bldg.
Bldg.