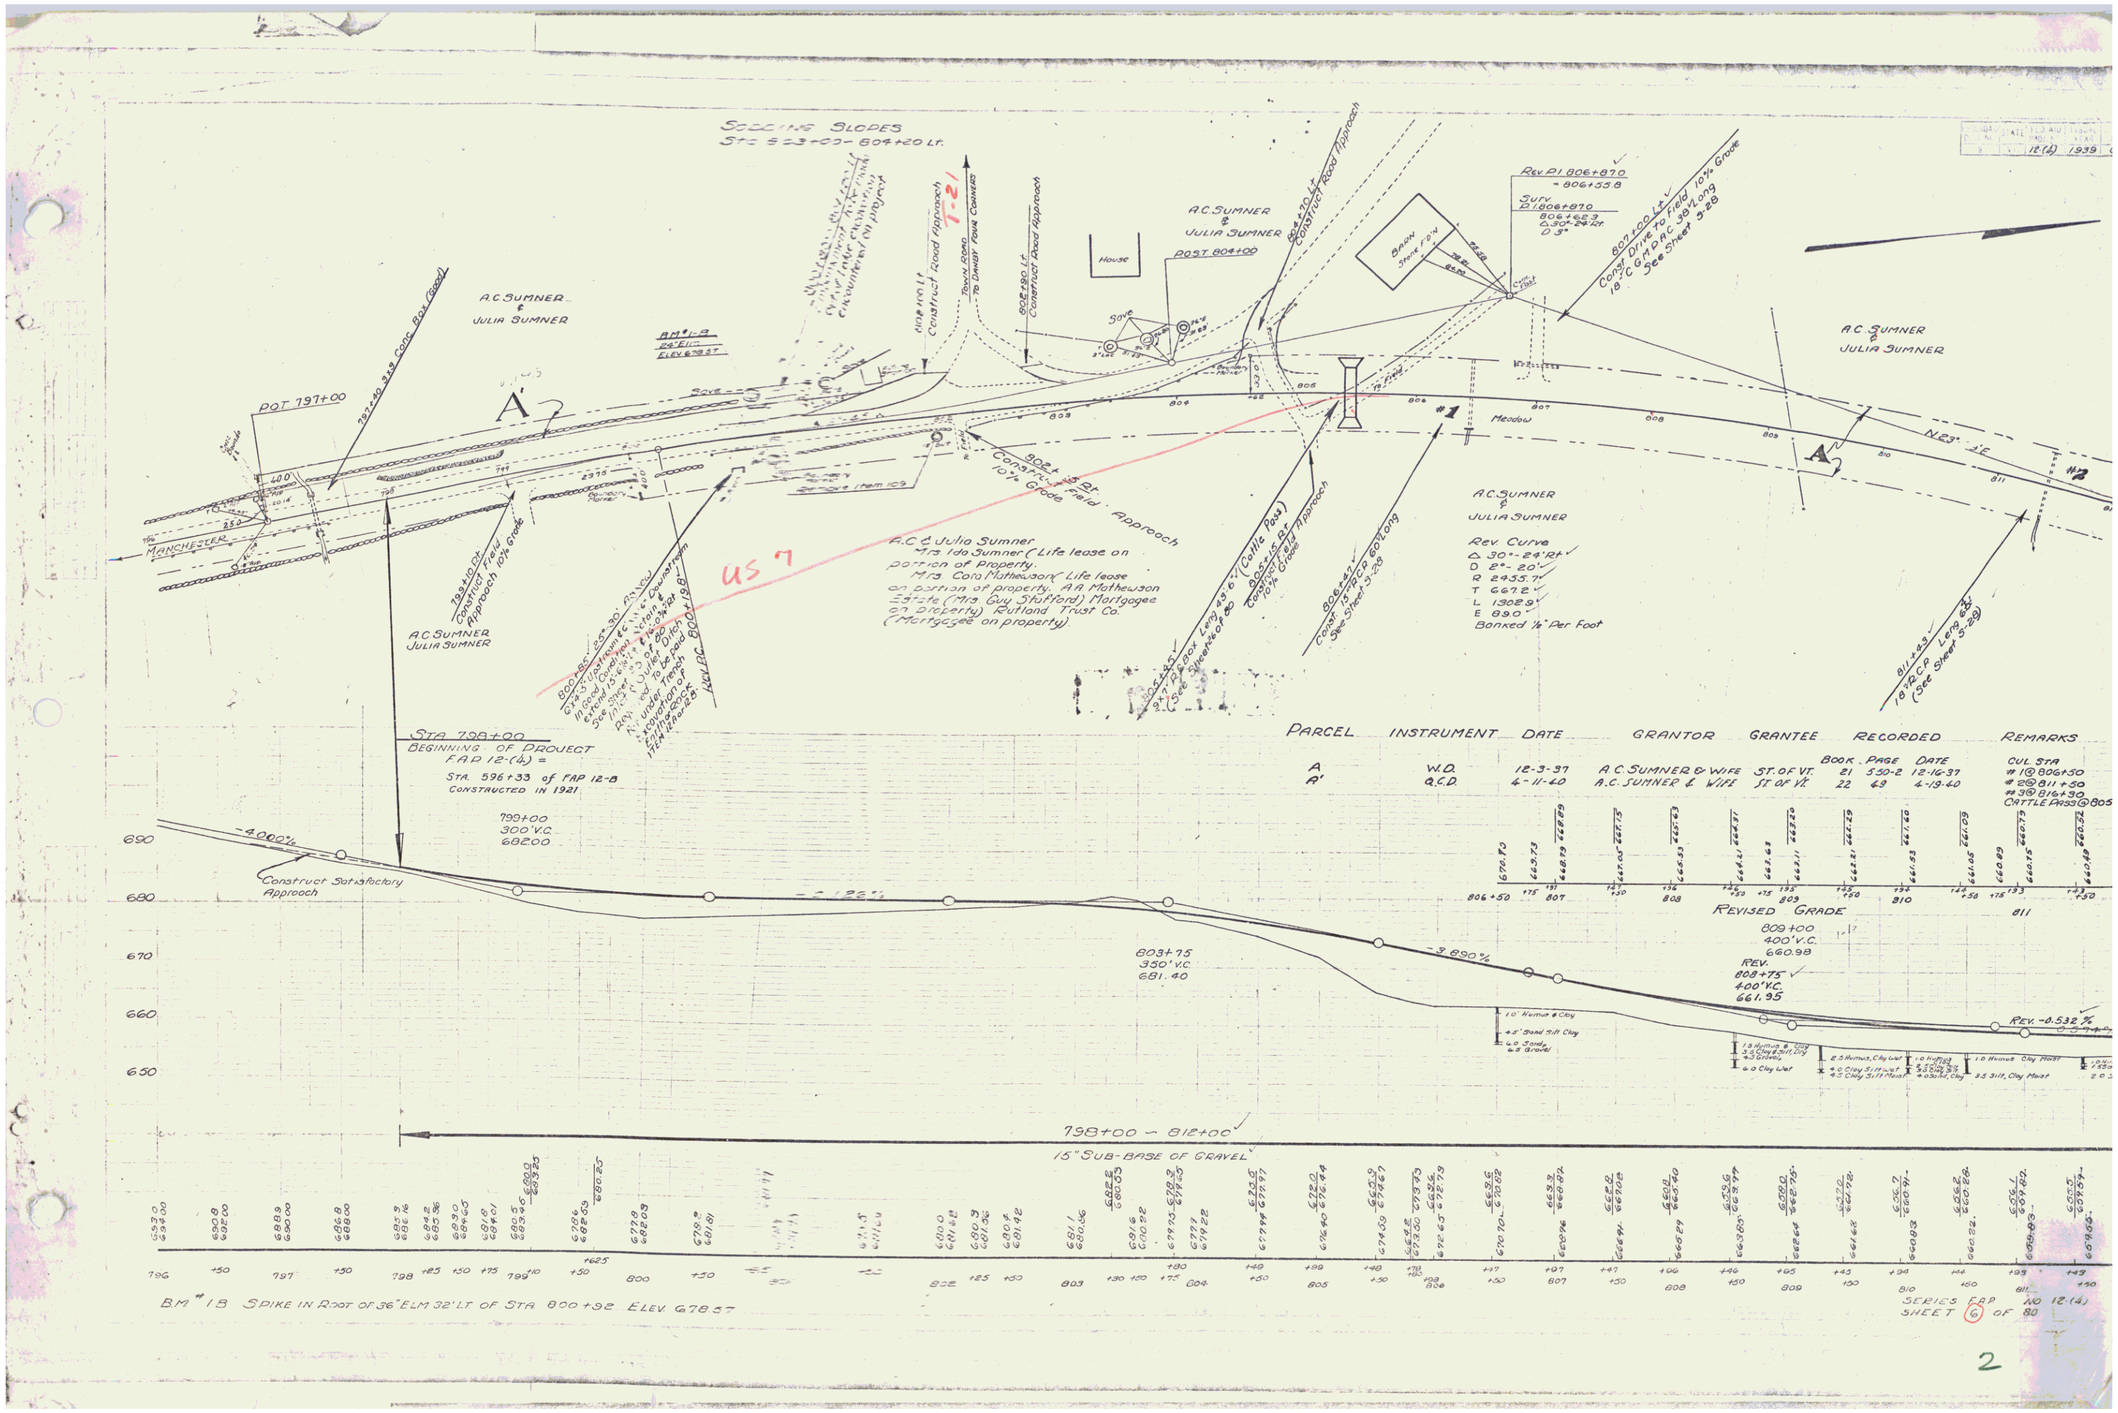

Parcel	Instrument	Date	Grantor	Grantee	Recorded Book	Page	Date	Remarks
A	W.D.	12-3-37	A.C. Sumner & wife	St. of Vt.	21	550-2	12-16-37	Cul. Sta #1 @ 806+50
A'	Q.C.D.	4-11-40	A.C. Sumner & wife	St. of Vt.	22	69	4-19-40	#2 @ 811+50
								#3 @ 816+30
								Cattle Pass @ 805