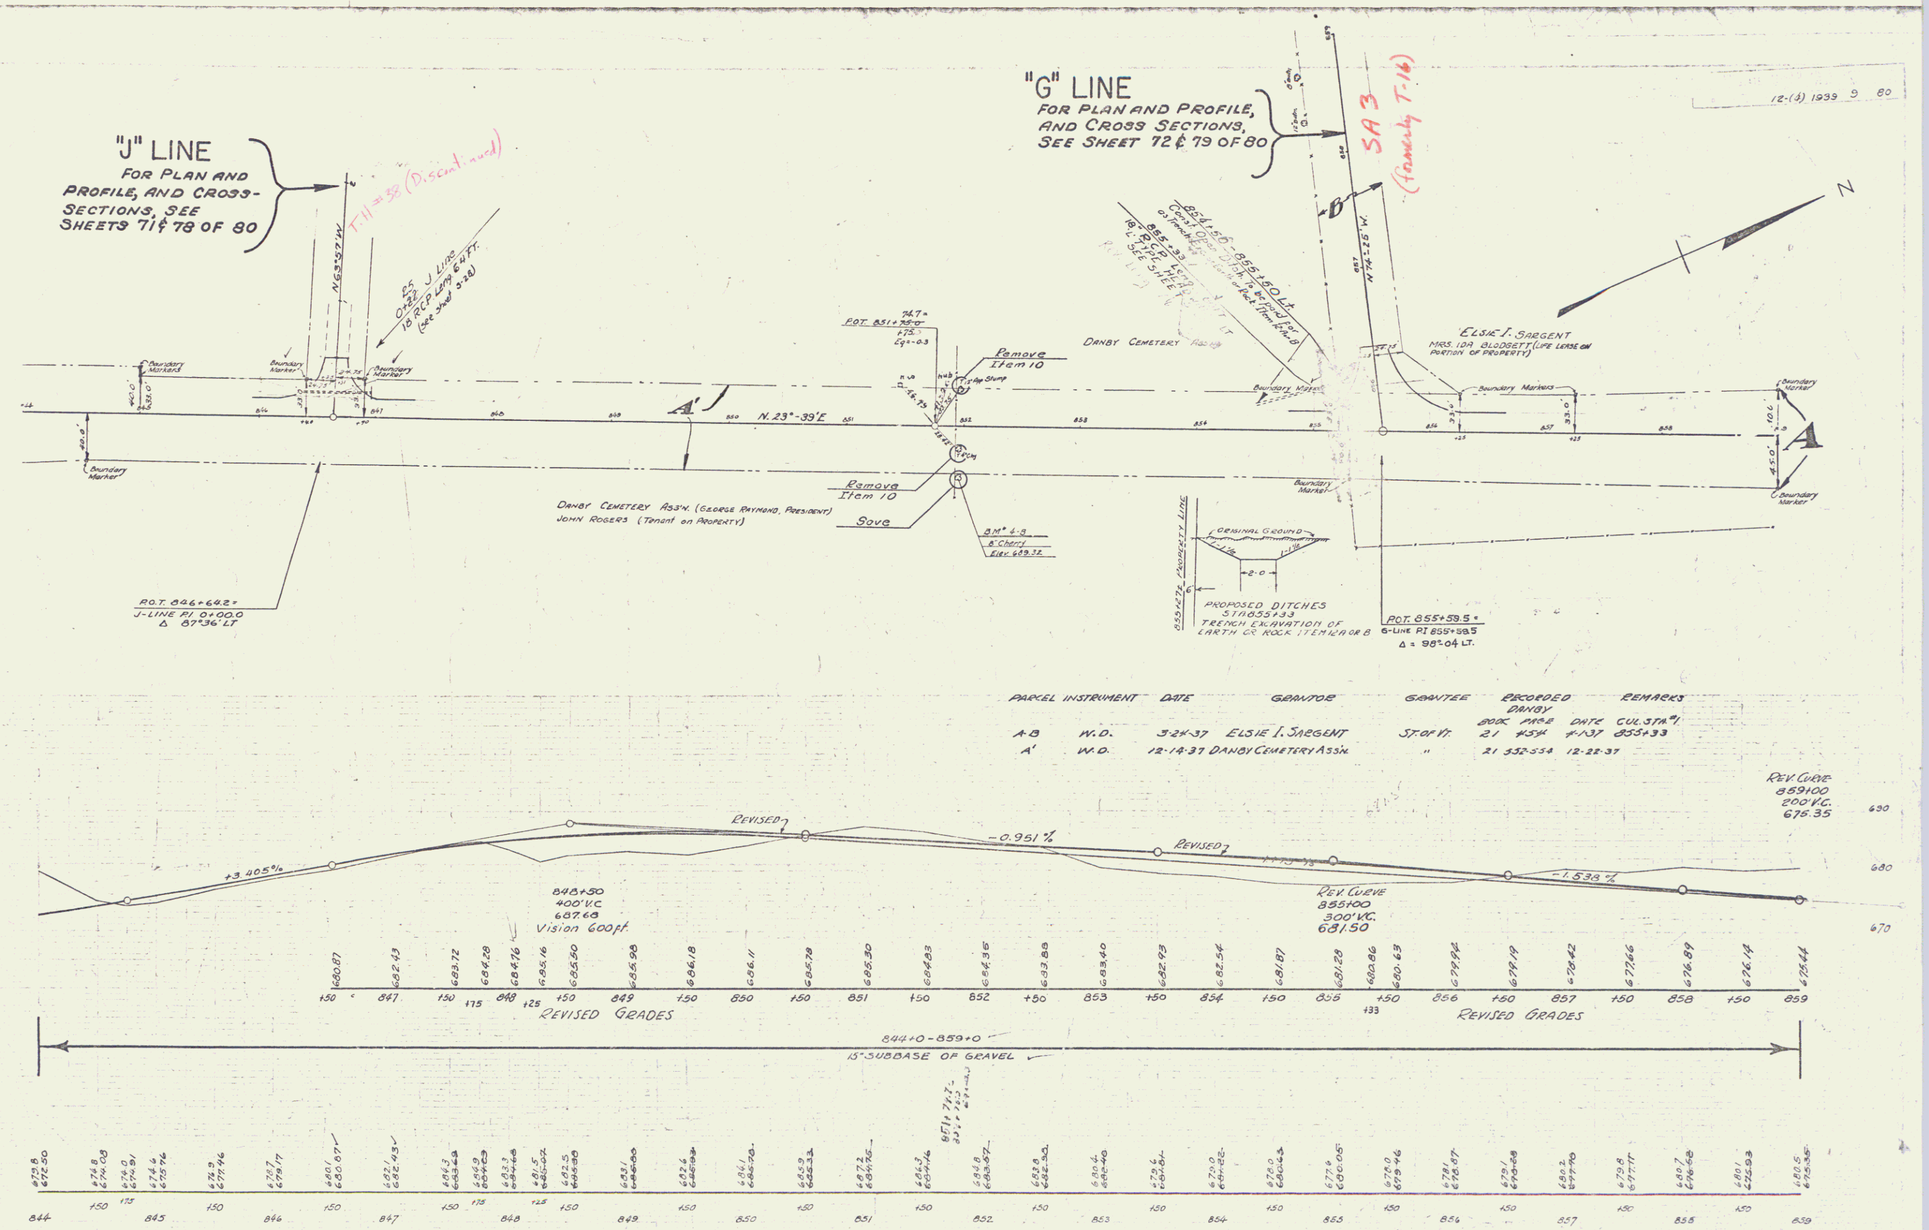
"J" LINE
FOR PLAN AND PROFILE, AND CROSS-SECTIONS, SEE SHEETS 71 & 78 OF 80
"G" LINE
FOR PLAN AND PROFILE, AND CROSS SECTIONS, SEE SHEET 72 & 79 OF 80
12-(3) 1939 9 80
SA 3
(formerly T-16)
T.11 = 32 (Discontinued)
N 63°-37' W
N 74°-26' W
N. 23°-39' E
A' J
A
B
N
Boundary Marker
Remove Item 10
Save
Danby Cemetery Ass'n. (George Raymond, President)
John Rogers (Tenant on Property)
Danby Cemetery Assn.
Elsie I. Sargent
Mrs. Ida Blodgett (Life Lease on Portion of Property)
Property Line
Original Ground
Proposed Ditches
Sta 855+33
Trench Excavation of Earth or Rock Item 6A or B
P.O.T. 846+64.2 =
J-Line P.I. 0+00.0
Δ 87°36' LT
P.O.T. 855+59.5 =
G-Line P.I. 855+59.5
Δ = 98°-04 LT.
B.M. # 4-B
8" Cherry
Elev. 689.32
Parcel Instrument Date Grantor Grantee Recorded Danby Book Page Date Remarks Cul. Sta. #1
A-B W.D. 3-24-37 Elsie I. Sargent St. of Vt. 21 #534 #1/37 855+33
A' W.D. 12-14-37 Danby Cemetery Ass'n. " 21 552-554 12-22-37
Revised
+3.405%
-0.951%
-1.539%
848+50 400' V.C. 687.63 Vision 600 ft.
Rev. Curve 855+00 300' V.C. 691.50
Revised Grades
844+0 - 859+0
15" Subbase of Gravel
B.M. # 4-B Spike in root of 8" cherry 42' Rt of Sta 851+93 Elev. 689.32
Series F.A.P. No. 12-(4)
Sheet 5 of 80
5