FED. ROAD DIST. NO.	STATE	FED. AID PROJ. NO.	FISCAL YEAR	SHEET NO.	TOTAL NO. SHEETS
9	VT.	12-(4)	1939	13	80

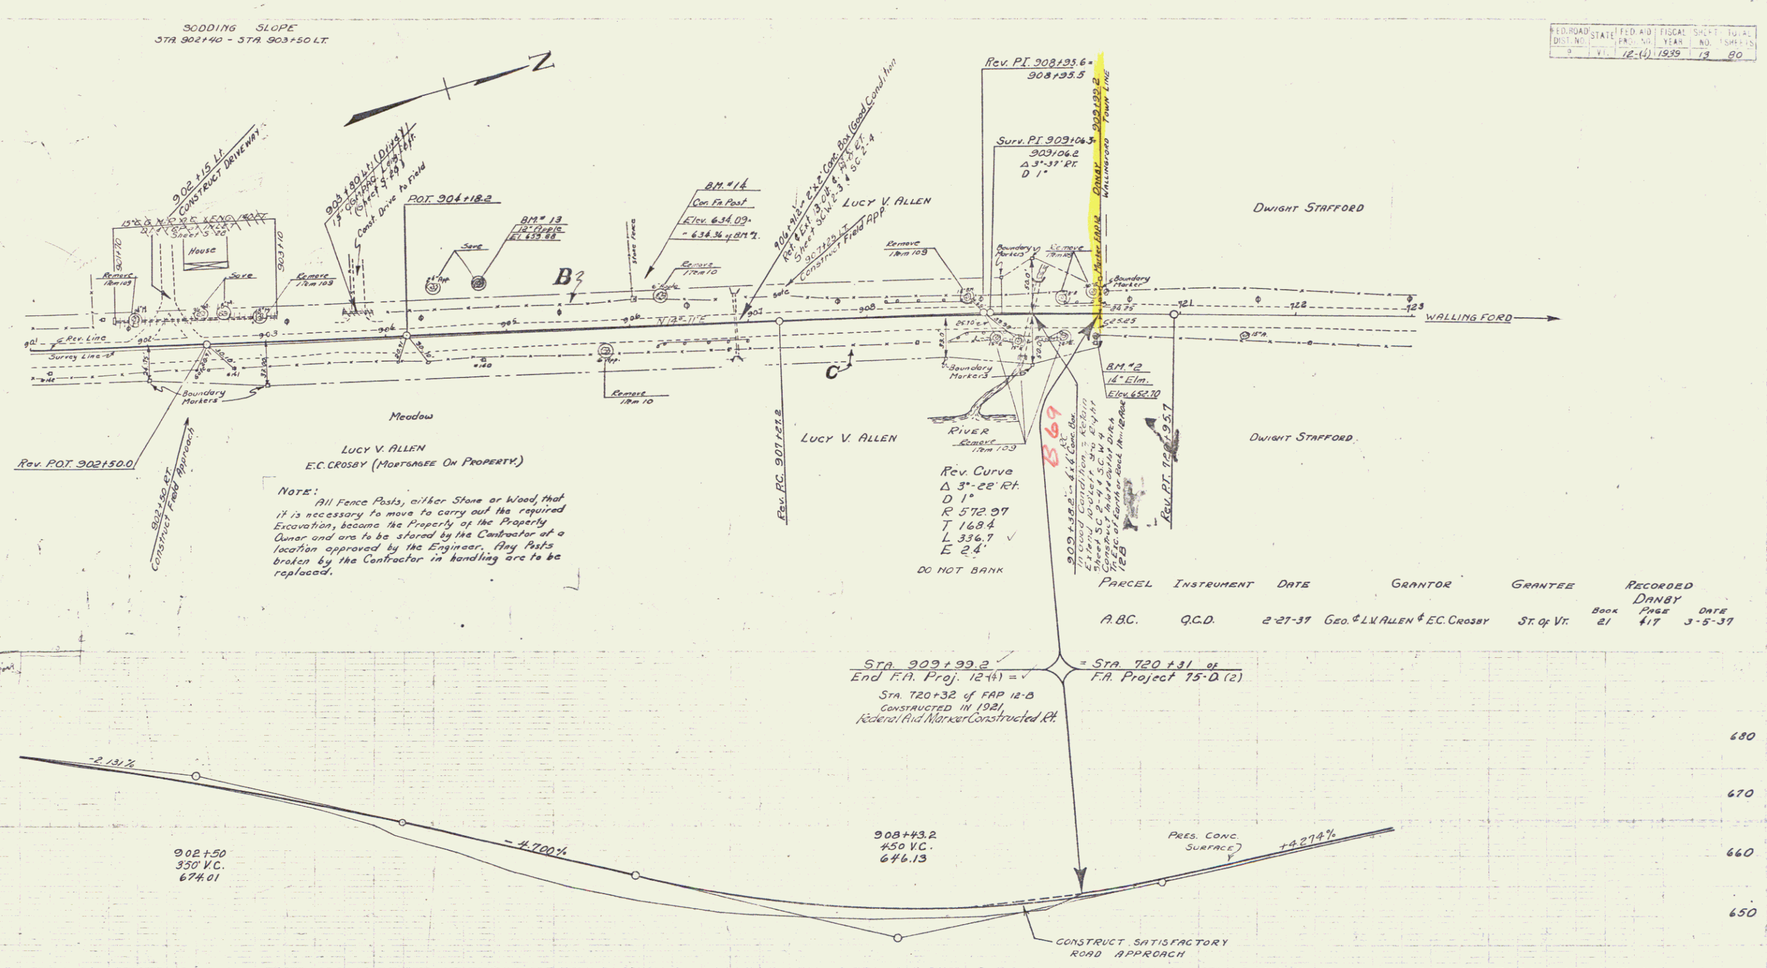

NOTE:
All Fence Posts, either Stone or Wood, that it is necessary to move to carry out the required Excavation, become the Property of the Property Owner and are to be stored by the Contractor at a location approved by the Engineer. Any Posts broken by the Contractor in handling are to be replaced.

PARCEL	INSTRUMENT	DATE	GRANTOR	GRANTEE	RECORDED DANBY BOOK	PAGE	DATE
A.B.C.	Q.C.D.	2-27-37	Geo. & L.V. Allen & E.C. Crosby	St. of Vt.	21	417	3-5-37

BM. #13 Spike in root of 12" Apple, 42ft Lt. Sta. 904+78.2 Elev. 659.88
BM. #1 of 75-D - BM. #14 Top of stone corner post, 26ft Lt. Sta. 906+06.2 Elev. 634.36 = 634.09 Eq. = 0.27ft.

SERIES F.A.P. No 12-(4)
SHEET 13 OF 80

9