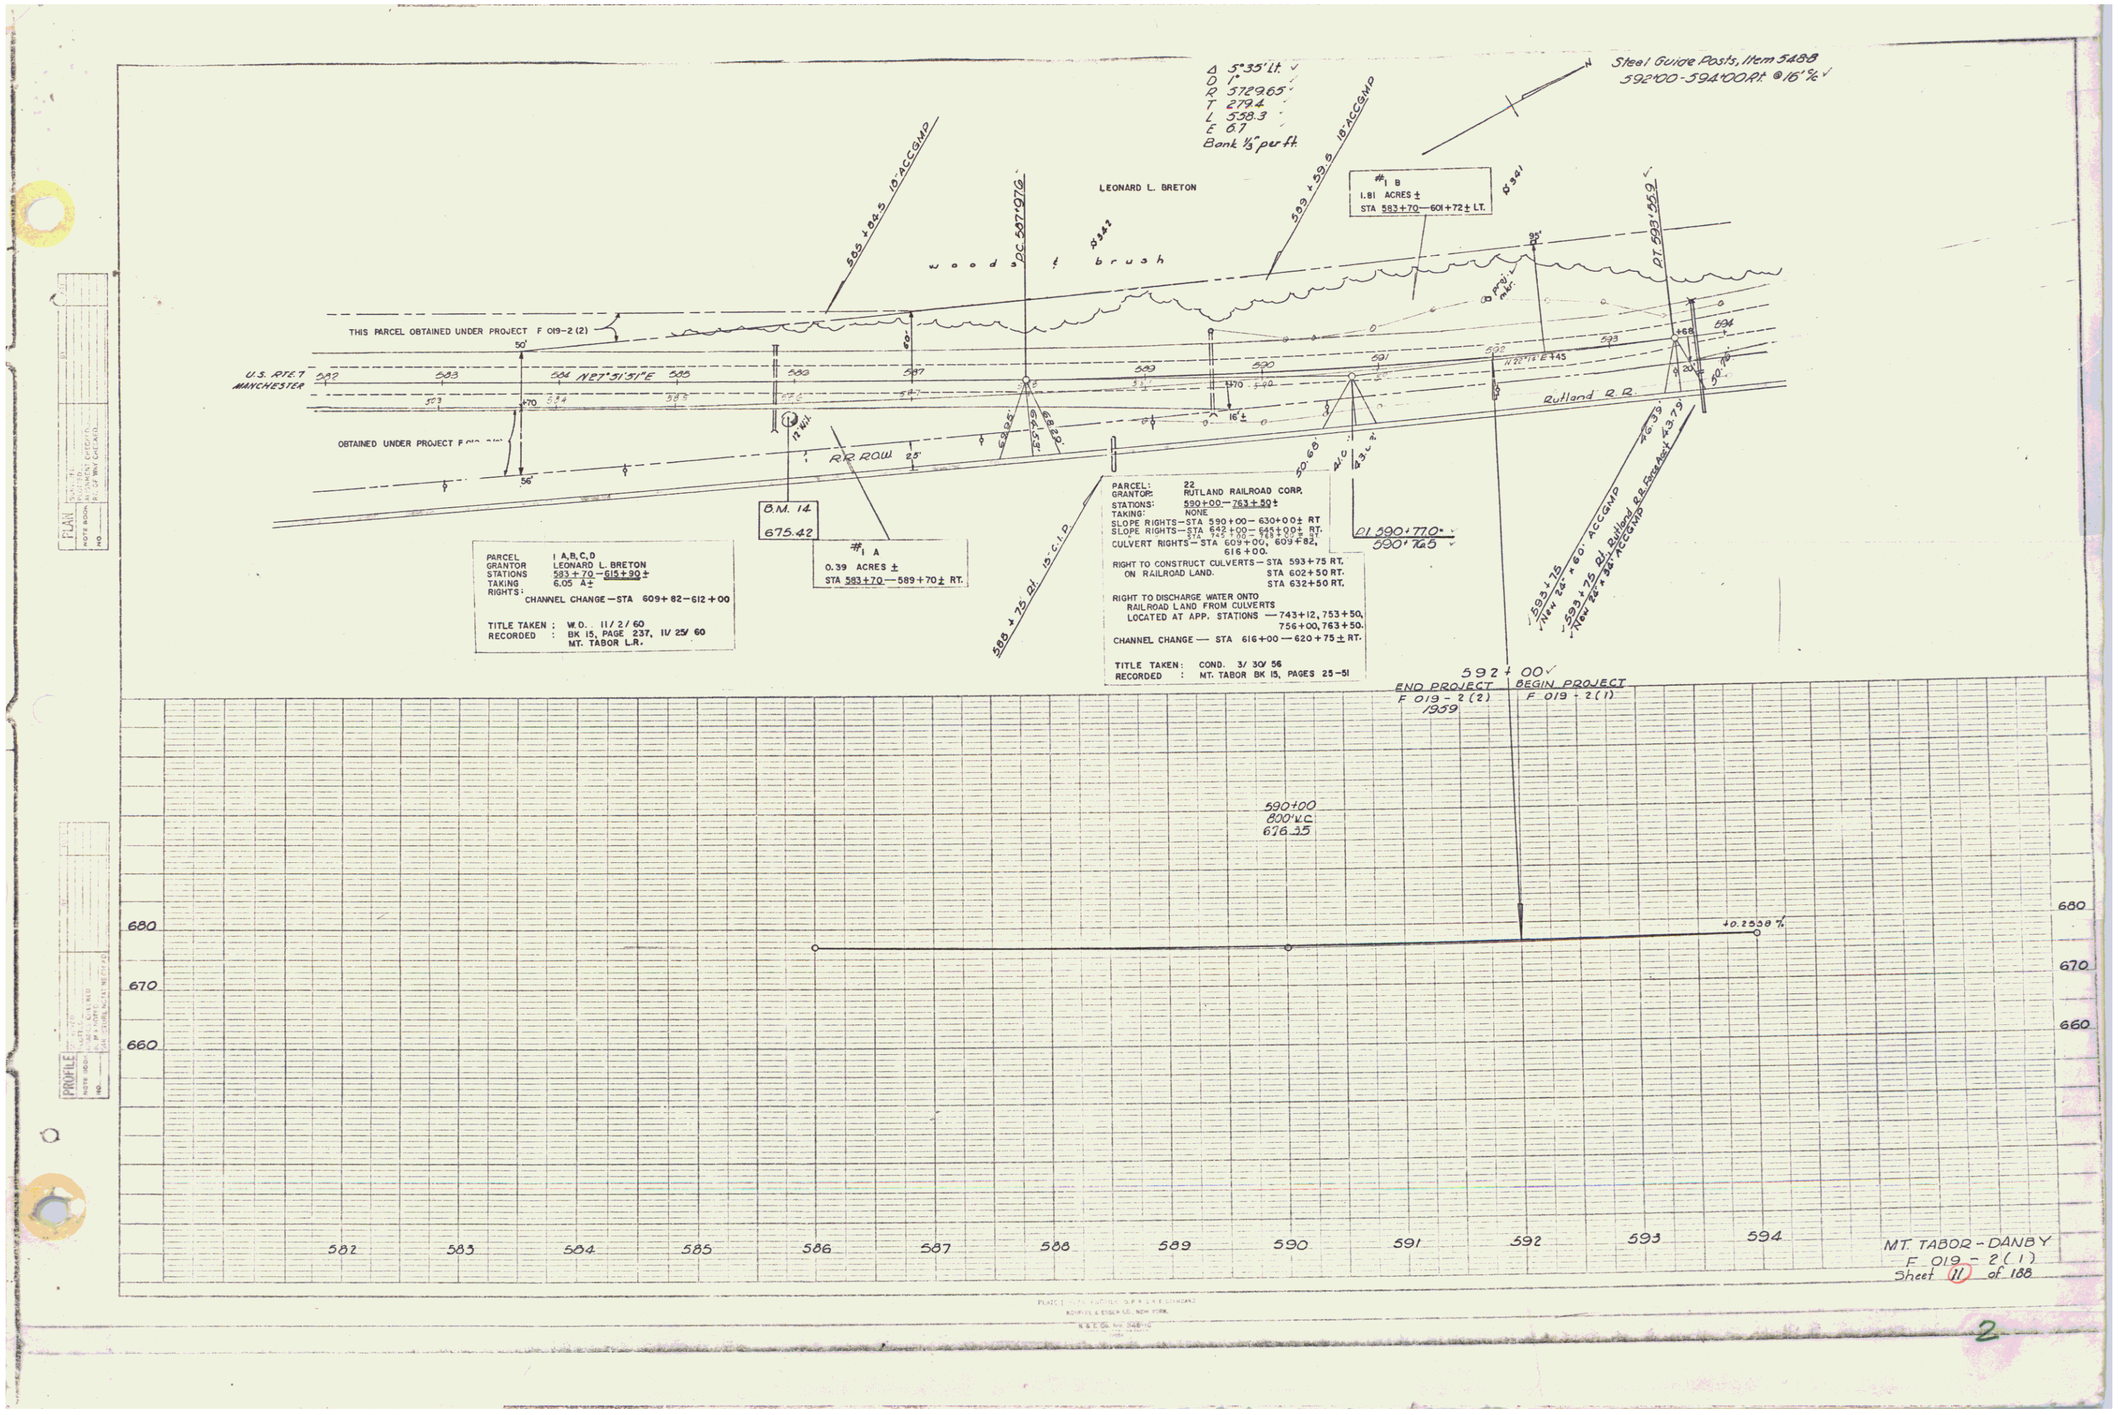

Steel Guide Posts, Item 548B
592+00-594+00 Rt. @ 16' c/c
Δ 5°35' Lt.
D 1°
R 5729.65
T 279.4
L 558.3
E 6.7
Bank 1/3" per ft.
LEONARD L. BRETON
#1 B
1.81 ACRES ±
STA 583+70—601+72 ± LT.
585+84.5 18" ACCGMP
589+59.8 18" ACCGMP
P.C. 587+97.6
P.T. 593+55.9
woods & brush
THIS PARCEL OBTAINED UNDER PROJECT F 019-2 (2)
U.S. RTE. 7 MANCHESTER
OBTAINED UNDER PROJECT F 019-2 (1)
N 27°51'51" E
Rutland R.R.
R.R. R.O.W.
B.M. 14
675.42
#1 A
0.39 ACRES ±
STA 583+70—589+70 ± RT.
PARCEL 1 A,B,C,D
GRANTOR LEONARD L. BRETON
STATIONS 583+70—615+90 ±
TAKING 6.05 A ±
RIGHTS: CHANNEL CHANGE—STA 609+82—612+00
TITLE TAKEN : W.D. 11/2/60
RECORDED : BK 15, PAGE 237, 11/25/60 MT. TABOR L.R.
PARCEL: 22
GRANTOR: RUTLAND RAILROAD CORP.
STATIONS: 590+00—763+50 ±
TAKING: NONE
SLOPE RIGHTS—STA 590+00—630+00 ± RT
SLOPE RIGHTS—STA 642+00—645+00 ± RT.
STA 745+00—763+50 ± RT.
CULVERT RIGHTS—STA 609+00, 609+82, 616+00.
RIGHT TO CONSTRUCT CULVERTS—STA 593+75 RT.
ON RAILROAD LAND. STA 602+50 RT.
STA 632+50 RT.
RIGHT TO DISCHARGE WATER ONTO RAILROAD LAND FROM CULVERTS LOCATED AT APP. STATIONS —743+12, 753+50, 756+00, 763+50.
CHANNEL CHANGE — STA 616+00—620+75 ± RT.
TITLE TAKEN: COND. 3/30/56
RECORDED : MT. TABOR BK 15, PAGES 25-51
588+75 Rt. 15" C.I.P.
P.I. 590+77.0
590+76.5
593+75 New 24" x 60' ACCGMP
593+75 Rt. Rutland R.R. Force Acct. 43.79
New 24" x 34' ACCGMP
592+00
END PROJECT F 019-2 (2) 1959
BEGIN PROJECT F 019-2 (1)
590+00
800' V.C.
676.35
+0.2558 %
680
670
660
582
583
584
585
586
587
588
589
590
591
592
593
594
MT. TABOR - DANBY
F 019 - 2 (1)
Sheet 11 of 188


2