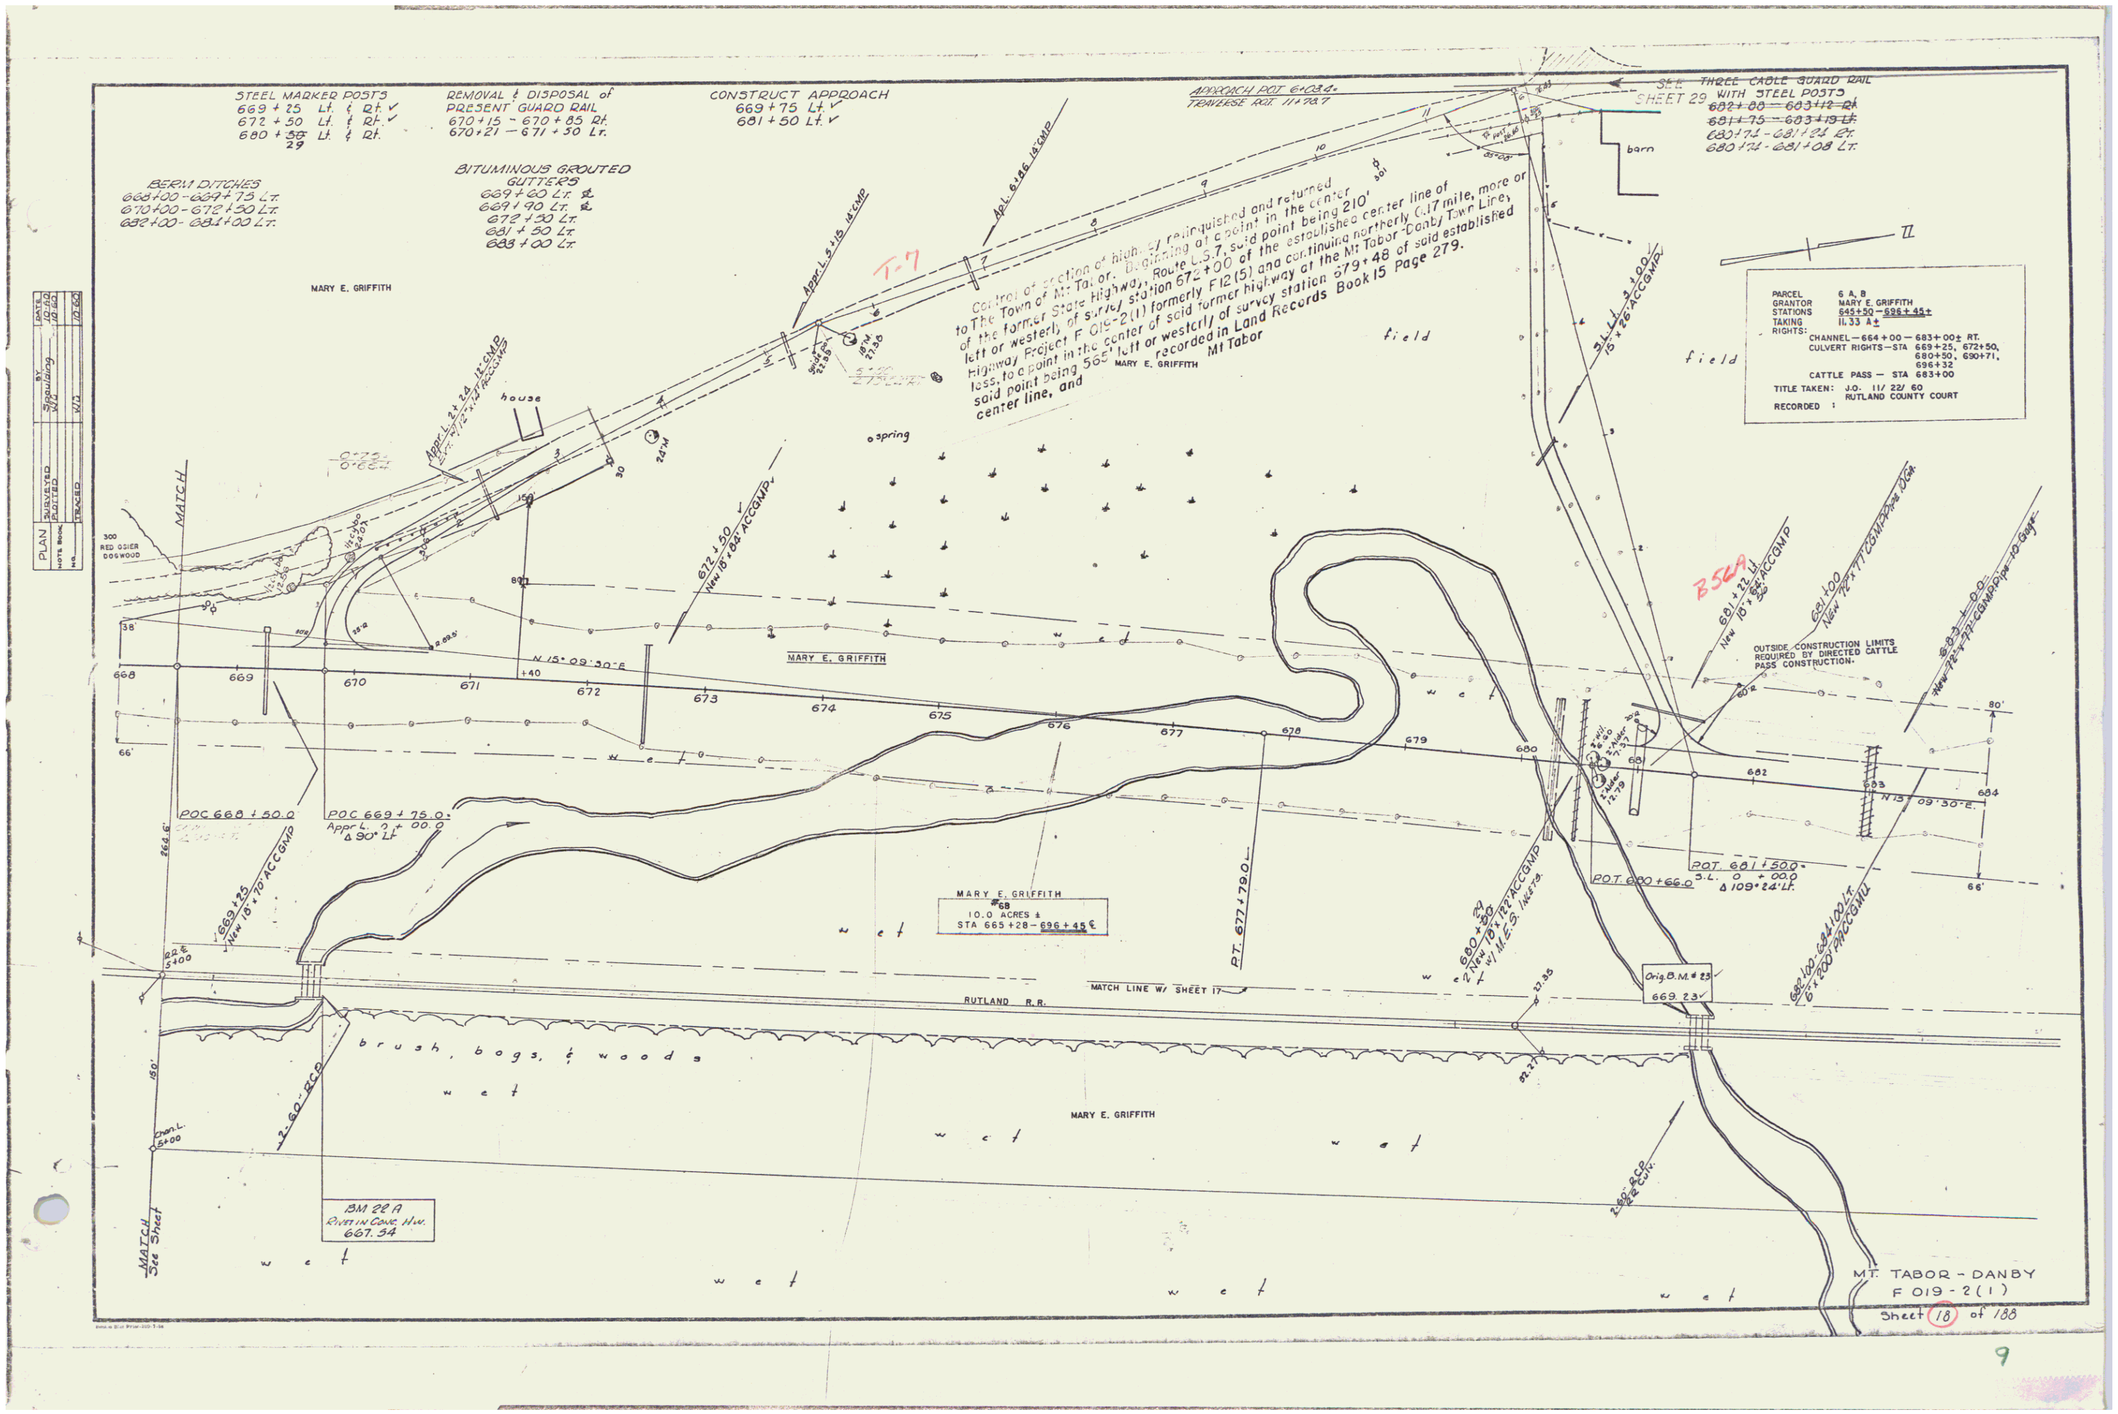

PLAN
NOTE BOOK
NO.
SURVEYED
PLOTTED
TRACED
BY
Sigouloing
NJZ
NJZ
DATE
10/60
10/60
12/60

9