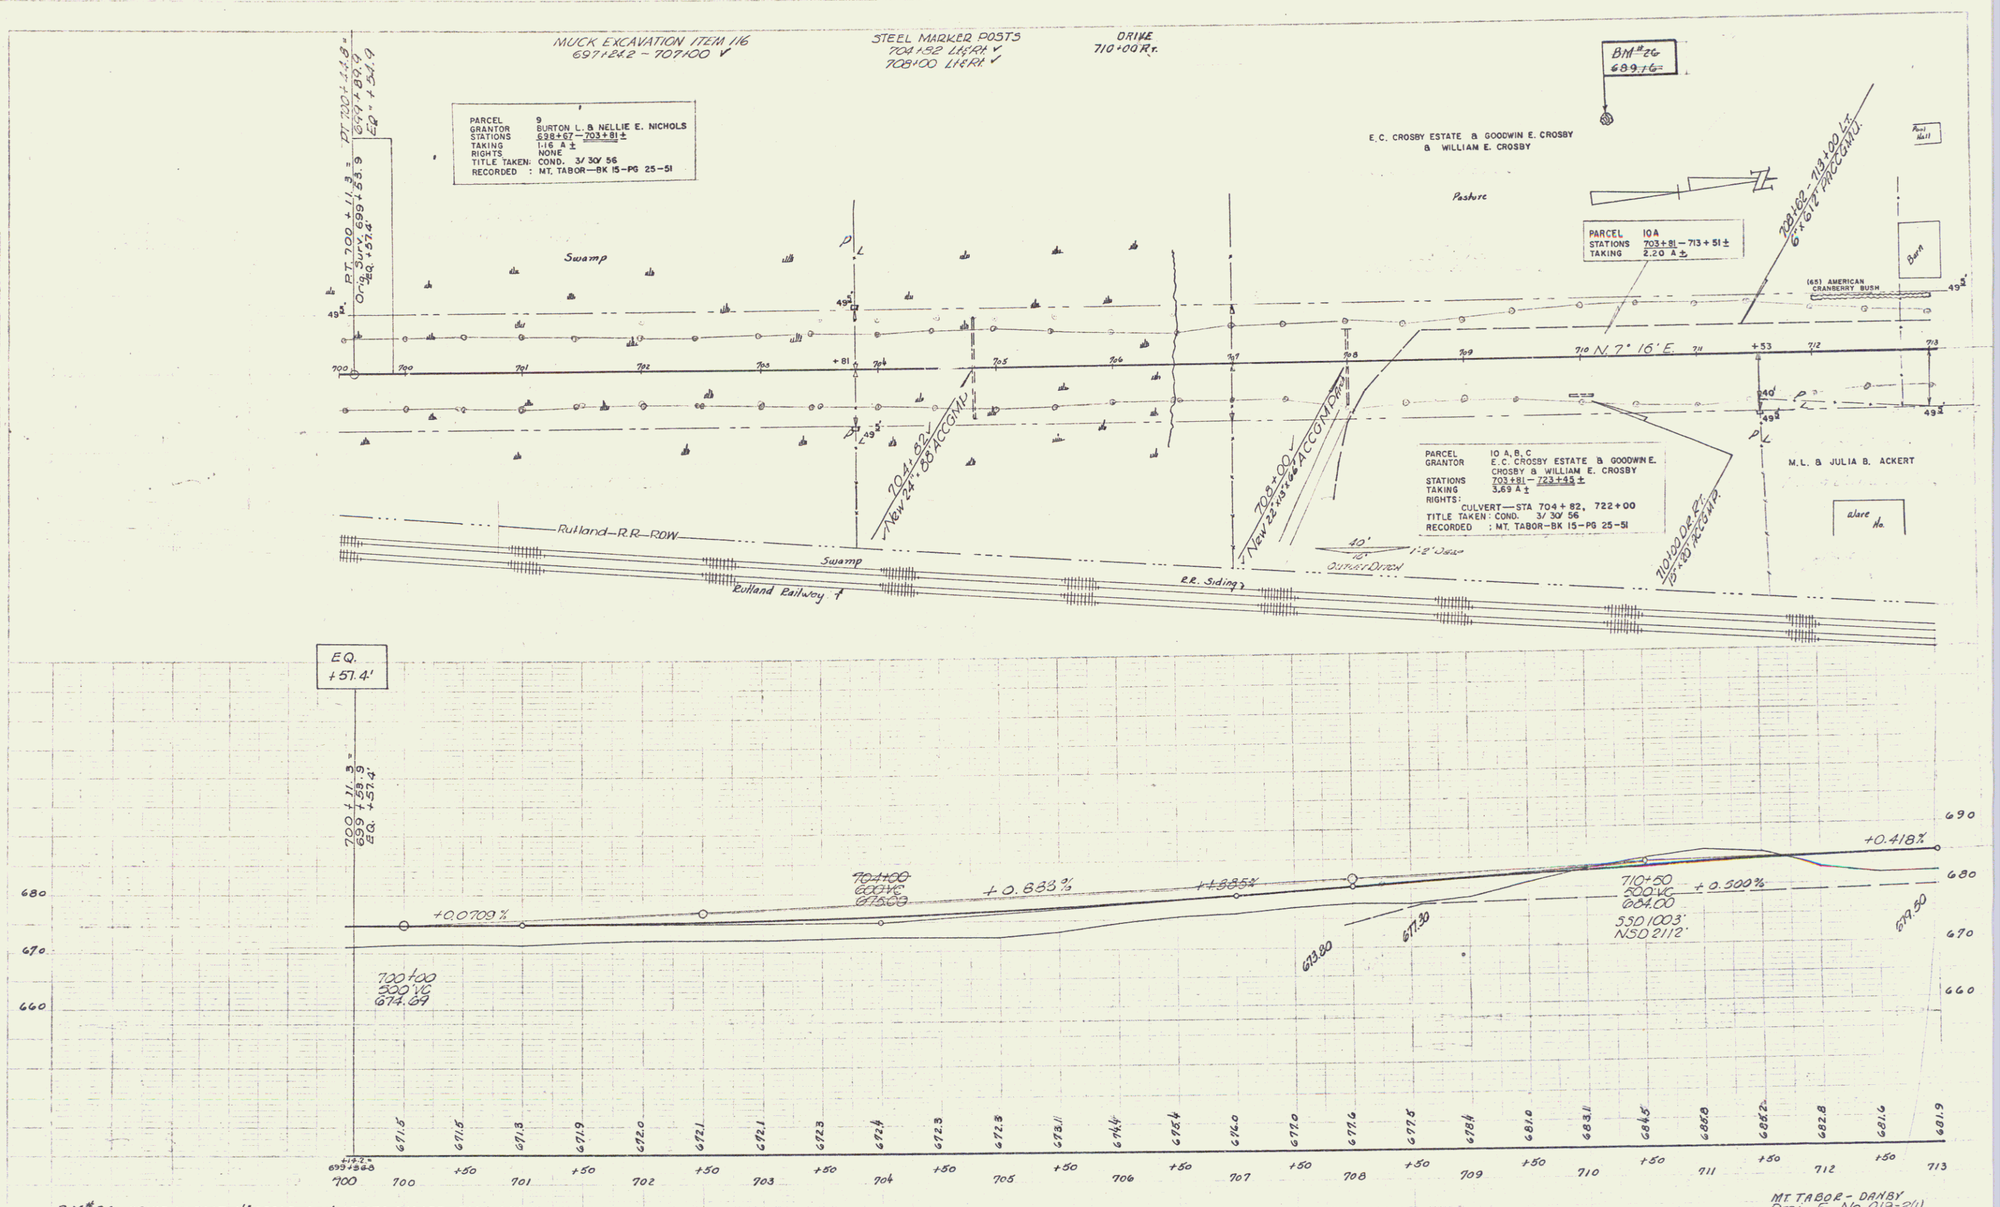
MUCK EXCAVATION ITEM 116
697+84.2 – 707+00
STEEL MARKER POSTS
704+52 Lt&Rt
708+00 Lt&Rt
DRIVE
710+00 Rt.
BM #26
689.16
PARCEL 9
GRANTOR BURTON L. & NELLIE E. NICHOLS
STATIONS 698+67 – 703+81 ±
TAKING 1.16 A ±
RIGHTS NONE
TITLE TAKEN: COND. 3/30/56
RECORDED : MT. TABOR–BK 15–PG 25–51
E.C. CROSBY ESTATE & GOODWIN E. CROSBY
& WILLIAM E. CROSBY
Pasture
PARCEL 10A
STATIONS 703+81 – 713+51 ±
TAKING 2.20 A ±
(65) AMERICAN CRANBERRY BUSH
Barn
Swamp
N 7° 16' E
PARCEL 10 A, B, C
GRANTOR E.C. CROSBY ESTATE & GOODWIN E. CROSBY & WILLIAM E. CROSBY
STATIONS 703+81 – 723+45 ±
TAKING 5.69 A ±
RIGHTS: CULVERT — STA 704+82, 722+00
TITLE TAKEN: COND. 3/30/56
RECORDED : MT. TABOR–BK 15–PG 25–51
M.L. & JULIA B. ACKERT
Rutland–R.R.–ROW
Rutland Railway
R.R. Siding
OUTLET DITCH
EQ. +57.4'
+0.0709%
+0.683%
+0.500%
+0.418%
700+00 500'VC 674.69
710+50 500'VC 684.00
SSD 1003'
NSD 2112'
BM #26 SPIKE IN ROOT 14" APPLE 200' LT. STA. 710+25 ELEV. 689.16
MT. TABOR - DANBY
Proj. F No. 013-2(1)
Sheet 22 of 188