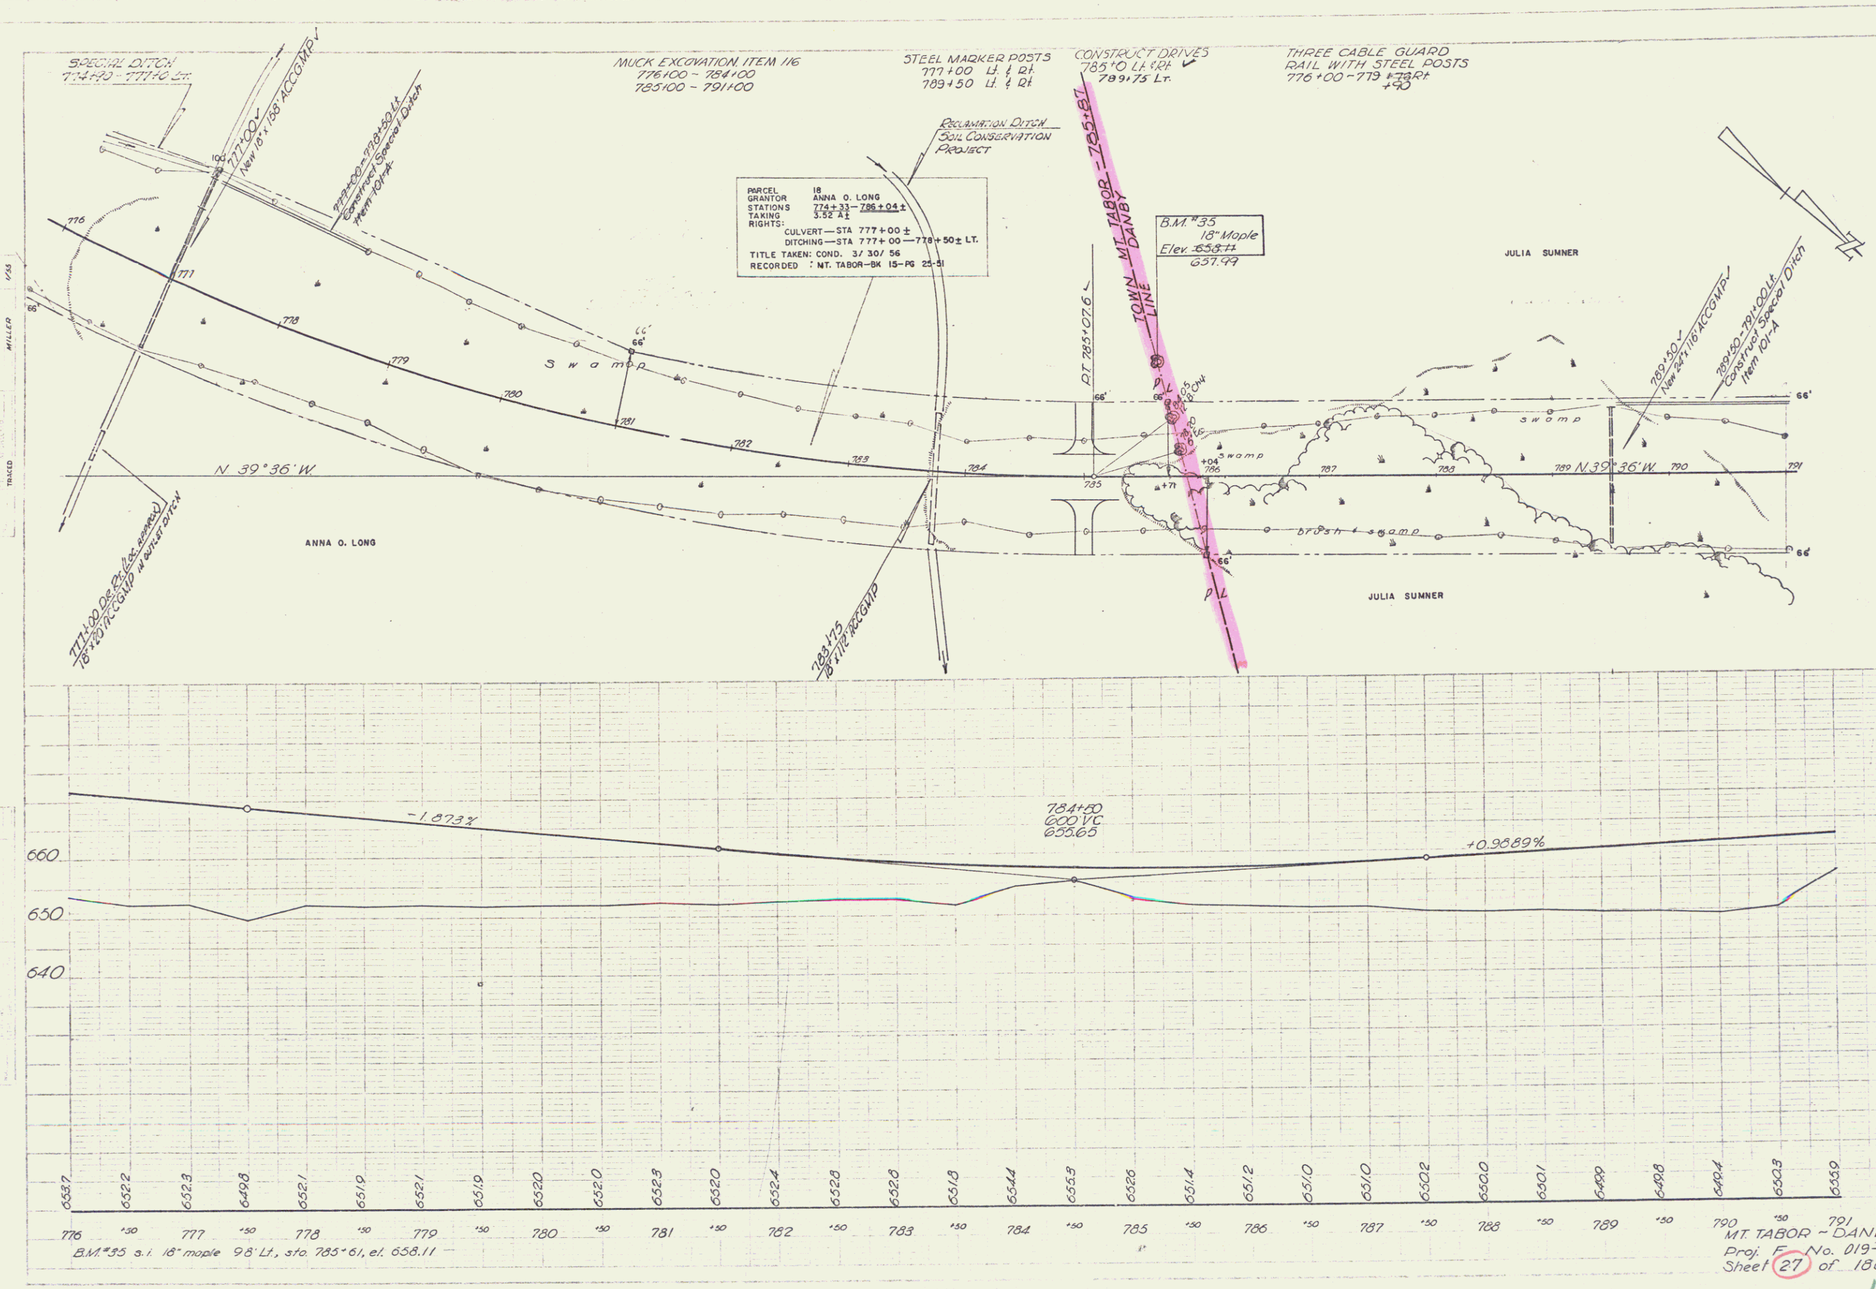
SPECIAL DITCH
774+70 - 777+70 Lt.
MUCK EXCAVATION ITEM 116
776+00 - 784+00
785+00 - 791+00
STEEL MARKER POSTS
777+00 Lt. & Rt.
789+50 Lt. & Rt.
CONSTRUCT DRIVES
785+10 Lt. & Rt.
789+75 Lt.
THREE CABLE GUARD
RAIL WITH STEEL POSTS
776+00 - 779+70 Rt
+90
777+00
New 18" x 118' ACCGMP
778+50 - 781+50 Lt.
Construct Special Ditch
Item 101-A
RECLAMATION DITCH
SOIL CONSERVATION
PROJECT
PARCEL 18
GRANTOR ANNA O. LONG
STATIONS 774+33 - 786+04 ±
TAKING 3.52 A±
RIGHTS:
CULVERT — STA 777+00 ±
DITCHING — STA 777+00 — 778+50 ± LT.
TITLE TAKEN: COND. 3/30/56
RECORDED : MT. TABOR - BK 15 - PG 25-51
TOWN LINE
MT. TABOR - DANBY
B.M. #35
18" Maple
Elev. 658.11
657.49
PT 785+07.6
JULIA SUMNER
swamp
N 39° 36' W.
ANNA O. LONG
brush & swamp
783+75
18" x 116' ACCGMP
789+50
New 24" x 116' ACCGMP
789+50 - 791+00 Lt.
Construct Special Ditch
Item 101-A
DRAWN MILLER
TRACED MILLER


-1.873%
+0.9889%
784+50
600 VC
655.65
660
650
640
653.7
652.2
652.3
649.8
652.1
651.9
652.1
651.9
652.0
652.0
652.3
652.0
652.4
652.8
652.8
651.8
654.4
655.9
656
651.4
651.2
651.0
651.0
650.2
650.0
650.1
649.9
649.8
649.4
652.3
655.9
776 +50 777 +50 778 +50 779 +50 780 +50 781 +50 782 +50 783 +50 784 +50 785 +50 786 +50 787 +50 788 +50 789 +50 790 +50 791
B.M. #35 s.i. 18" maple 9.8' Lt., sta. 785+61, el. 658.11
MT. TABOR - DANBY
Proj. F No. 019-2(1)
Sheet 27 of 188
17