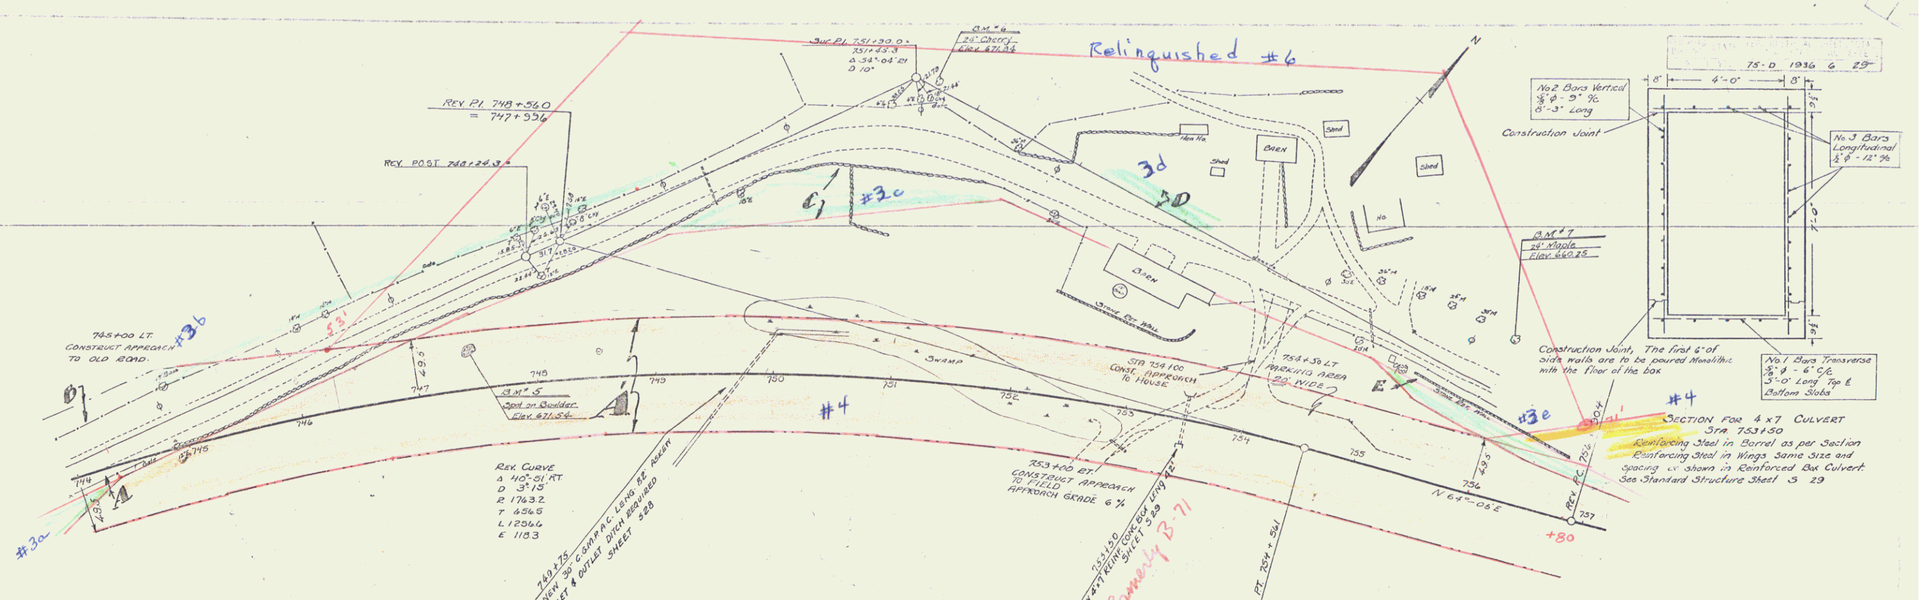

PARCEL	INSTRUMENT	DATE	GRANTOR	GRANTEE	RECORDED WALLINGFORD BOOK	PAGE	DATE	REMARKS
ABCDE	Q.C.D.	7-26-35	FLORA ROBERTS et. al.	STORYT.	25	216	7-31-35	
A'	W.D.	1-18-36	" " "	"	25	303	1-18-36	

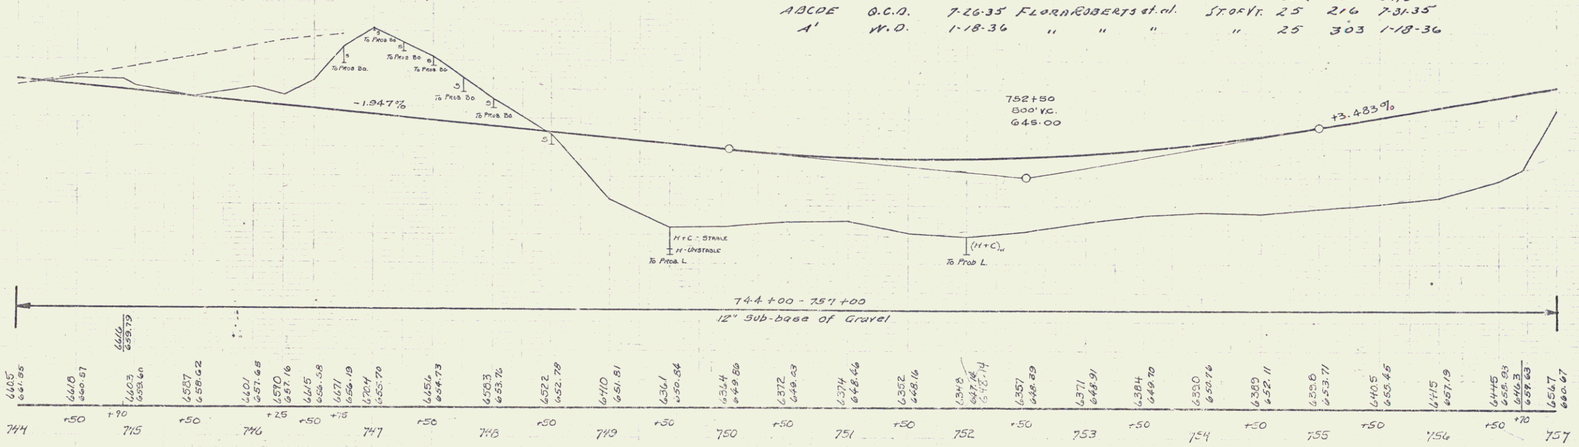

B.M. #5, Paint Spot on Boulder 28' Lt. Sta. 747+46 Elev. 671.54
B.M. #6, Spike in Root 24" Cherry 255' Lt. Sta. 751+16 Elev. 671.84
B.M. #7, " " " 24" Maple 134' Lt. Sta. 756+00 Elev. 660.25

Series E.A.P. No 75-0
Sheet 6 of 29

9