NOTE:- Any loose rock that is necessary to be removed on the left from the rock section Sta 878+00± To 885+00± is to be paid for as Common Excavation Incl. Borrow (Item 1610) or Solid Rock Excavation (Item 16) in accordance with the specifications, is to be used in the embankment Sta. 871+50 - 877+50.

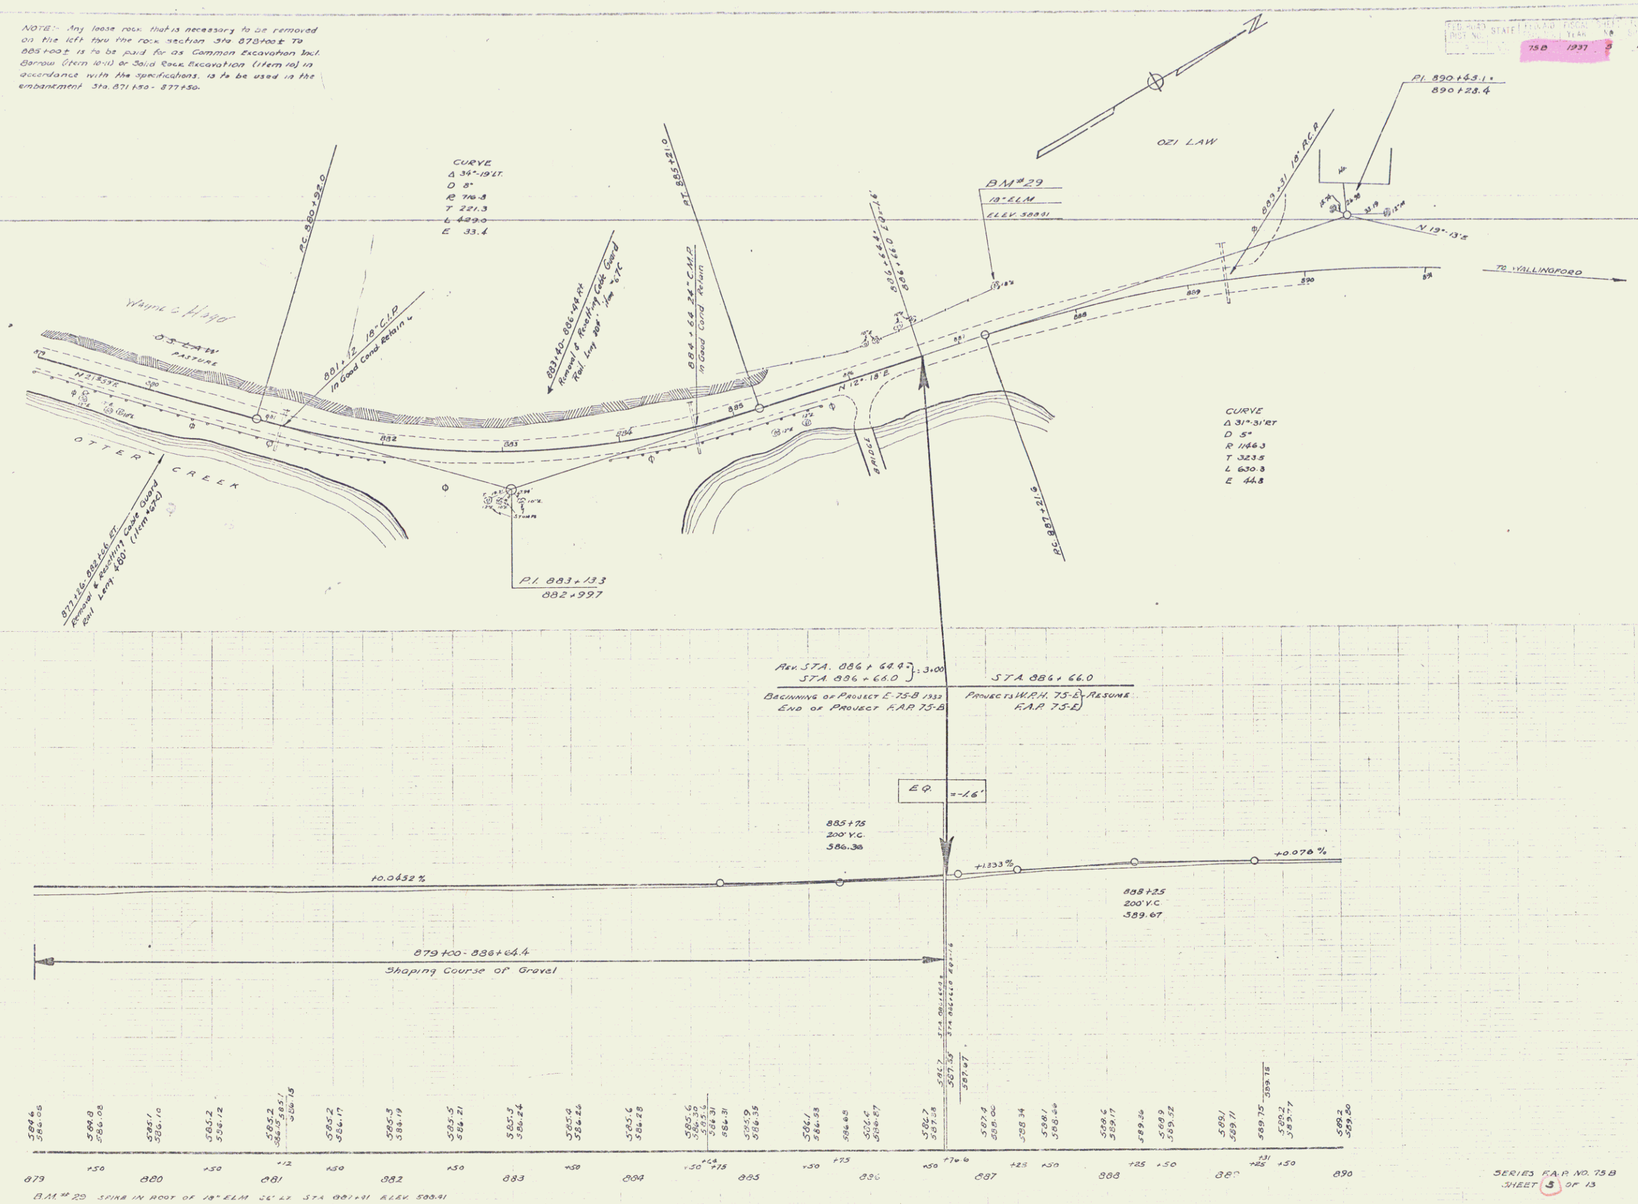

SERIES F.A.P. NO. 75 B
SHEET 3 OF 13

3