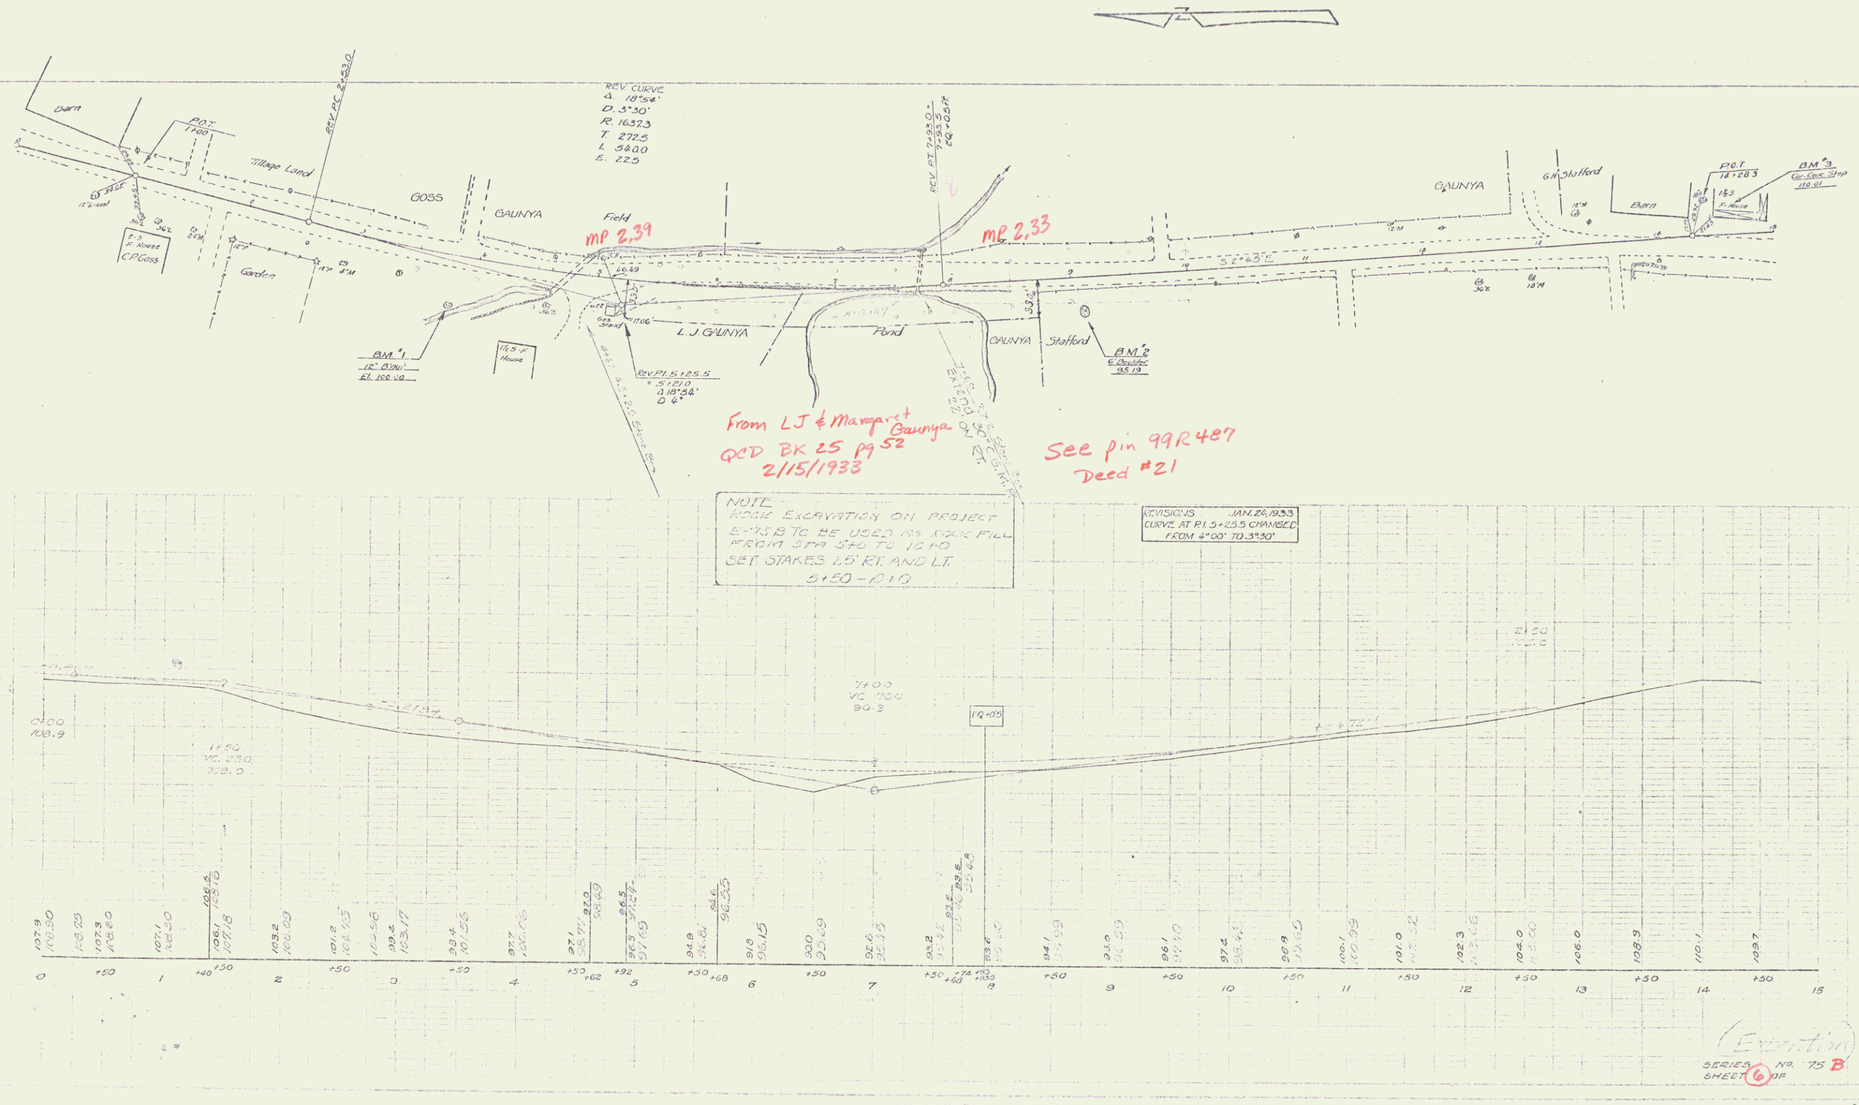

(Exception)

SERIES No. 75 B
SHEET 6 OF

6