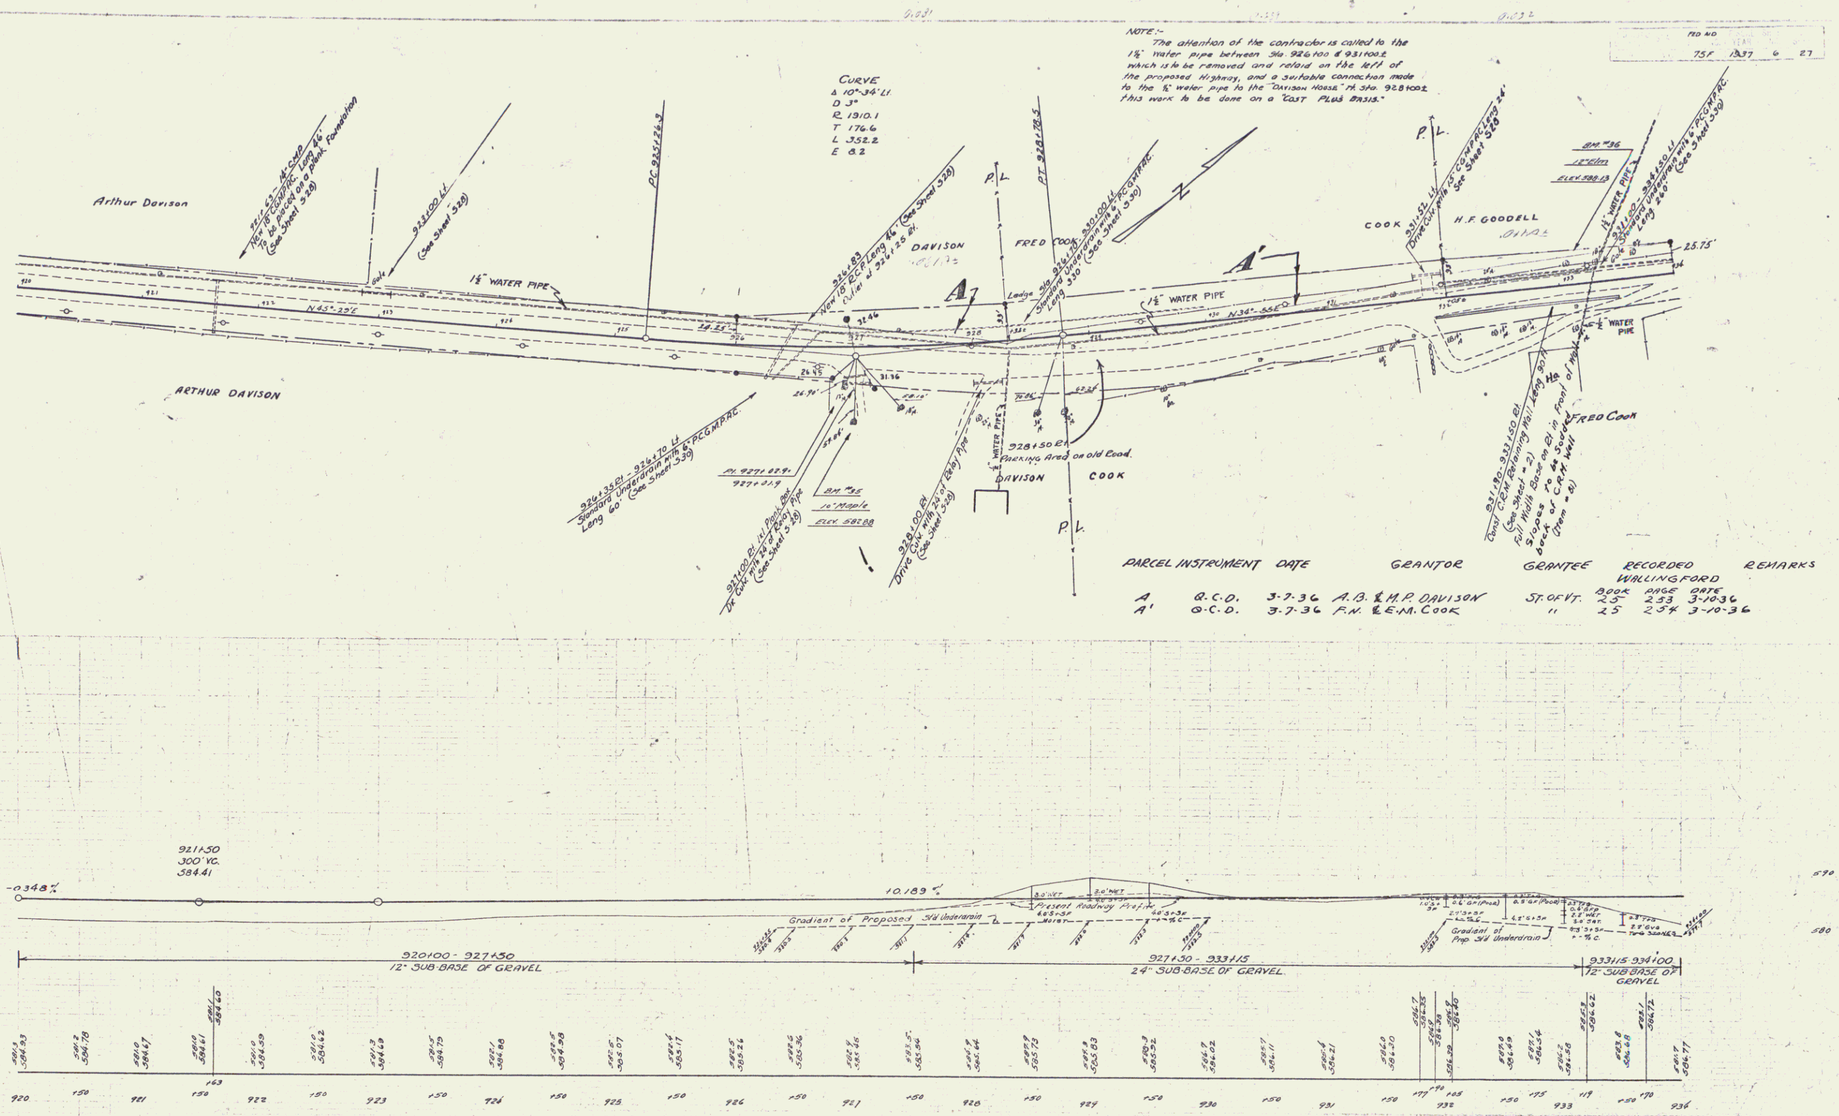

B.M. #35 Spike in Root of 10" Maple 63' Rt. Sta. 926+99 Elev. 582.88
B.M. #36 " " " 18" Elm 13' Lt. Sta. 933+07 Elev. 588.13

SERIES F.A.P. No. 75 F
SHEET 6 OF 27

4