FED AID			
75 F	1937	7	27

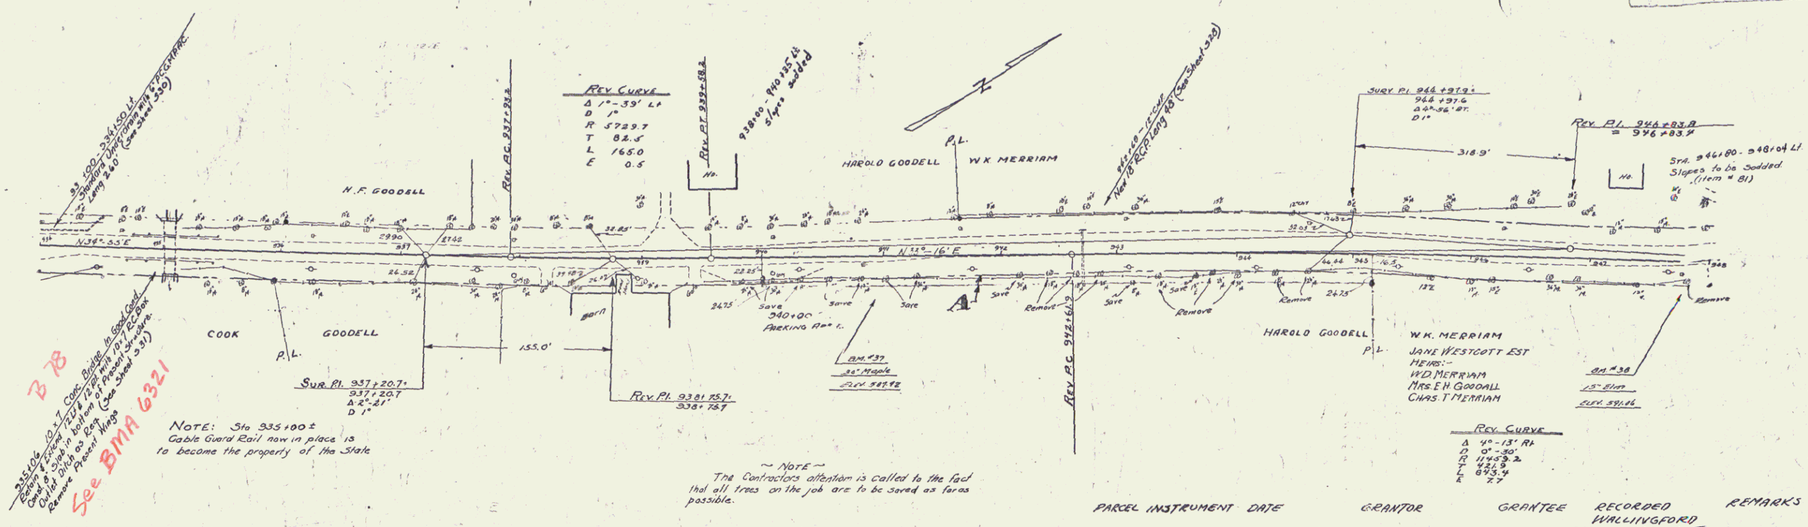

PARCEL	INSTRUMENT	DATE	GRANTOR	GRANTEE	RECORDED WALLINGFORD BOOK	PAGE	DATE	REMARKS
A	Q.C.D.	8-20-36	Beatrice C. Goodell	St. of Vt.	25	290	8-25-36	

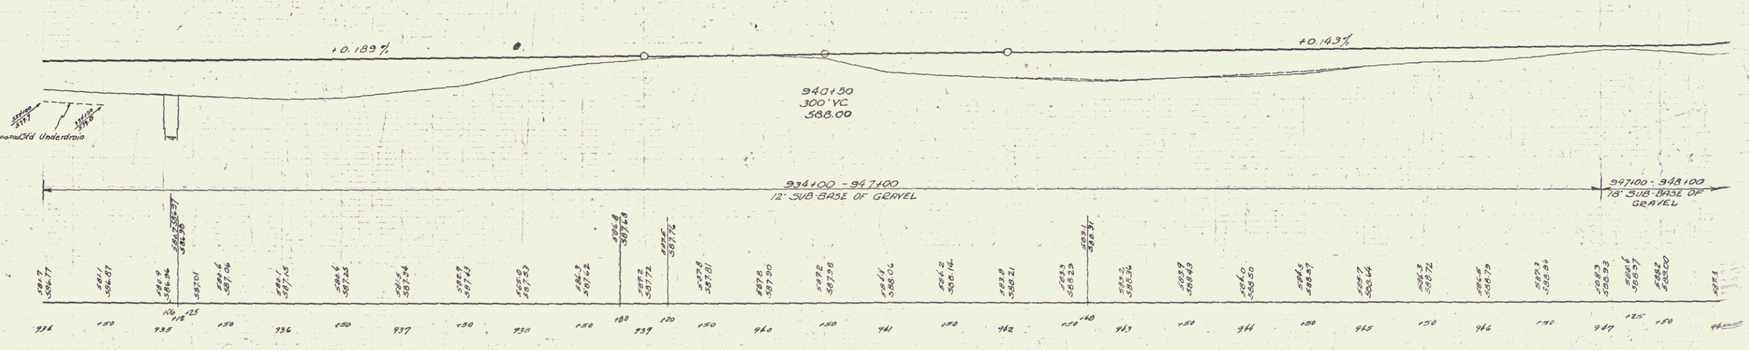

BM #37 Spike in Root of 34" Maple 23' Rt. Sta. 941+00 Elev. 587.72

BM #38 " " " 18" Elm 24' Rt. Sta. 947+78 Elev. 591.06

Series F Project No 75 F
Sheet 7 of 27

5