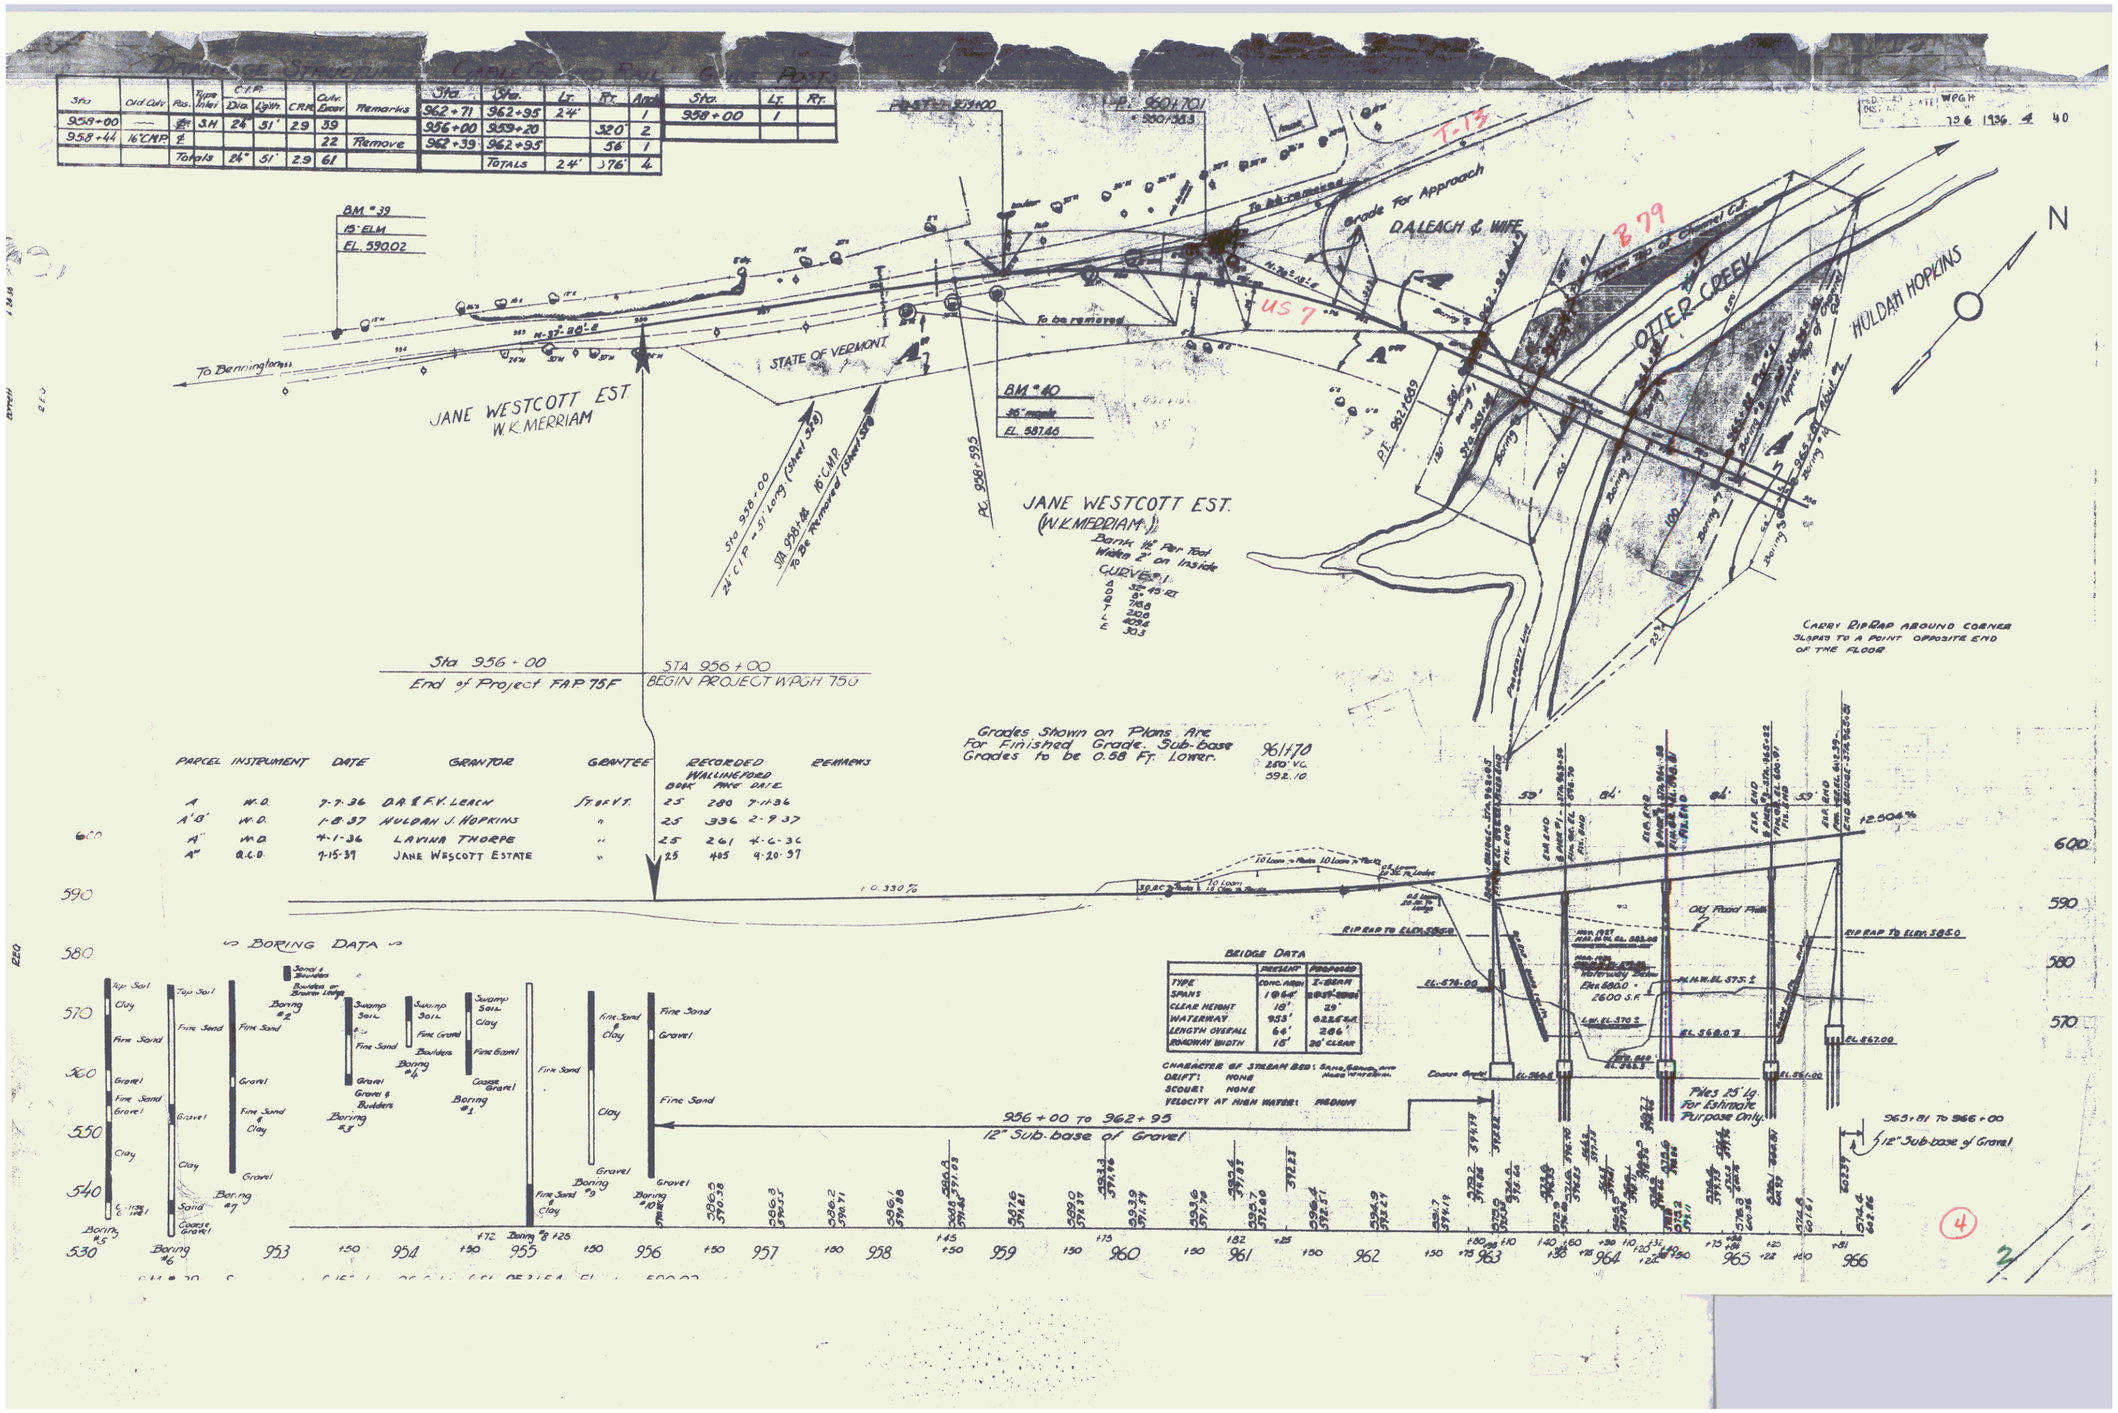
WPGH
BM #39
15" ELM
EL. 590.02
To Bennington
JANE WESTCOTT EST
W.K. MERRIAM
STATE OF VERMONT
To be removed
BM #40
36" maple
EL. 587.86
JANE WESTCOTT EST.
(W.K. MERRIAM)
Bank 12' Per Tool
Widen 2' on Inside
CURVES
Sta 956+00
End of Project FAP 75F
STA 956+00
BEGIN PROJECT WPGH 75U
Grades Shown on Plans Are
For Finished Grade. Sub-base
Grades to be 0.58 Ft. Lower.
PARCEL INSTRUMENT DATE GRANTOR GRANTEE RECORDED WALLINGFORD BOOK PAGE DATE REMARKS
A W.D. 7-7-36 O.A. & F.V. LEACH ST. OF VT. 25 280 7-11-36
A'B' W.D. 1-8-37 HULDAH J. HOPKINS " 25 336 2-9-37
A'' W.D. 4-1-36 LAVINA THORPE " 25 261 4-6-36
A''' Q.C.D. 9-15-37 JANE WESCOTT ESTATE " 25 405 9-20-37
DALEACH & WIFE
OTTER CREEK
HULDAH HOPKINS
N
CARRY RIPRAP AROUND CORNER
SLOPES TO A POINT OPPOSITE END
OF THE FLOOR.
BRIDGE DATA
TYPE
SPANS
CLEAR HEIGHT
WATERWAY
LENGTH OVERALL
ROADWAY WIDTH
CHARACTER OF STREAM BED:
DRIFT: NONE
SCOUR: NONE
VELOCITY AT HIGH WATER: MEDIUM
956+00 TO 962+95
12" Sub-base of Gravel
Piles 25' Lg
For Estimate
Purpose Only.
965+81 TO 966+00
12" Sub-base of Gravel
RIP RAP TO ELEV. 580.0
Old Road Fill
BORING DATA
Top Soil
Clay
Fine Sand
Gravel
Coarse Gravel
Swamp Soil
Boulders
Fine Gravel
Gravel & Boulders
Boring #1
Boring #2
Boring #3
Boring #4
Boring #5
Boring #6
Boring #7
Boring #8
Boring #9
Boring #10