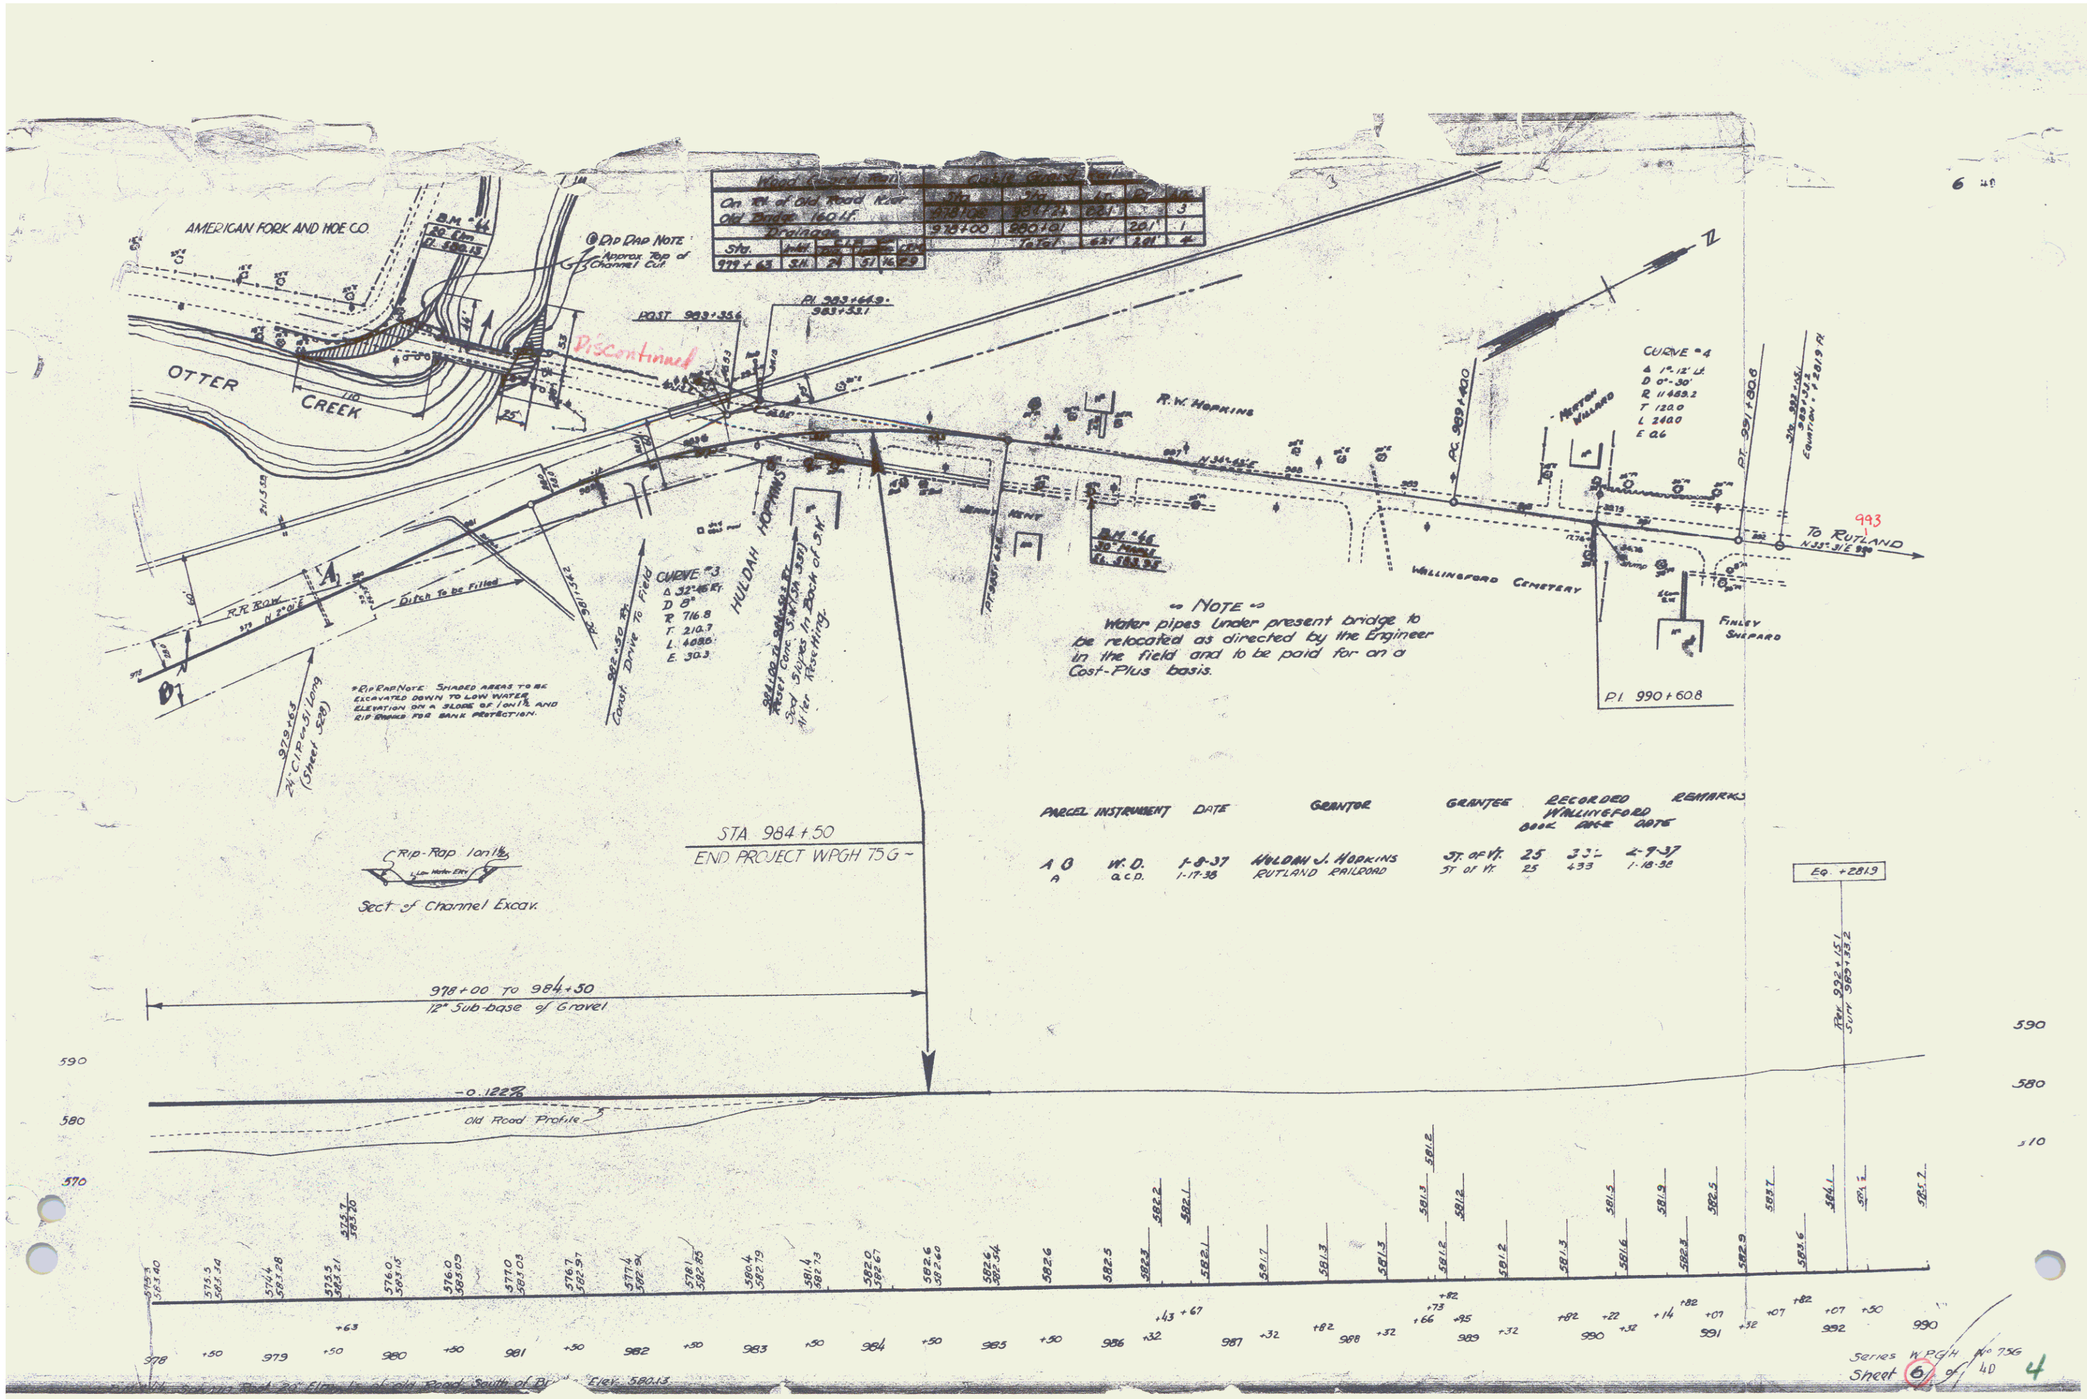

Note

Water pipes under present bridge to be relocated as directed by the Engineer in the field and to be paid for on a Cost-Plus basis.

Parcel	Instrument	Date	Grantor	Grantee	Recorded Wallingford Book	Page	Date	Remarks
A	W.D.	1-8-37	Holdan J. Hopkins	St. of Vt.	25	33	4-9-37	
A	Q.C.D.	1-17-38	Rutland Railroad	St. of Vt.	25	433	1-18-38	