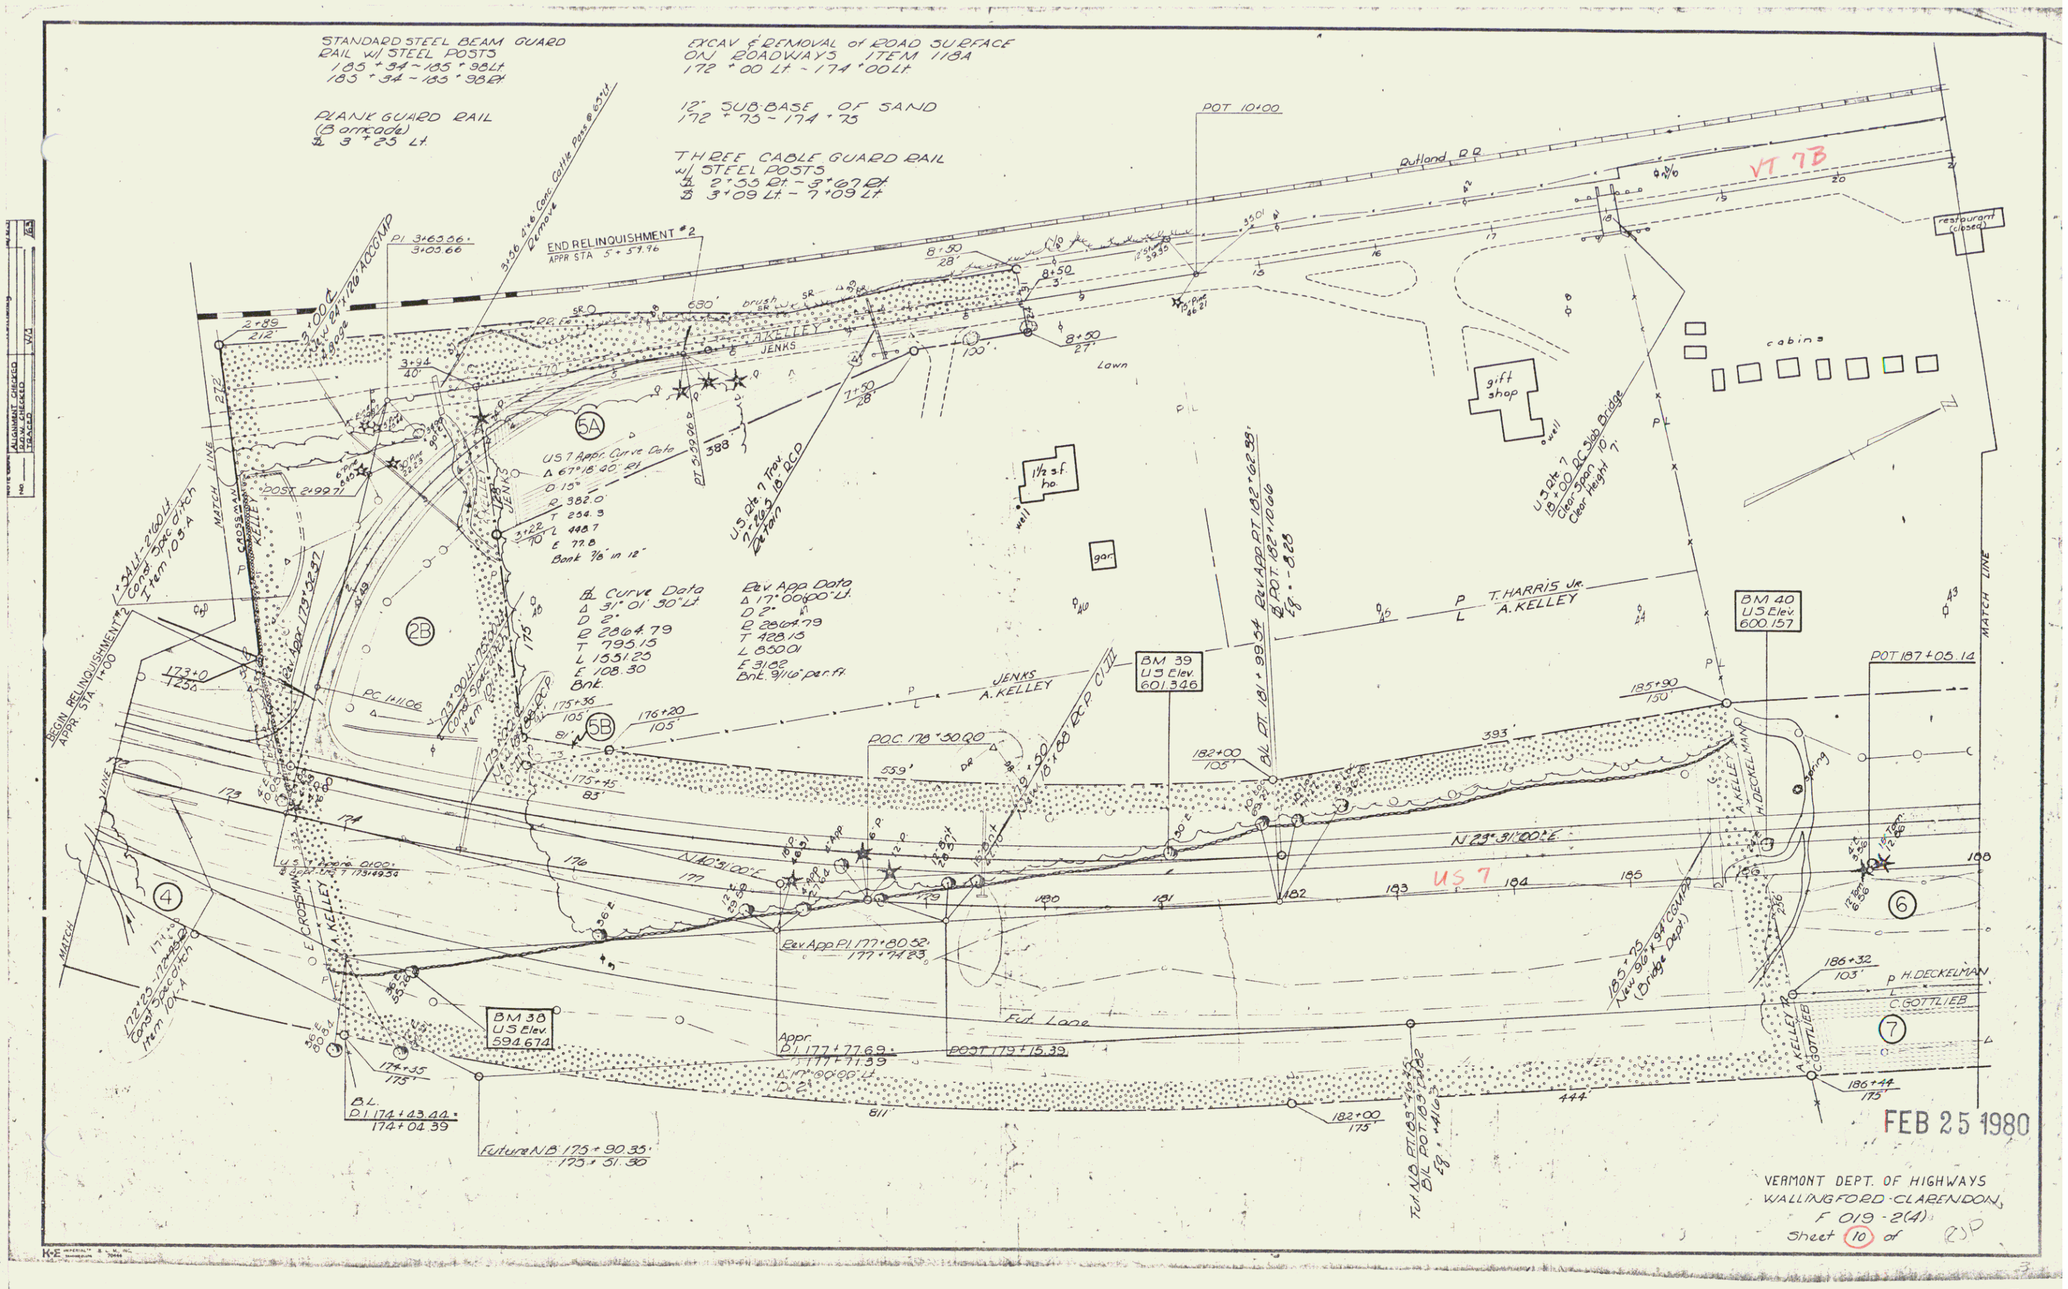
STANDARD STEEL BEAM GUARD RAIL w/ STEEL POSTS
185 + 34 ~ 185 + 98 Lt
185 + 34 ~ 185 + 98 Rt
PLANK GUARD RAIL (Barricade)
3 + 23 Lt.
EXCAV & REMOVAL of ROAD SURFACE ON ROADWAYS ITEM 118A
172 + 00 Lt. ~ 174 + 00 Lt.
12" SUB-BASE OF SAND
172 + 75 ~ 174 + 75
THREE CABLE GUARD RAIL w/ STEEL POSTS
2 + 53 Rt ~ 3 + 67 Rt
3 + 09 Lt. ~ 7 + 09 Lt.
POT 10+00
Rutland RR
VT 7B
restaurant (closed)
END RELINQUISHMENT #2
APPR STA 5 + 57.76
PI 3+65.66
3+03.66
JENKS
A. KELLEY
Lawn
gift shop
cabins
US 7 Appr. Curve Data
US Alt. 7 Trav. 7+62.3 18 DCD Zetton
US Alt. 7 18+00 RC Slab Bridge Clear Span 10' Clear Height 7'
1½ s.f. ho.
gar
T. HARRIS Jr.
A. KELLEY
BM 40 US Elev. 600.157
BM 39 US Elev. 601.346
BM 38 US Elev. 594.674
POT 187+05.14
MATCH LINE
BEGIN RELINQUISHMENT #1 APPR. STA 1+00
POST 219.97
POC 178+50.00
N 40°31'00" E
N 29°31'00" E
US 7
Rev. App. PI 177+80.52
177+74.23
Fd. Lane
Appr. PI 177+77.69
177+71.39
POST 179+15.39
BL PI 174+43.44
174+04.39
Future N.B. 175+90.35
175+51.30
H. DECKELMAN
C. GOTTLIEB
FEB 25 1980
VERMONT DEPT. OF HIGHWAYS
WALLINGFORD-CLARENDON
F 019-2(4)
Sheet 10 of 25

3