CONSTRUCT DRIVE
237+25 Rt.
243+84 Rt.

12" SUB-BASE OF SAND
242+50 - 250+25

CONST. BARRICADE
(WOOD GUIDE POSTS)
@ 7+00 Rt.

BIT CONC CURB
236+00 - 237+06

THREE CABLEGUARD RAIL
W/STEEL POSTS
236+00 - 237+06 Lt

REMOVAL & DISPOSAL OF
PRESENT GUARD RAIL
ITEM 550
250+00 - 252+00 Lt.

EXCAVATION & REMOVAL OF
ROAD SURFACE ON ROAD-
WAYS. ITEM 118-A
248+00 Lt. - 252+00 Lt.

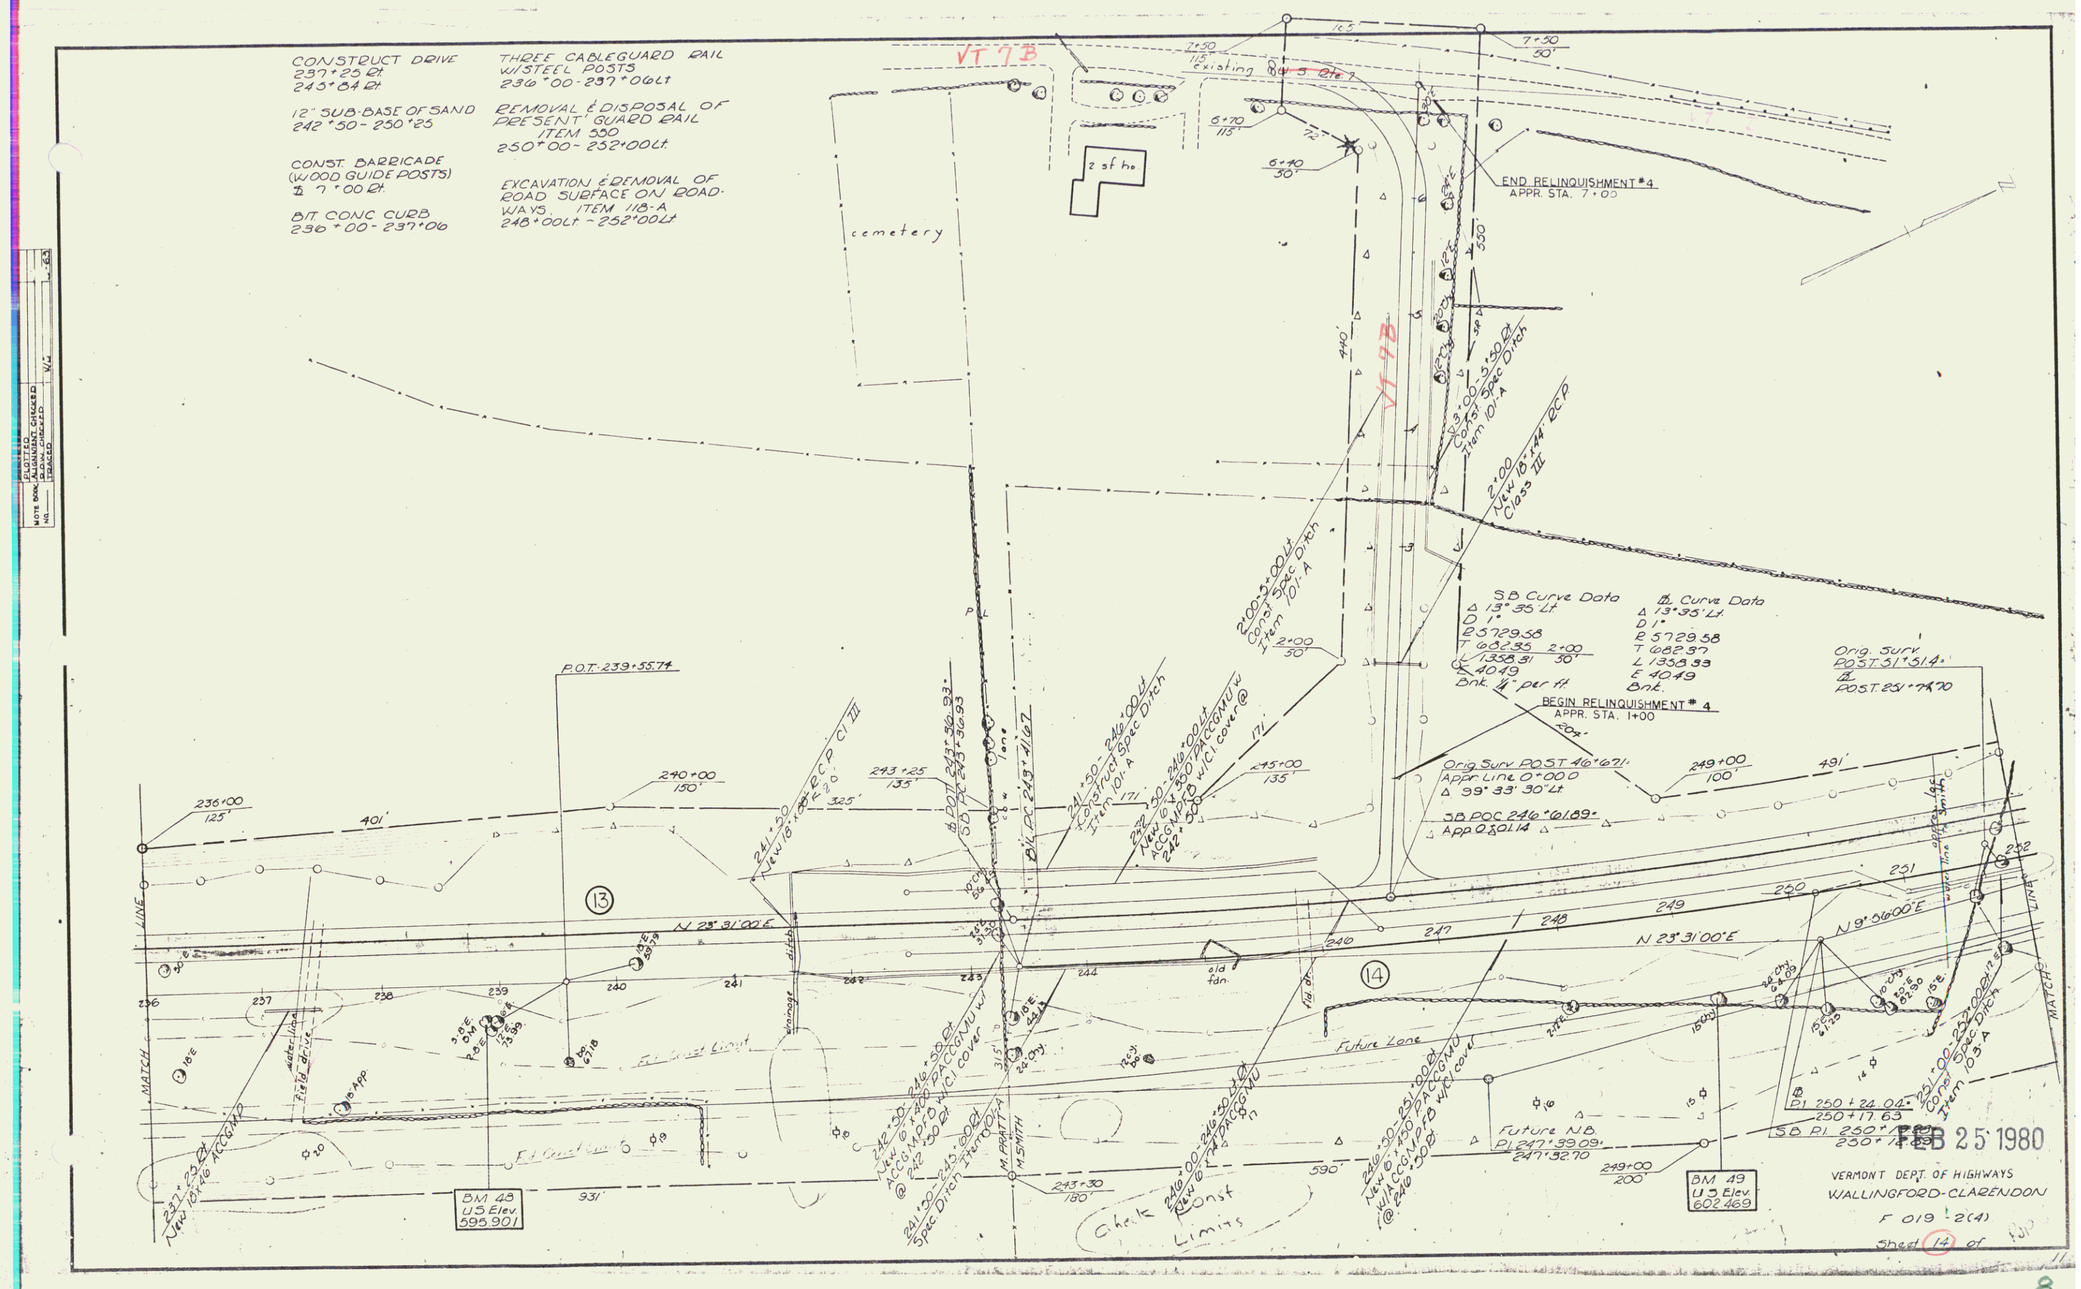

8