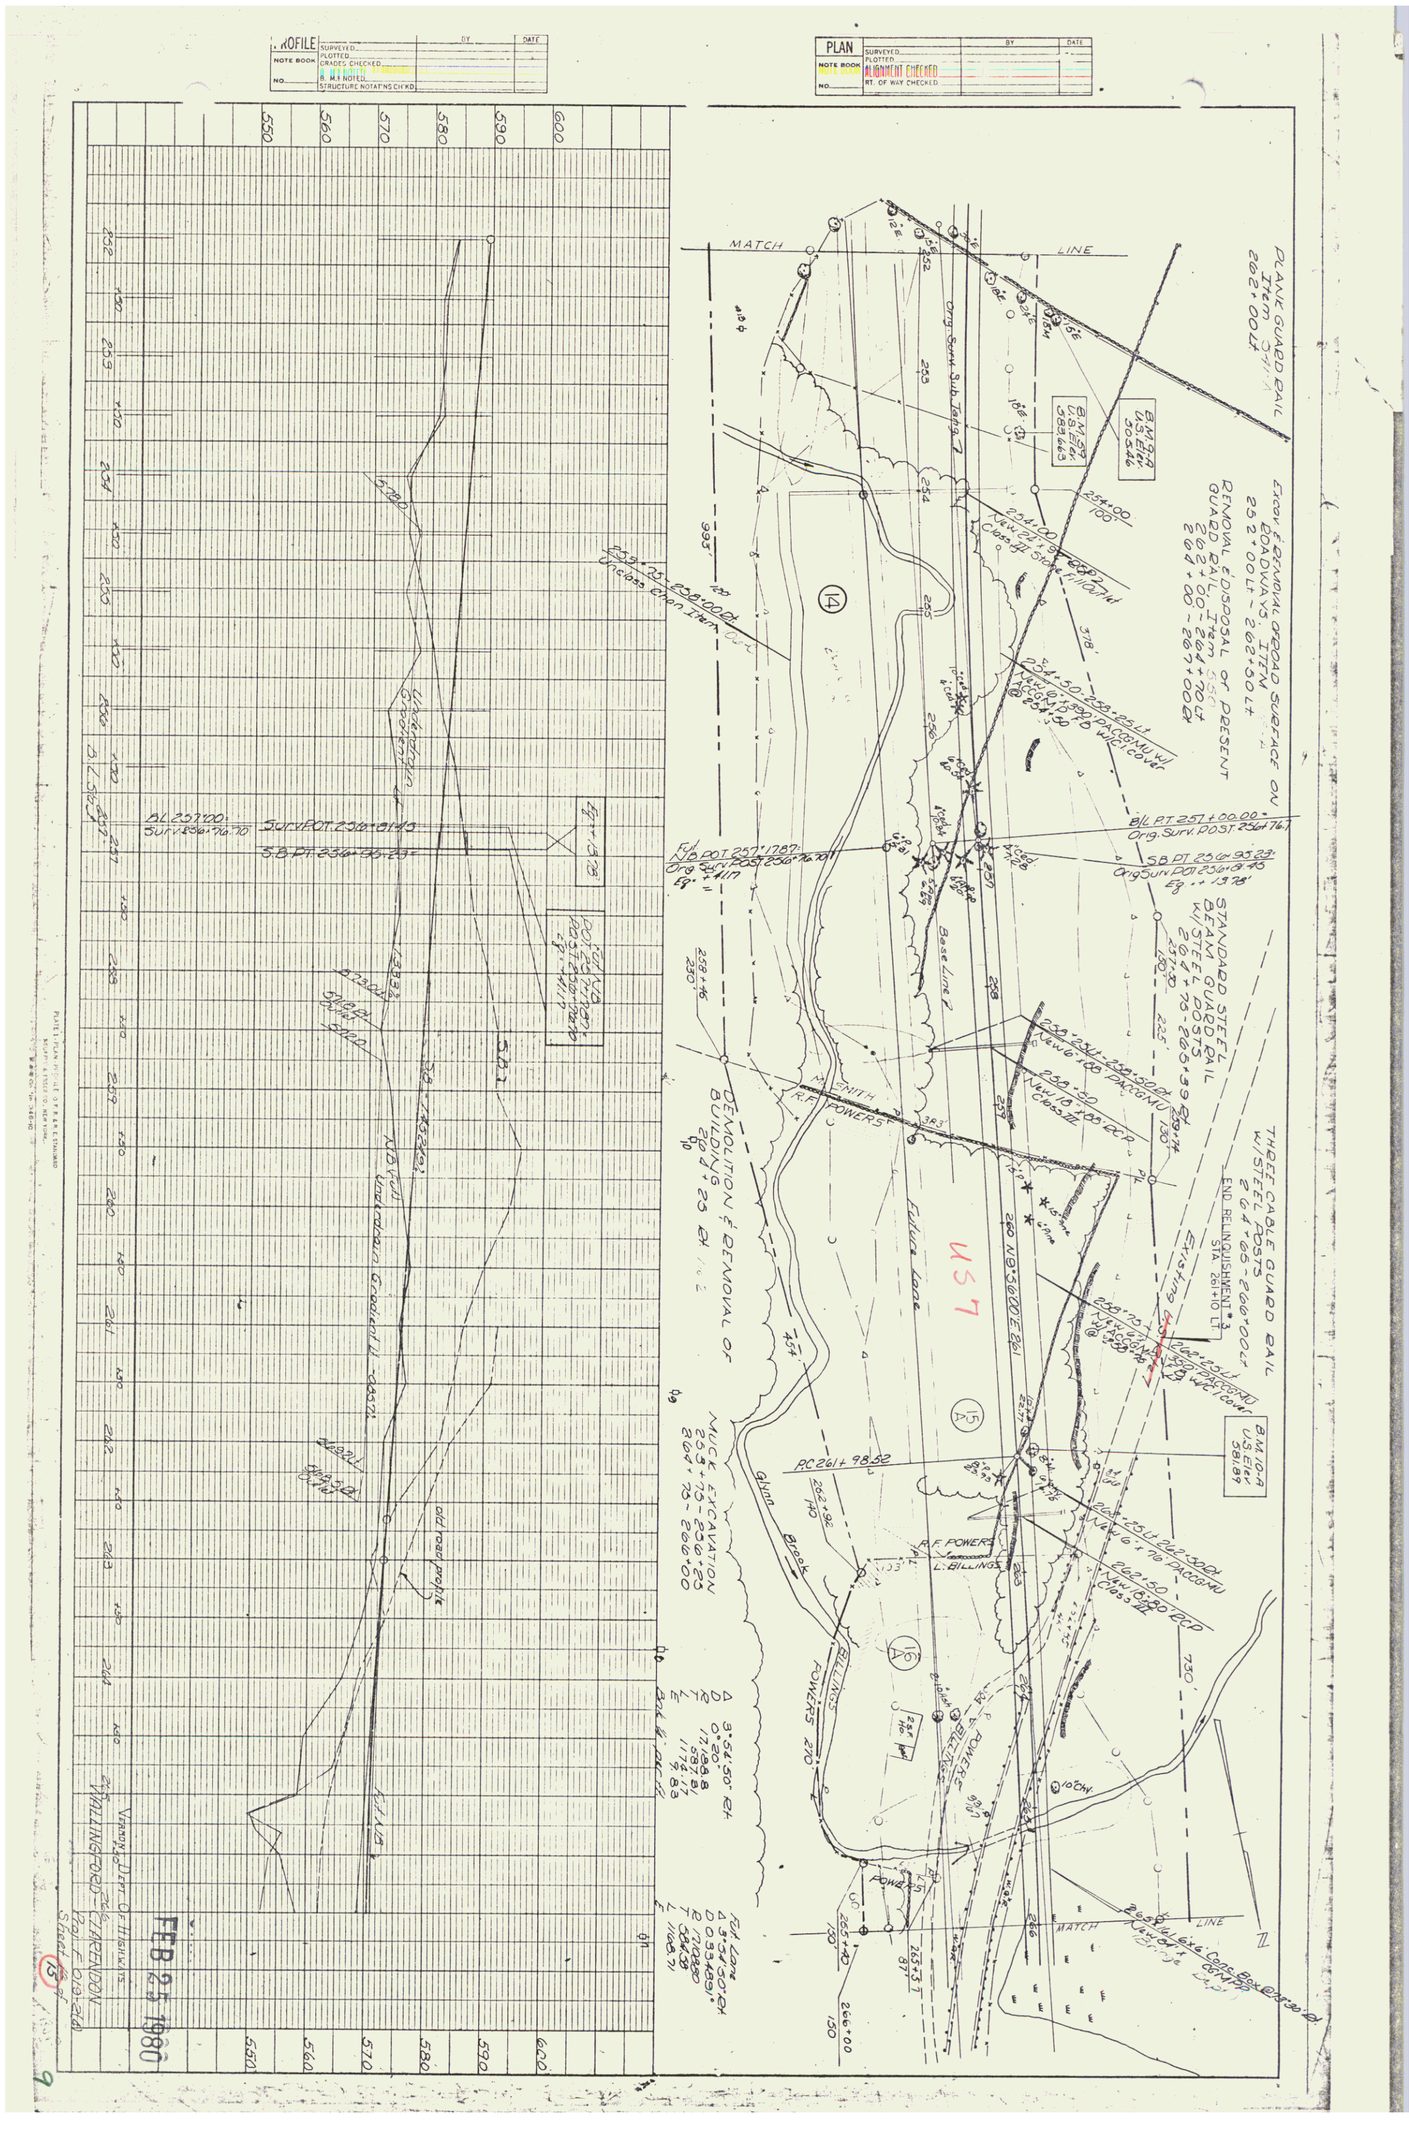
PROFILE
PLAN
ALIGNMENT CHECKED
MATCH LINE
DEMOLITION & REMOVAL OF BUILDING 23 EA
MUCK EXCAVATION
Vermont Dept. of Highways
WALLINGFORD - CLARENDON
FEB 25 1980