

PLAN  
 SURVEYED  
 CALCULATED  
 PLANNED  
 CHECKED  
 NO. OF SHEETS CHECKED  
 NO. OF SHEETS

PROFILE  
 SURVEYED  
 CALCULATED  
 PLANNED  
 CHECKED  
 NO. OF SHEETS CHECKED  
 NO. OF SHEETS

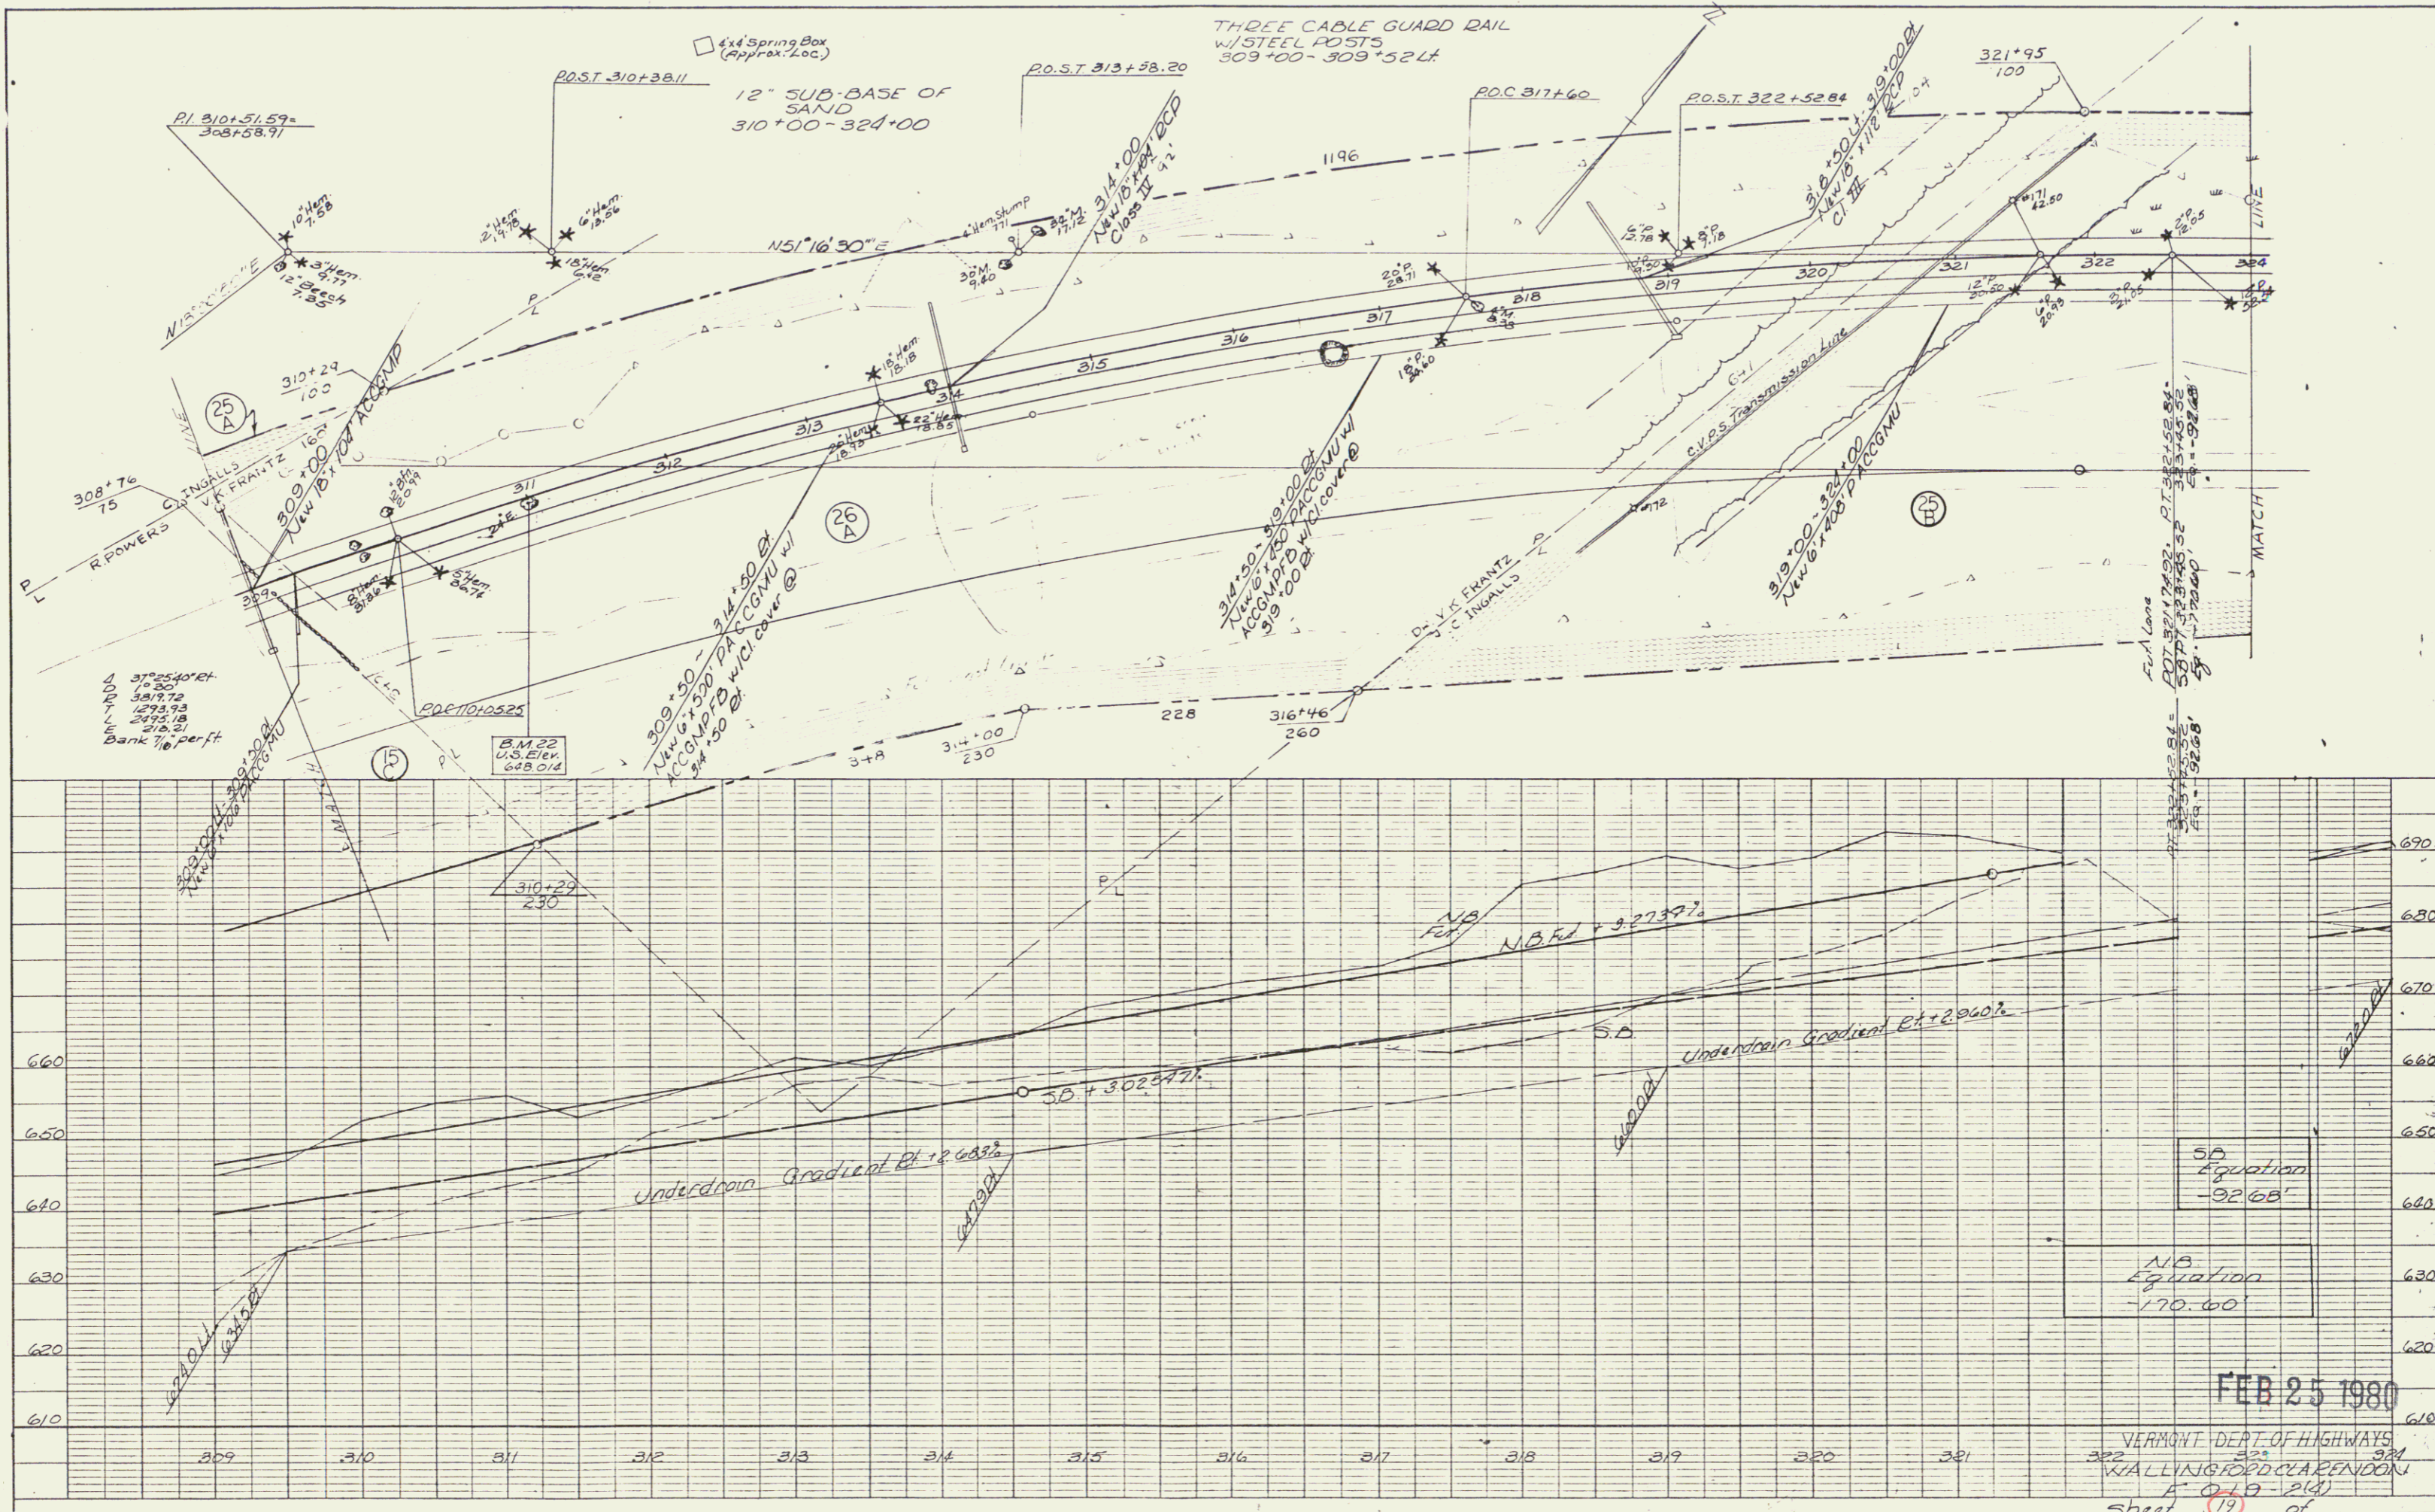


PLATE 1 PLAN PROFILE ONLY STANDARD  
 BEUTEL & ESSER CO. NEW YORK  

FEB 25 1980  
 VERMONT DEPT. OF HIGHWAYS  
 322-323  
 WALLINGFORD CLARENDOON  
 Sheet 19 of 14