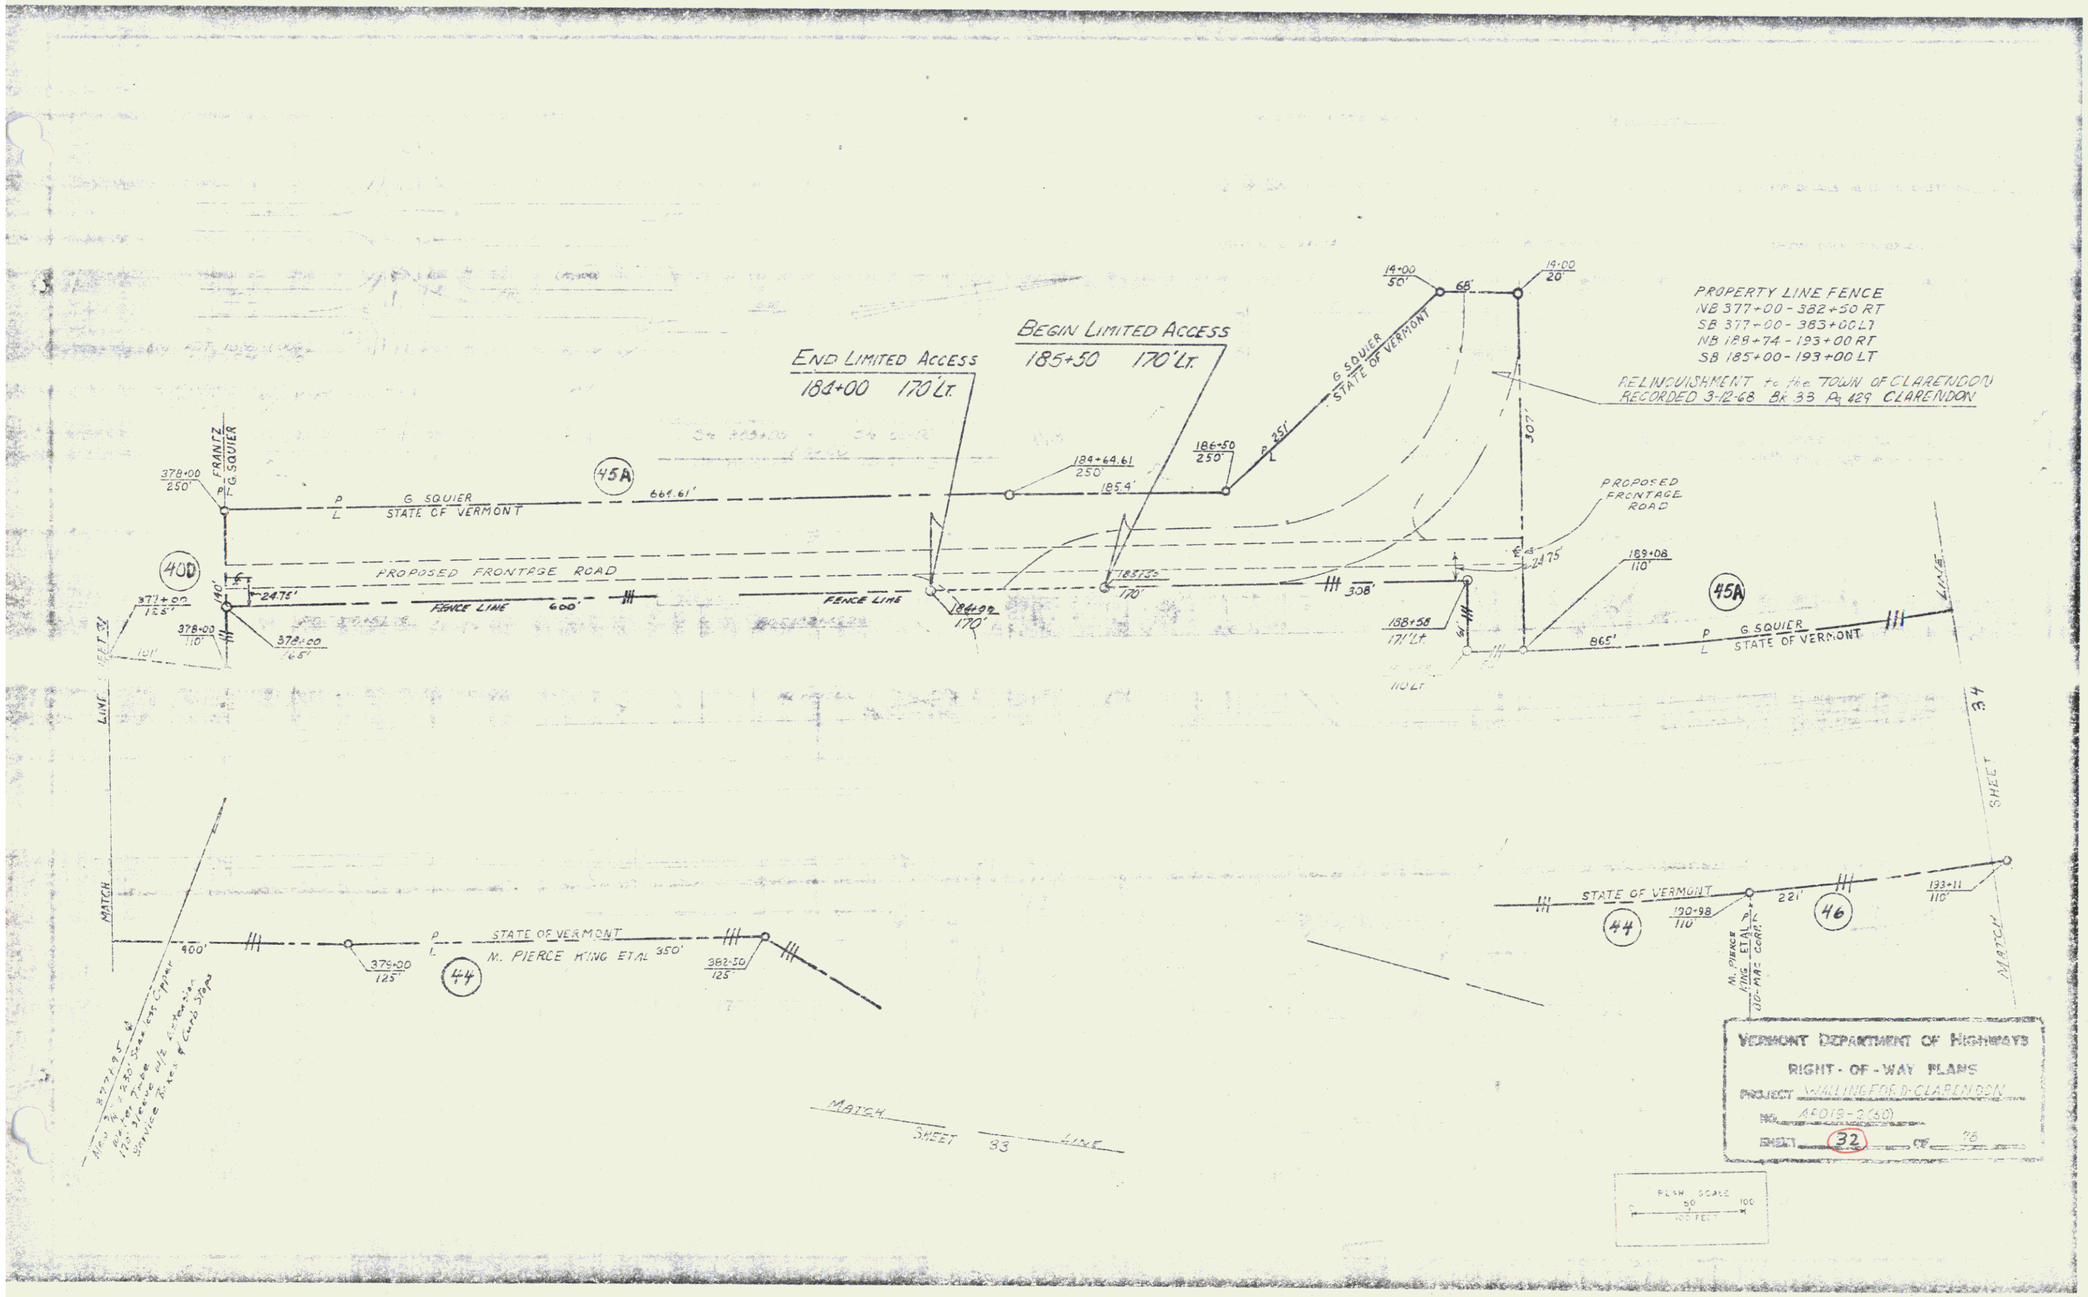
END LIMITED ACCESS
184+00 170' Lt.
BEGIN LIMITED ACCESS
185+50 170' Lt.
PROPERTY LINE FENCE
NB 377+00 - 382+50 RT
SB 377+00 - 383+00 LT
NB 188+74 - 193+00 RT
SB 185+00 - 193+00 LT
RELINQUISHMENT to the TOWN OF CLARENDON
RECORDED 3-12-68 BK 33 Pg 429 CLARENDON
FRANTZ
G. SQUIER
G. SQUIER
STATE OF VERMONT
PROPOSED FRONTAGE ROAD
FENCE LINE
M. PIERCE MING ETAL
MATCH LINE
MATCH SHEET 33 LINE
MATCH SHEET 34
VERMONT DEPARTMENT OF HIGHWAYS
RIGHT-OF-WAY PLANS
PROJECT WALLINGFORD-CLARENDON
NO. AC019-2(30)
SHEET 32 OF 78
PLAN SCALE
50 100
FEET