STANDARD STEEL BEAM GUARD RAIL w/ STEEL POSTS
162 + 81 - 163 + 35 Rt. Item 545-A

THREE CABLE GUARD RAIL w/ STEEL POSTS, Item 542
161 + 50 - 163 + 90 Lt.
166 + 00 - 172 + 08 Lt.
CHARLES J. 167 + 50 - 172 + 14 Rt. Lt.
RUTH R. TARPLEY + 50 - 172 + 15 Rt.

BITUMINOUS CONCRETE CURB - Item 555
167 + 50 - 172 + 08 Rt.
170 + 00 - 172 + 08 Lt.

REMOVAL & DISPOSAL OF PRESENT GUARD RAIL
ITEM 549
161 + 80 - 163 + 40 Lt.
163 + 50 - 171 + 25 Lt.

CONSTRUCT DRIVE
162 + 10 Rt.

CONSTRUCT APPROACH
163 + 85 Rt.
164 + 50 Lt.

EXCAV & REMOVAL OF ROAD SURFACE AND/OR PAVEMENTS
ITEM 119
166 + 50 Lt. - 172 + 00 Lt.

PLANK GUARD RAIL, Item 540
170 + 00 Lt.
(Barricade)

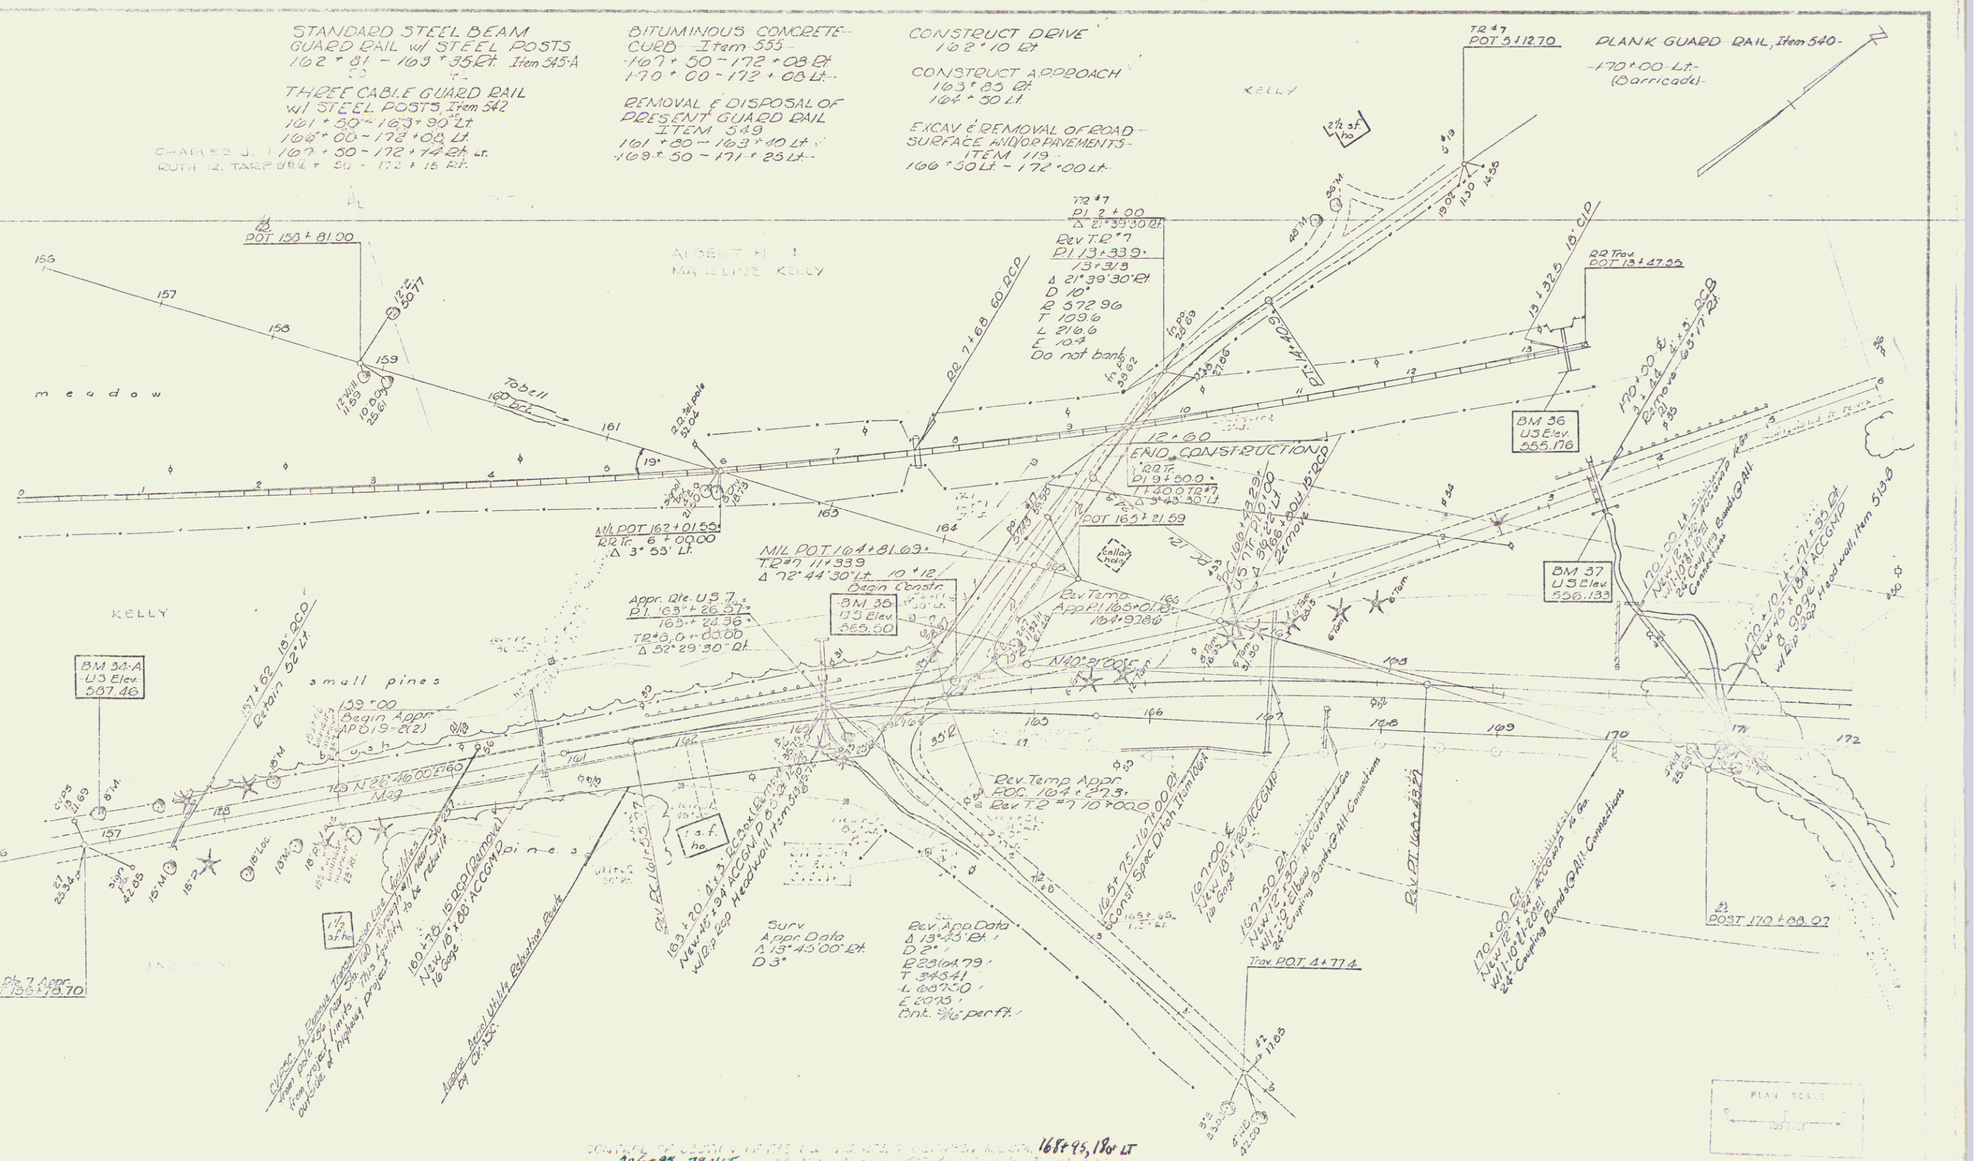

Sheet 27 of 52

2