SEEDING, ITEM 611
FERTILIZER, ITEM 615
TOPSOIL, ITEM 621

[illegible] Rt.
[illegible] Rt.
[illegible] Rt.
[illegible] Rt.
[illegible] Lt.
[illegible] Lt.
[illegible] Lt.
350+30-352+94 Lt.
353+19-353+99 Lt.
363+75-363+89 Rt.

353+69-355+39 Lt.
355+01-355+77 Lt.
357+09-357+73 Lt.
357+65-360+02 Lt.
360+37-360+92 Lt.
361+27-362+21 Lt.
362+56-363+42 Lt.

CONSTRUCT DRIVES

Lt.
[illegible] +80
350+03 PAVE
353+69 PAVE+00
[illegible] +90
[illegible] +60
360+19.5 PAVE
[illegible] PAVE
[illegible] PAVE
361+09.5 PAVE

Rt.
~~348+00.5~~ PAVE
[illegible] PAVE +75
~~350+45.5~~ PAVE +50
~~355+42.5~~ +25
357+25.5 PAVE
~~358+49.5~~ PAVE +25
~~363+66.0~~ +50
359+25
359+60
361+50

SEWARD RD. 1+00 Lt.

REMOVAL OF CONCRETE PAVEMENT
ITEM 103-B
343+00 - 356+86
361+00 - 364+00

COLORED SYNTHETIC BINDER CONCRETE
ITEM 374
348+00 - 364+00

VERTICAL GRANITE CURB, ITEM 556-P

Lt.
[illegible]
[illegible]
[illegible]
RAD. 353+19 - 353+99
353+69-355+69
356+04-356+73
357+08-357+30
357+65-360+02
360+37-360+92
361+27-362+21
362+56-363+42

Rt.
[illegible]
[illegible]
[illegible]
[illegible]
356+60-357+08
357+43-358+23
358+58-363+57
363+75-363+89

5" ONE COURSE CEMENT CONCRETE SIDEWALK, ITEM 560

Lt.
[illegible]
[illegible]
[illegible]
[illegible]
360+42-360+87
362+61-363+37
361+82-362+18
[illegible]

Rt.
361+38-362+84
[illegible]
[illegible]

8" ONE COURSE CEMENT CONCRETE SIDEWALK, ITEM 560

Lt.
[illegible]
[illegible]
[illegible]
359+97-360+42
362+16-362+51
363+37-364+00
360+87-361+32
[illegible]

Rt.
363+84-364+00

GRANITE SLOPE EDGING, ITEM 556-A
[illegible] +ISLAND AT 357+29 Lt.
BEHIND RADIUS PIECE

GALVANIZED CHAIN LINK FENCE 6' HIGH
ITEM 581-1
361+38-363+58 RT.

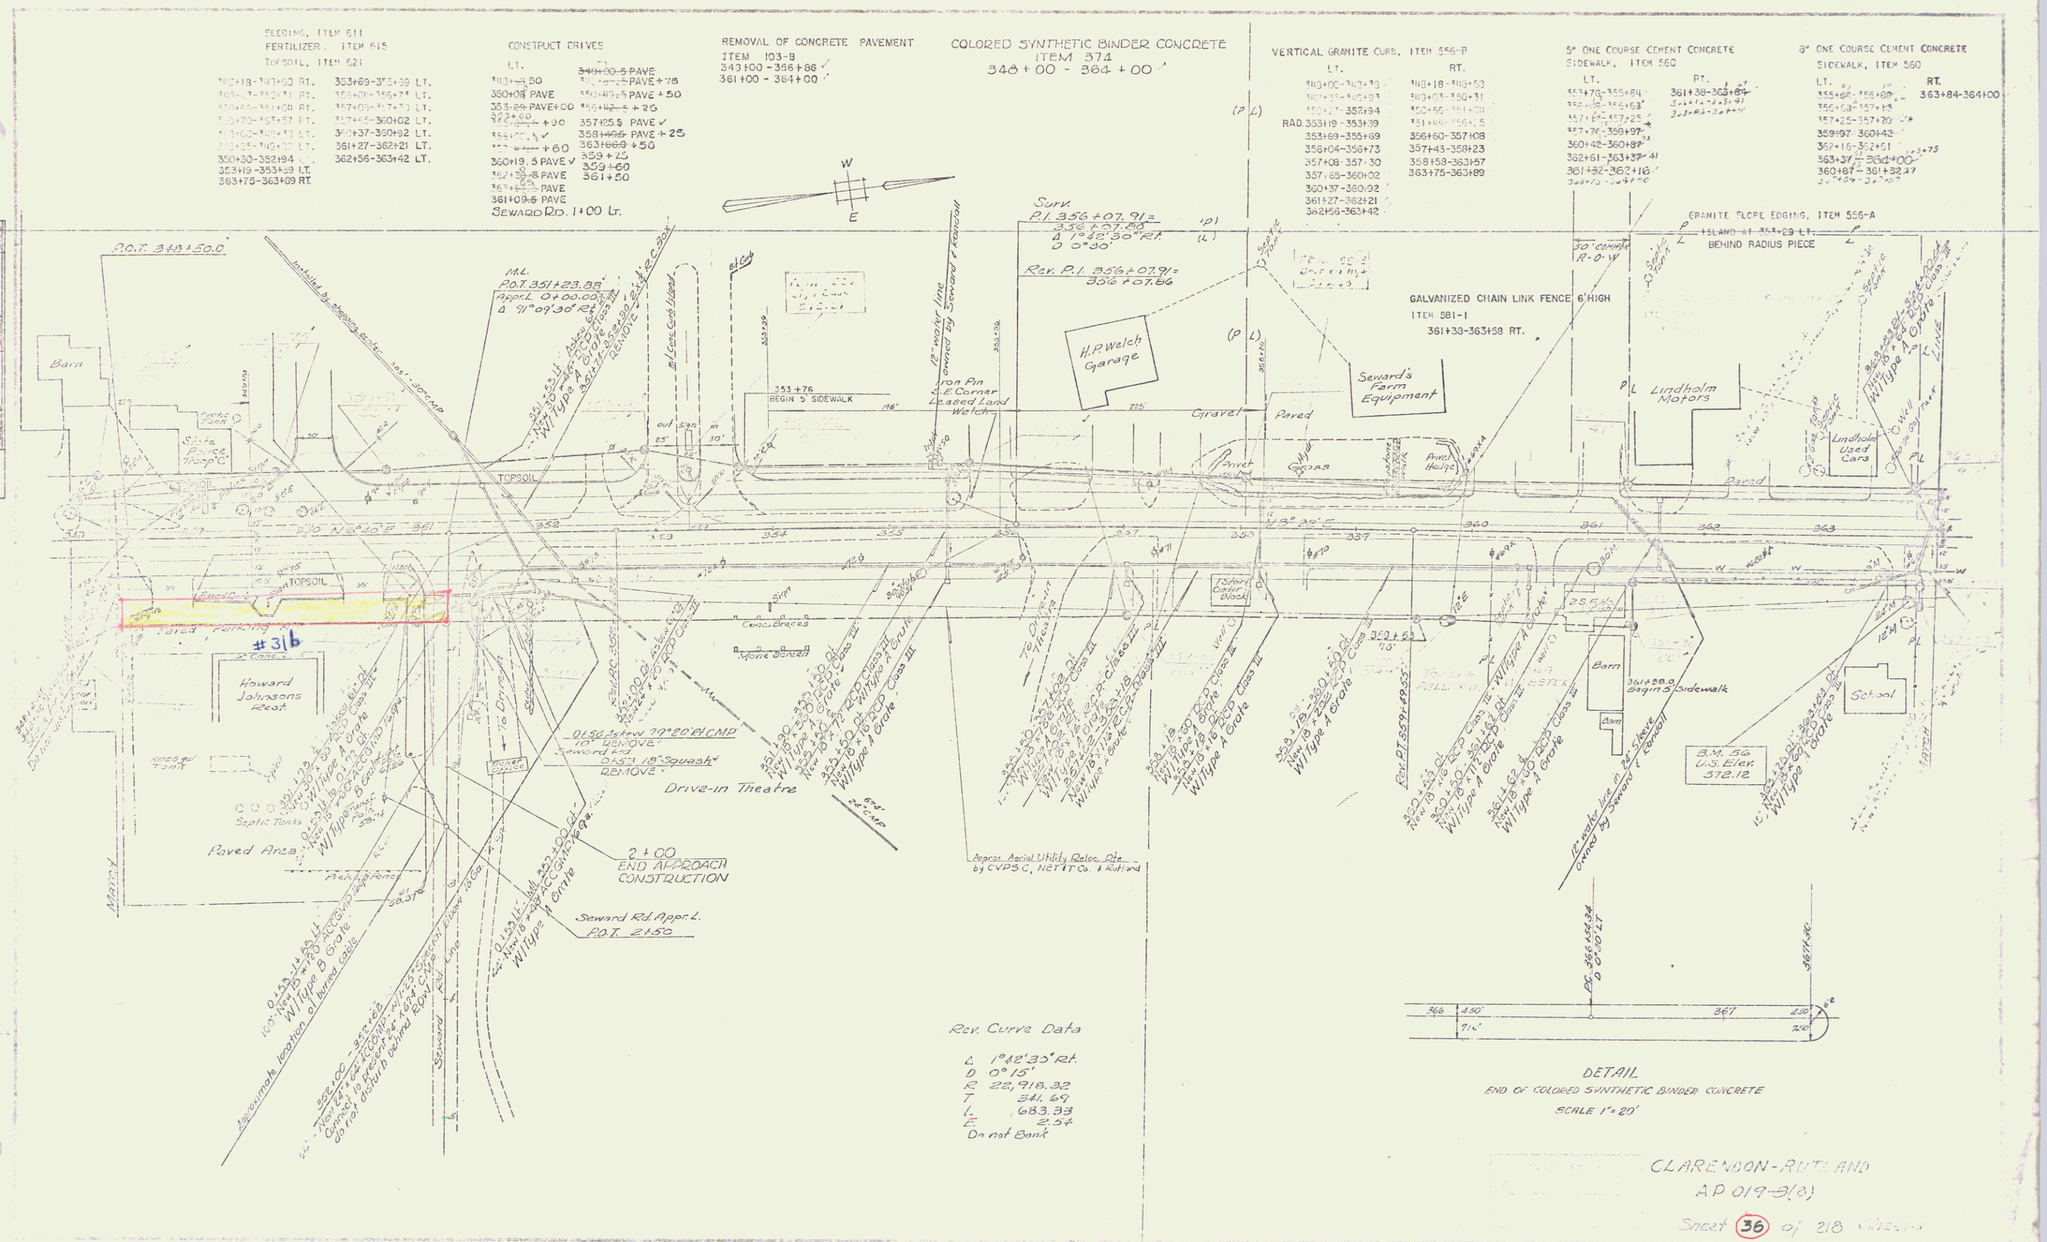

CLARENDON-RUTLAND
AP 019-3(8)

Sheet 36 of 218 Sheets

28