SEEDING, ITEM 611
FERTILIZER, ITEM 615
TOPSOIL, ITEM 621

364+17-365+74 LT.
365+00-365+29 LT.
365+67-366+91 LT.
364+24-365+50 RT

365+95-366+46 RT.
365+87-367+47 RT.
367+32-368+91 RT.
APPROACH @ 365+91

LT.	RT.
0+00-0+44	0+00-0+24
0+79-1+05	0+58-1+13
1+21-2+32	1+43-2+00
3+02-3+79	2+45-3+37
	3+55-3+73

CONSTRUCT DRIVES

LT.	RT.
364+88.5 25	364+86.5 25
365+91 ✓	365+[illegible] 25
366+[illegible] 80	366+[illegible] PAVE
367+[illegible] 30	APPR. 0+49 PAVE
~~APPR. 0+[illegible] PAVE~~	APPR. 1+20
APPR. 1+[illegible] PAVE	APPR. 2+22.5
~~APPR. 2+62~~	APPR. 3+45
APPR. 3+53.00	APPR. 3+82
369+45	369+25

REMOVAL OF CONCRETE PAVEMENT
ITEM 103-B
364+00 - 368+91

COLORED SYNTHETIC BINDER CONCRETE
ITEM 374
364+00 - 367+36

VERTICAL GRANITE CURB, ITEM 559-B

LT.	RT.
364+17-365+24	364+24-365+50
366+09-366+58	365+95-366+91
366+[illegible]-366+[illegible]	367+32-368+90.3
APPR. 0+79-APPR. 1+05	APPR. 0+00-APPR. 0+28
APPR. 1+21-APPR. 2+32	APPR. 0+58-APPR. 1+13
APPR. 3+02-APPR. 3+79	APPR. 1+43-APPR. 2+00
APPR. 0+00-APPR. 0+44	APPR. 2+45-APPR. 3+37
	APPR. 3+55-APPR. 3+73

5" ONE COURSE CEMENT CONCRETE SIDEWALK, ITEM 560

LT.	RT.
3+[illegible]-3+24	364+29-365+45
364+22-365+89	364+70-364+21
366+14-366+48	365+95-366+34.45
366+61-366+[illegible]	366+[illegible]-366+[illegible]
363+68-363+[illegible]	367+32-368+90.9
APPR. 0+55-APPR. 0+39	APPR. 0+85-0+18
APPR. 0+85-APPR. 3+897	APPR. 0+27-0+27
APPR. 1+[illegible]-APPR. 2+[illegible]	

0+59 - 4+00 APPR. RT. RETAIN EXISTING SIDEWALK.

INSTALL OVERHEAD TRAFFIC SIGN SUPPORT, ITEM 703
STA. 367+39
FOR DETAILS REFER TO SHEETS NO. 67

STANDARD STEEL BEAM GUARD RAIL WITH STEEL POSTS, ITEM 545-A
367+16 — 367+95 LT.
367+05 — 367+47 RT.

8" ONE COURSE CEMENT CONCRETE SIDEWALK, ITEM 560

LT.	RT.
364+09-364+22	364+00-364+29
365+09-366+18	365+[illegible]-365+[illegible]
366+[illegible]-366+[illegible]	366+[illegible]-367+[illegible]
367+[illegible]-368+69	APPR. 0+19-APPR. 0+85
APPR. 0+39-APPR. 0+[illegible]	

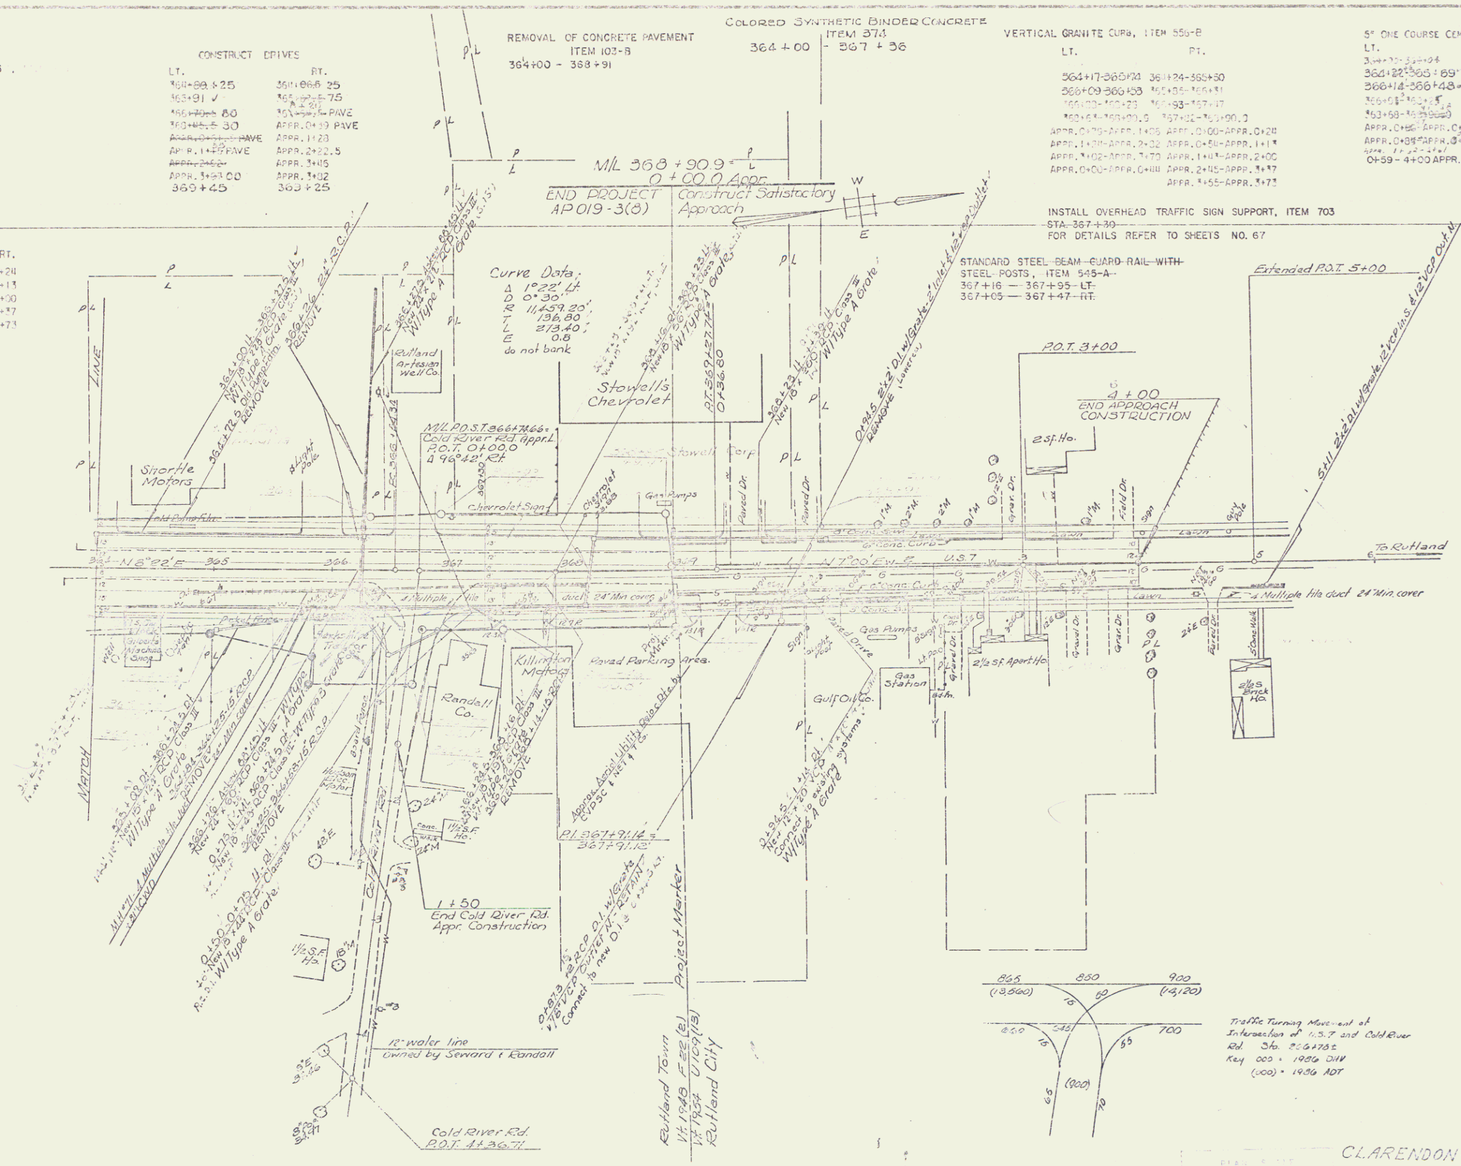

CLARENDON-RUTLAND
AP 019-3(8)

Sheet 38 of 44

30