SEEDING, ITEM 611
COMM. FERT. FOR GRASSES, ITEM 615
TOPSOIL, ITEM 621
*64+00-*64+29 LT.
*64+64-*65+** LT.
*65+68-*66+5* LT.
*66+82-*66+28 LT.
68+6-*69+31 LT.
*64+00-*64+59 RT.
64+9-*65+10 RT.
*65+35-*66+16 RT.
*66+37-*67+87 RT.
*67+32-*69+01 RT.
APPROACH @ *63+91

LT.	RT.
0+00-0+44	0+00-0+24
0+79-1+06	0+54-1+1*
1+24-2+82	1+42-2+00
+02-+79	2+45-*+*7
	+55-+7*

CONSTRUCT DRIVES

LT.	RT.
*64+46.5	*64+04.5
*65+50.5	*65+67.5
*66+70.5	*67+64.5
*68+85.5	APPR. 0+79
APPR. 0+61.5	APPR. 1+23
APPR. 1+15	APPR. 2+22.5
APPR. 2+92	APPR. *+45
APPR. *+87	APPR. *+02

GRANITE CURB, ITEM 556-B

LT.	RT.
*64+00-*64+29	*64+00-*64+53
*64+64-*65+**	*64+9*-*65+50
*65+70-*66+**	*66+35-*66+81
*66+82-*67+23	*66+97-*67+12
68+7-*69+23.0	*67+32-*69+90.9
APPR. 0+00-APPR. 1+02	APPR. 0+00-APPR. 0+20
APPR. 1+70-APPR. 2+32	APPR. 0+54-APPR. 1+1*
APPR. *+62-APPR. *+72	APPR. 1+18*-APPR. 2+00
APPR. 2+88-APPR. 3+48	APPR. 2+45-APPR. *+*7
	APPR. *+55-APPR. *+7*

5" ONE COURSE CEMENT CONCRETE SIDEWALK, ITEM 560

LT.	RT.
*64+00-*64+24	*64+00-*64+5*
*64+69-*65+43	*64+93-*65+45
65+7-*66+43	*65+20-*66+*1
66+9-*68+2*	*66+97-*67+42
*68+68-*68+90.9	*67+37-*68+90.9
APPR. 0+00-APPR. 0+*9	APPR. 0+00-0+19
APPR. 0+84-APPR. *+79	

3" ONE COURSE CEMENT CONCRETE SIDEWALK, ITEM 560

LT.	RT.
*64+28-*68+69	*64+5*-*64+92
*65+28-*66+7*	*65+45-*65+00
*66+48-*66+9*	*67+42-*67+37
68+2-*69+68	APPR. 0+19-APPR. 0+*9
APPR. 0+*9-APPR. 0+34	

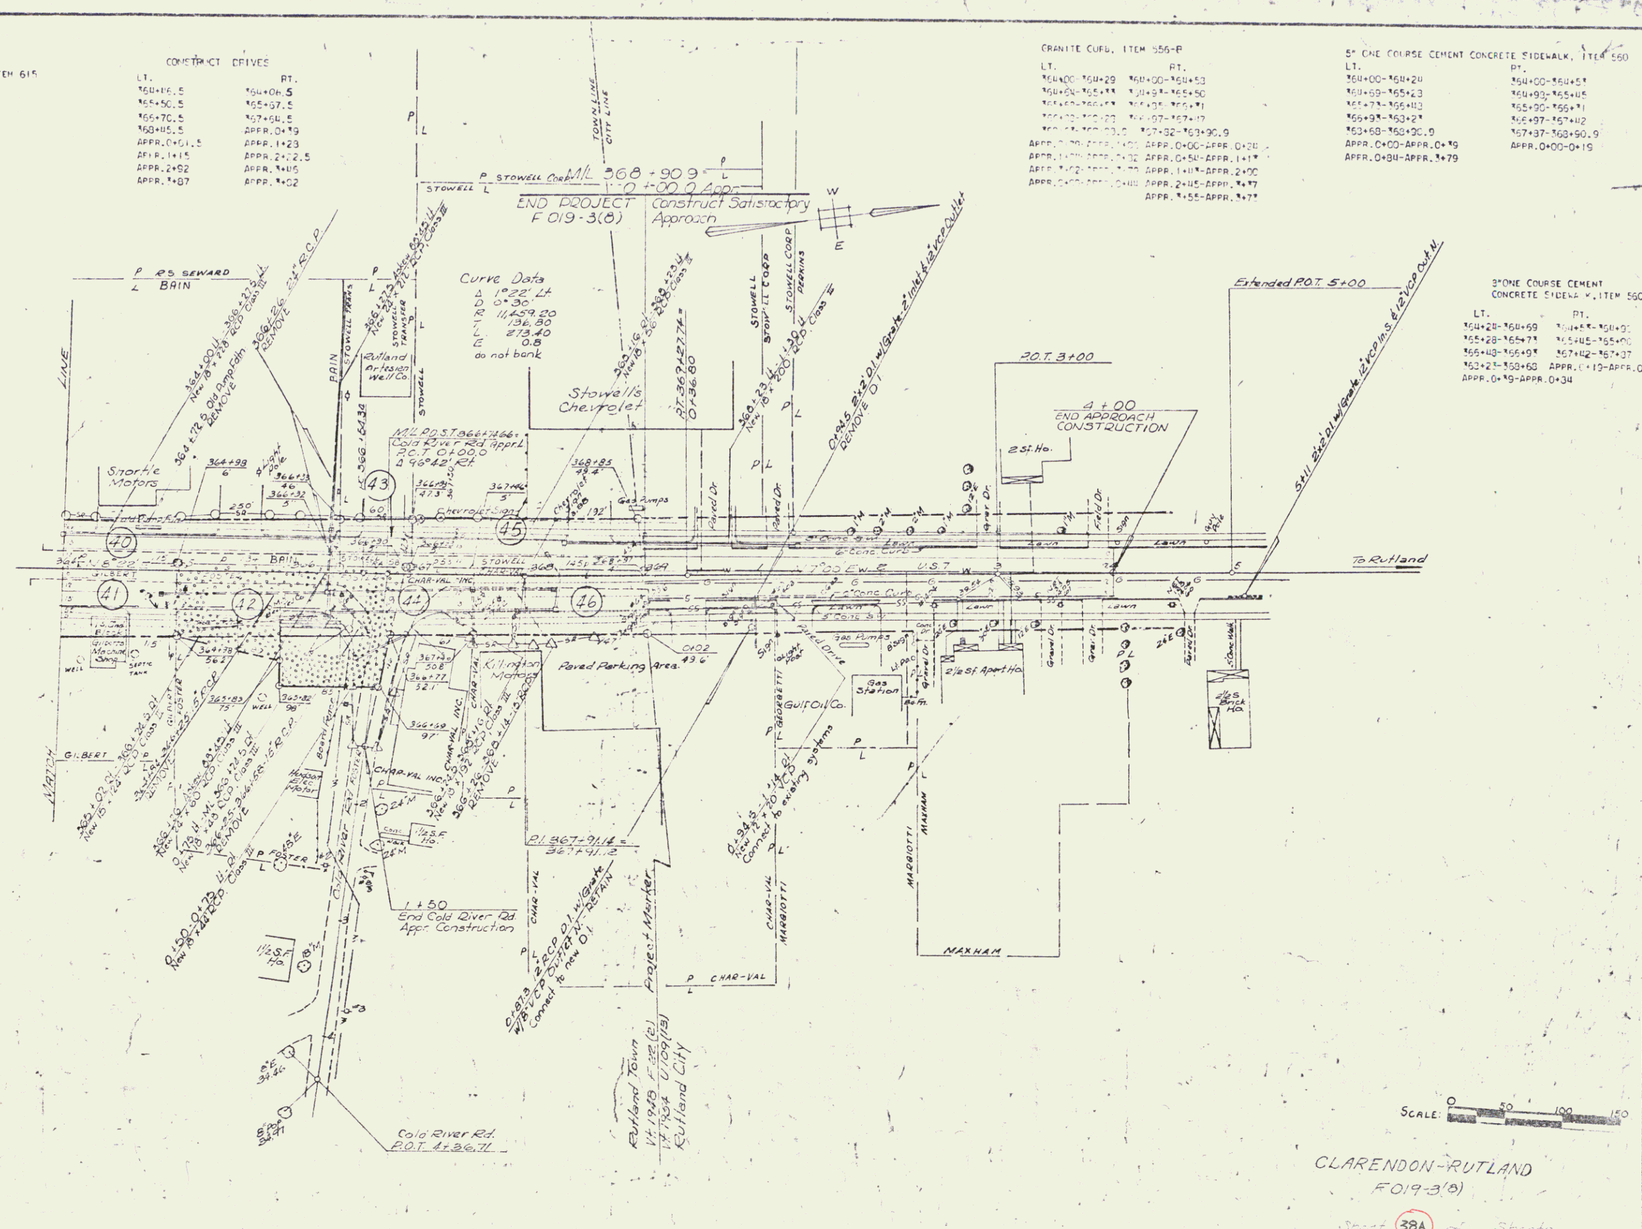

CLARENDON-RUTLAND
F 019-3(8)

Sheet 38A of Sheets